


PARTIAL LOWER LEVEL - EXISTING ELECTRICAL
 SCALE: 1/8" = 1' - 0"

Electrical Plan Review: Approved

- 1) Approval of these documents and drawings by an Electrical Plan Review or Inspection does not alleviate the applicant, contractor, or individuals from adherence to the 2017 National Electrical Code and local code requirements as they are adopted. Final approval will be based upon on-site electrical inspections to field verify compliance.
- 2) VFDs shall have a label attached to them denoting the overload setting, the date it was set, and the label shall meet the requirements of NEC 110.21 (B) (2) and (3).
- 3) NEC 210.63 - At least one 125-volt, single-phase 15 or 20 Ampere rated receptacle outlet shall be installed at an accessible location within 25 feet of the heating, air-conditioning and refrigeration equipment.

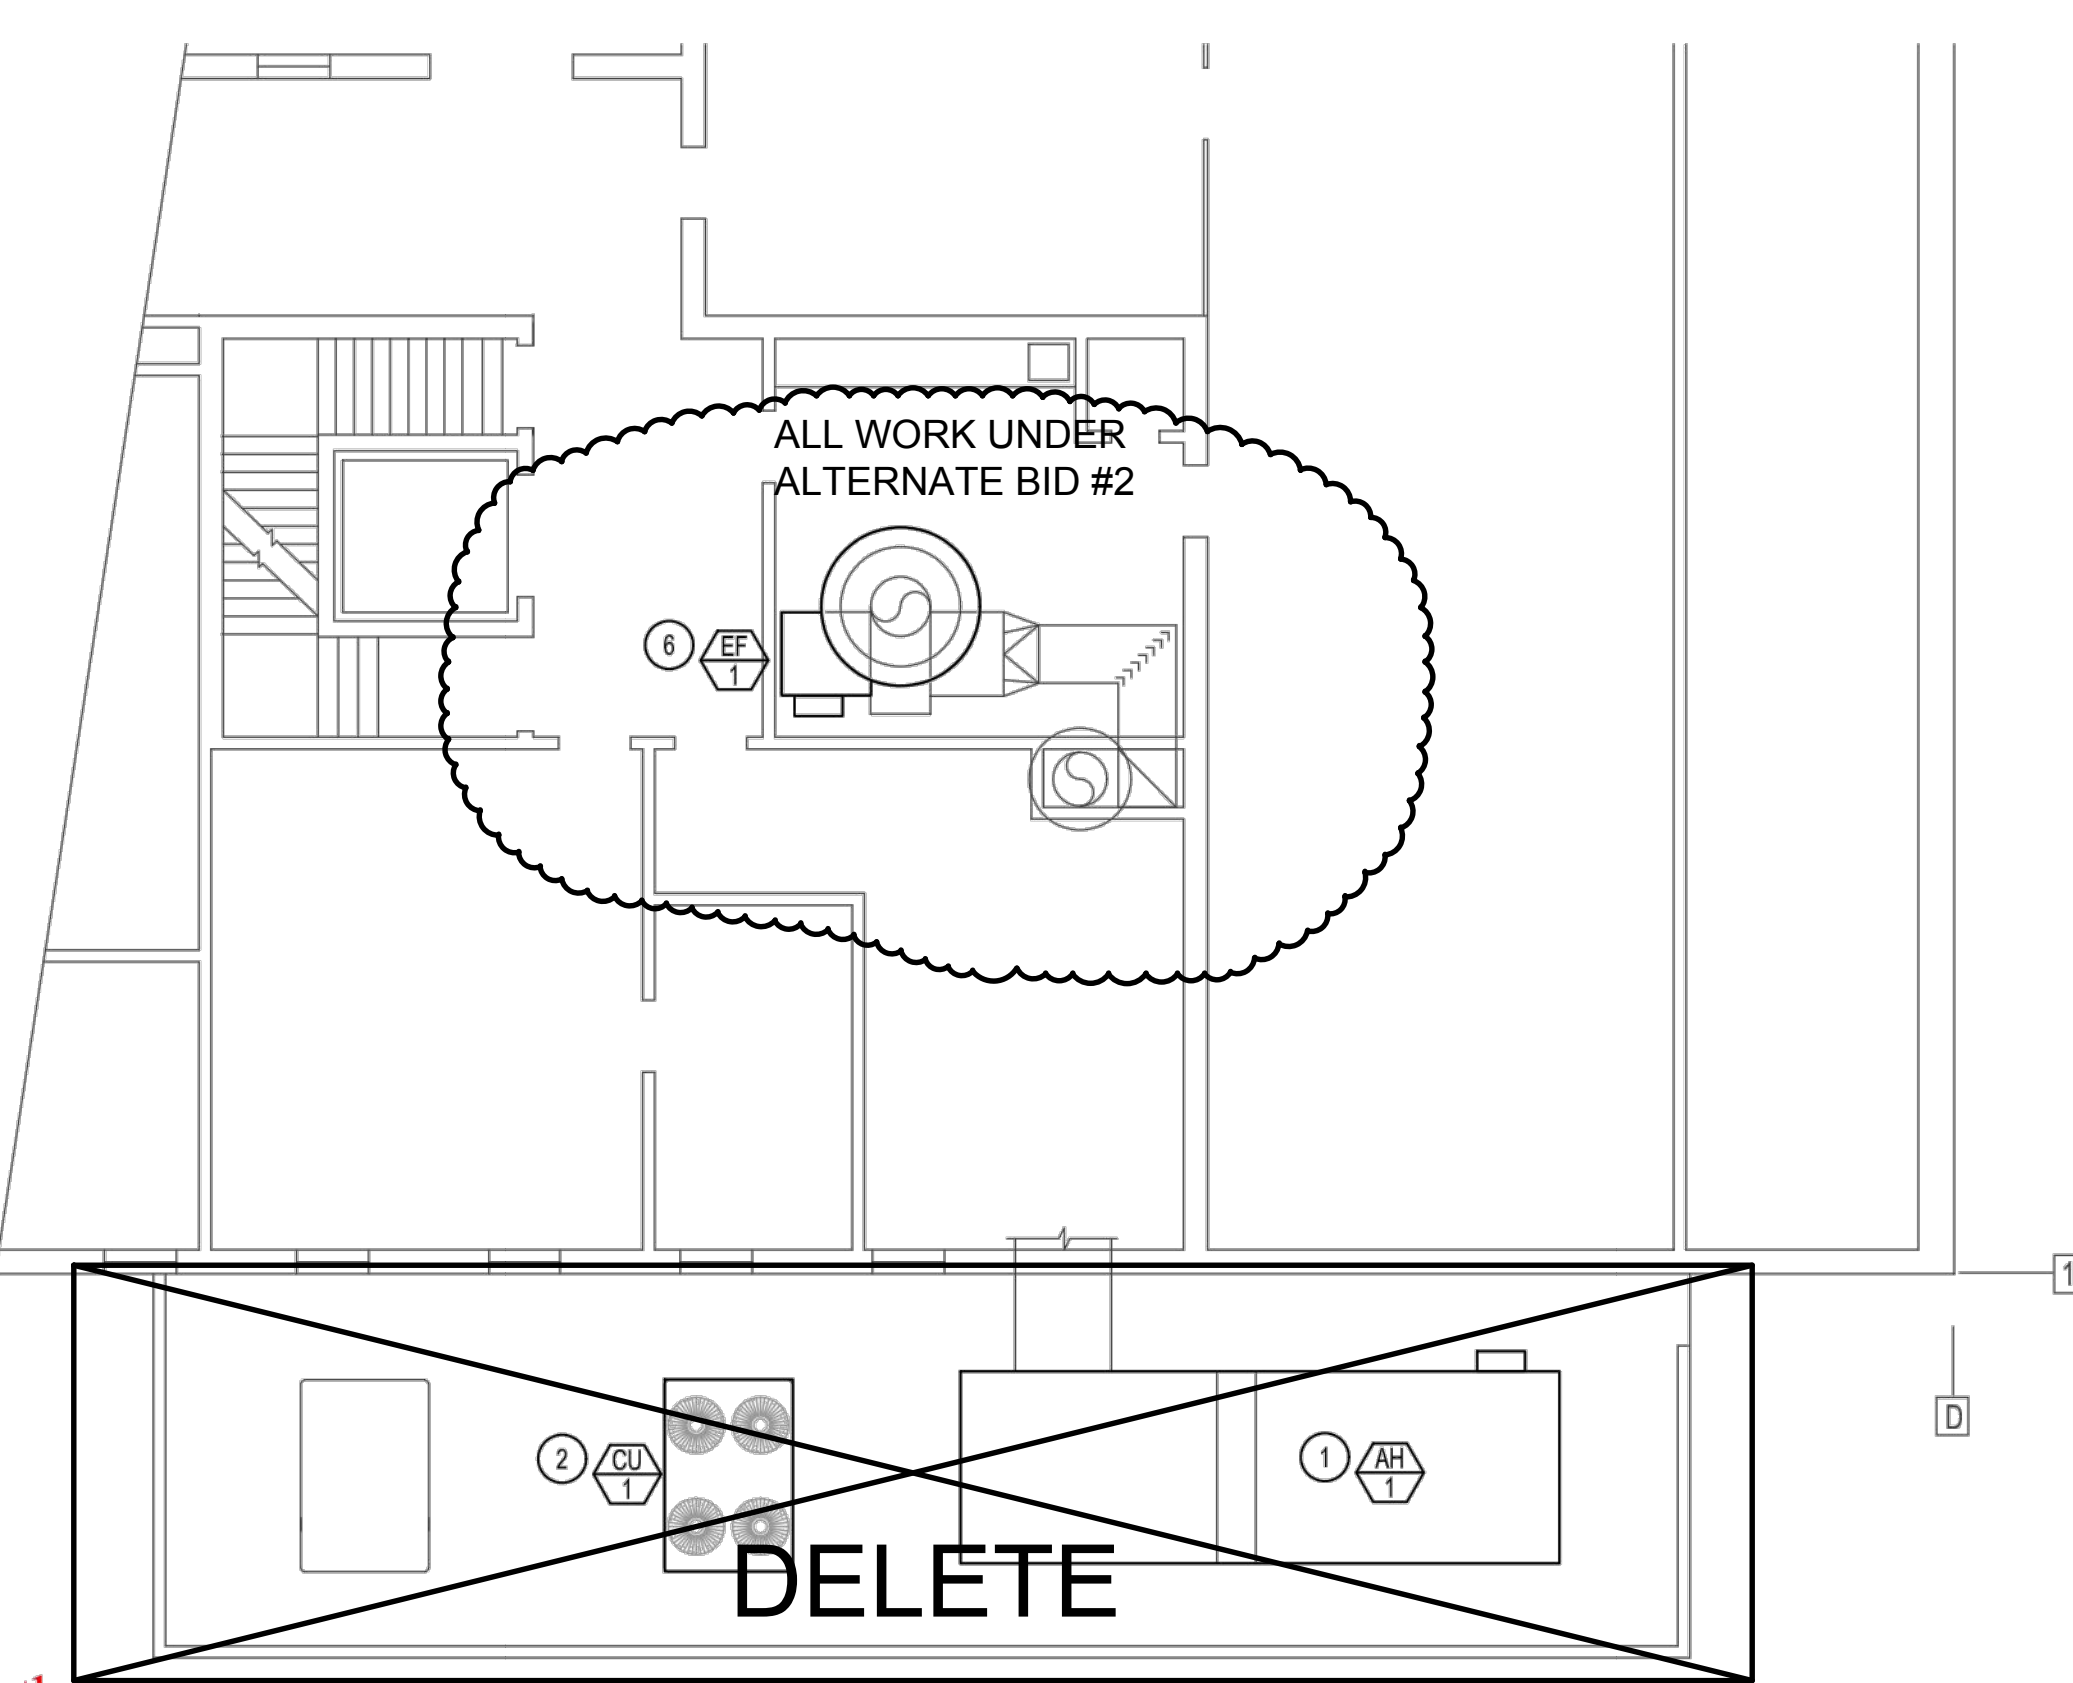


MAIN LEVEL - ELECTRICAL
 SCALE: 1/8" = 1' - 0"

KEY NOTES

- 1 CAREFULLY DISCONNECT EXISTING FEEDER TO AIR HANDLER FOR REMOVAL OF EXISTING 20HP MOTOR. REPLACE EXISTING FEEDER CONDUCTORS TO PANEL IN EXISTING CONDUIT. BID 200FT. TO PANEL. E.C SHALL FIELD VERIFY LENGTH PRIOR TO ORDERING, AND EXTEND TO NEW VFD, THEN INSTALL 1" C, 3-#6 + GROUND FROM VFD TO NEW MOTOR AND MAKE ALL REQUIRED CONNECTIONS.
- 2 DISCONNECT EXISTING FEEDER TO COND. UNIT FOR REMOVAL. PROVIDE AND INSTALL NEW DISCONNECT. REPLACE EXISTING FEEDER CONDUCTORS TO PANEL IN EXISTING CONDUIT. BID 200FT. TO PANEL. E.C SHALL FIELD VERIFY LENGTH PRIOR TO ORDERING, AND EXTEND TO NEW DISCONNECT AND THEN TO COND. UNIT. MAKE ALL REQUIRED CONNECTIONS. RESTORE CONTROL CONDUIT INTO NEW UNIT.
- 3 DISCONNECT EXISTING EX. FAN. REMOVE ALL ASSOCIATED ACCESSIBLE CONDUIT AND CONDUCTORS BACK TO SOURCE AND LABEL SPARE.
- 4 DISCONNECT EXISTING COND UNIT. REMOVE ALL ASSOCIATED ACCESSIBLE CONDUIT AND CONDUCTORS BACK TO SOURCE AND LABEL SPARE.
- 5 DISCONNECT EXISTING FAN COIL UNIT. REMOVE ALL ASSOCIATED ACCESSIBLE CONDUIT AND CONDUCTORS BACK TO SOURCE AND LABEL SPARE.
- 6 CAREFULLY DISCONNECT EXISTING EX. FAN FOR REMOVAL. REPLACE EXISTING FEEDER CONDUCTORS TO PANEL IN EXISTING CONDUIT. BID 200FT. TO PANEL. E.C SHALL FIELD VERIFY LENGTH PRIOR TO ORDERING, AND EXTEND TO NEW VFD, THEN INSTALL NEW FEEDER FROM VFD TO FAN. MAKE ALL REQUIRED CONNECTIONS FOR POWER AND CONTROLS.
- 7 DISCONNECT EXISTING DUCT HUMIDIFIER FOR REMOVAL. REPLACE EXISTING FEEDER AND EXTEND TO NEW DEHUMIDIFIER AND MAKE ALL REQUIRED CONNECTIONS.
- 8 DISCONNECT AND REMOVE EXISTING STARTER DISCONNECT. INSTALL NEW 3-#12 + GROUND FROM EXISTING PANEL TO TWO NEW VFDs. THEN INSTALL 3/4" C, 3-#12 + GROUND FROM EACH VFD TO RESPECTIVE CIRC. PUMP CP1 AND CP2.
- 9 REMOVE (2) 50A 2P AND (1) 40A 2P BREAKERS FROM EXISTING PANEL "SL2", FORMERLY USED FOR FAN COIL UNIT AND COND. UNIT. PROVIDE AND INSTALL (1) 100A 3P BREAKER FOR NEW AH2 AND (1) 30A 3P BREAKER FOR NEW COND. UNIT 2 EXISTING PANEL IS SQ-D NQOB.
- 10 PROVIDE AND INSTALL A 20A 1P BREAKER IN EXISTING PANEL "SB". PROVIDE AND INSTALL A 1/2" C, 2-#12 + GROUND TO NEW VOLUME BOXES AND MAKE ALL REQUIRED CONNECTIONS. SEE MECH. FOR LOCATIONS. EXISTING PANEL IS SQ-D NQOB.
- 11 3/4" CONDUIT FOR CONTROL CABLE TO INDOOR UNIT.
- 12 PROVIDE AND INSTALL (2) 20A 1P BREAKERS FOR NEW VOLUME BOXES. MAKE ALL REQUIRED CONNECTIONS.
- 13 PROVIDE AND INSTALL NEW LOCAL DISCONNECT FOR AH2 AND CU1.

MECHANICAL EQUIPMENT SCHEDULE						
SYMBOL	DESCRIPTION	MCA	VOLTS	Ø	H.P.	CIRCUIT / FEEDER
AH 1	AIR HANDLER	-	480	3	25	SEE PLAN / SEE PLAN
AH 2	AIR HANDLER	77	208	3	5	PANEL "SL2" / 1 1/2" C, 4-#2 + GROUND
CP 1	CIRC. PUMP	-	208	3	3	EXISTING / 3/4" C, 3-#12 + GROUND
CU 1	COND. UNIT	87	480	3	-	EXISTING / 1 1/2" C, 4-#2 + GROUND
CU 2	COND. UNIT	22.6	208	3	-	PANEL "SL2" / 3/4" C, 3-#10 + GROUND
EF 1	EXHAUST FAN	-	208	3	20	EXISTING / 1 1/2" C, 4-#2 + GROUND

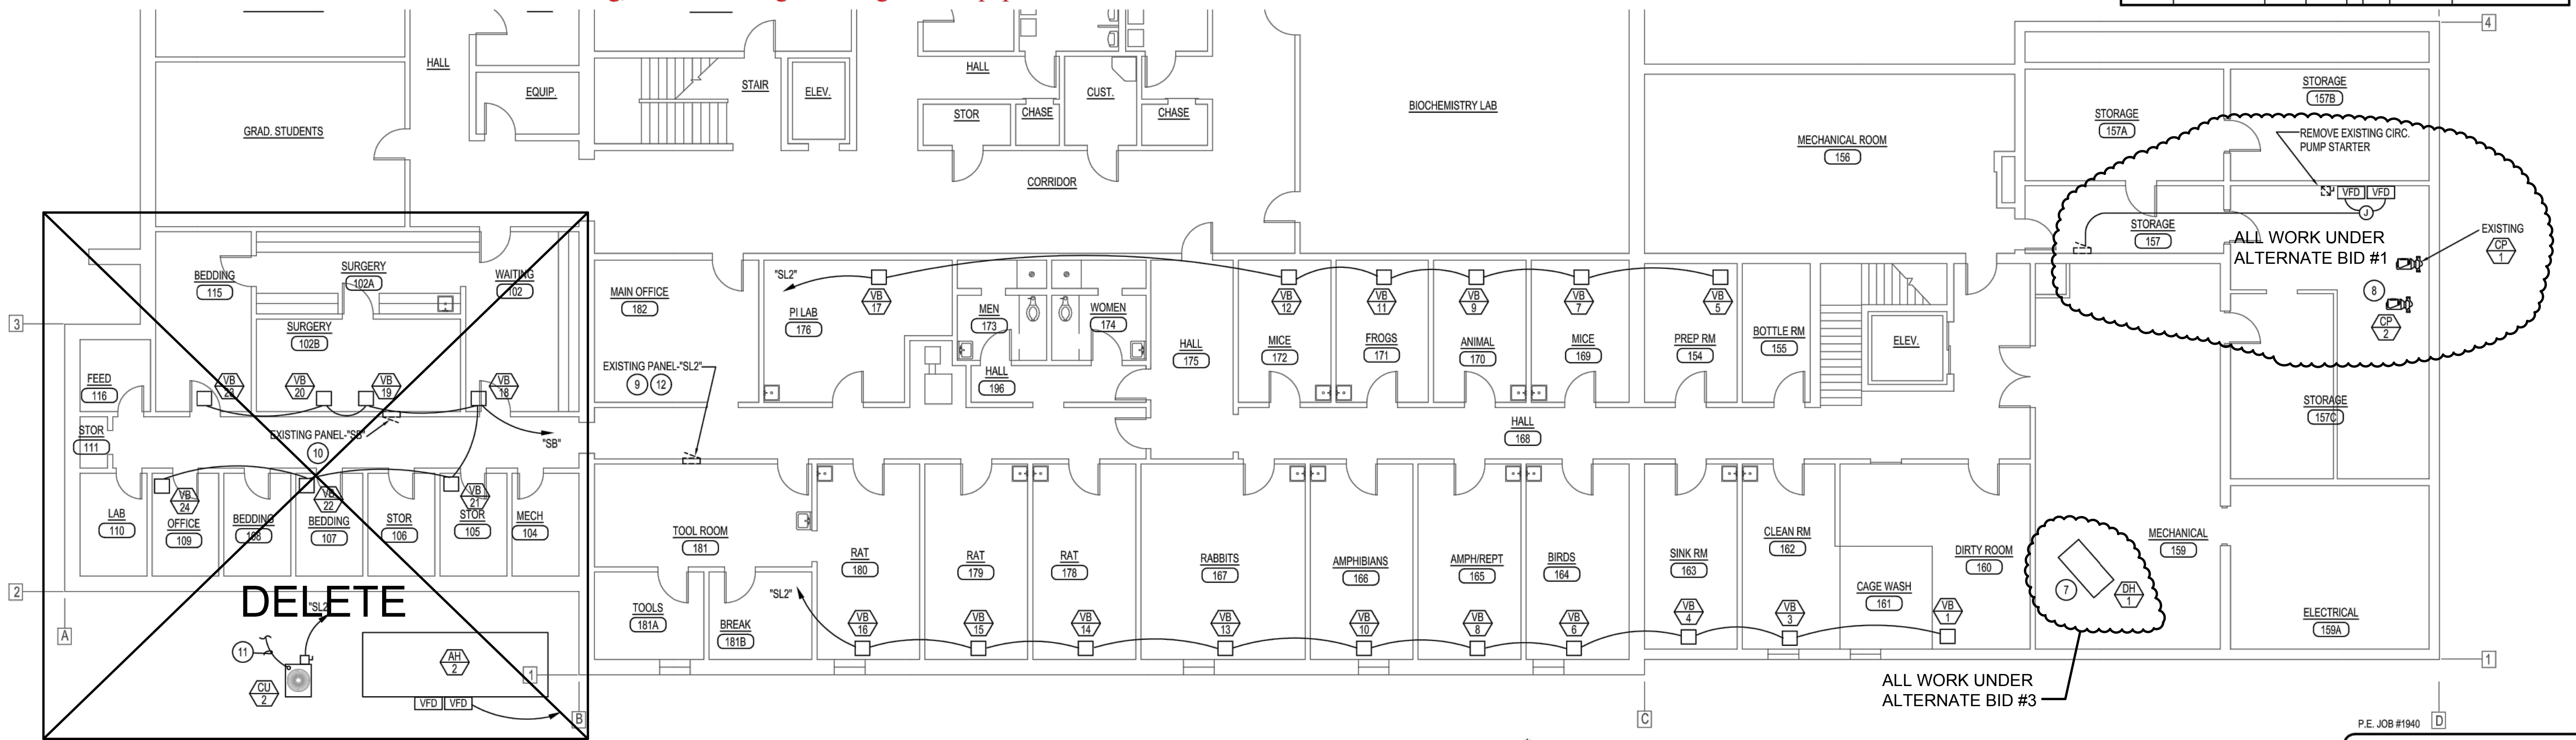

LOWER LEVEL - ELECTRICAL
 SCALE: 1/8" = 1' - 0"



**Engineered Systems Associates
 Mechanical Engineers**
 Dwayne Sudweeks
 1355 East Center - Pocatello, Idaho 83201
 Phone: (208) 233-0501 Fax: (208) 233-0529 email: esa@engsystems.com

HVAC UPGRADE FOR: DPW PROJECT # 19743
ISU LIFE SCIENCE BUILDING
 ANIMAL CARE FACILITY
 POCATELLO, IDAHO
 PROJECT: _____
 SHEET TITLE: ELECTRICAL PLANS



DRWN. BY:	CHK. BY:
MMP	TEP
JOB NO.	DATE:
19013	JUNE 2019

SHEET: **E-1.1**
 OF:

ORIGINAL SIGNED BY:
 TODD E. PAYNE
 DATED ORIGINAL SIGNED:
 8-26-2019
 ON FILE AT:
 PAYNE ENGINEERING INC.

IPAYNE
 Engineering Inc.
 Consulting Engineers
 1823 E. Center
 Pocatello, Idaho 83201
 tel (208) 232-4439
 www.payneengineeringinc.com