laughlin ricks architecture

134 3rd Ave E Twin Falls, ID 83301 208.736.8050

Addendum NO. 3

PROJECT: A New Hotel For: Terra Development LLC

Date: June 16, 2022

To the General Contractor, Subcontractors and Suppliers:

The following items contain additions, deletions, or modifications to the Plans and Specifications. This Addendum forms a part of the Contract Documents and shall be bound inside the cover of the Project Manual.

General Contractor shall be responsible for contacting their sub-contractors as this addendum may affect them.

Bidders shall acknowledge receipt of this Addendum on the Contractor Bid Proposal.

GENERAL NOTES:

- 1. The wood base in the guest rooms shall be 1 x 6 MDF painted.
- 2. Each window/door opening will need a header, trimmer, and king studs per the schedule on S005. Size of header/trimmers/kings is based on opening width. The wood floor framing notes on S102 is where these headers are called out and refers to the schedule.
- 3. Shower curtains are OFOI.
- 4. At swimming pool aluminum storefront windows, tile shall wrap / case the jamb to the height indicated on the interior elevations. Epoxy paint the jamb above the tile and the head. Tile shall be provided at the sill, sloped to drain. Tile shall wrap / case the aluminum storefront door systems.
- 5. Wood base in the guestrooms shall be 1x6 MDF painted. At room finish schedule all wood base at guestrooms shall be changed to 1x6 MDF painted.

SPECIFICATIONS MANUAL:

SECTION 081000 METAL DOORS, DOOR AND WINDOW FRAMES

2.3 Frames, A. Interior Frames ADD 3. As follows;

"3. Approved: Timely Prefinished Steel Door Frames, C-Series (18 gauge)."

DELETE SECTION 081429 FLUSH WOOD DOORS in it's entirety.

ADD SECTION 081423 PAINT GRADE STILE & RAIL WOOD DOORS in it's entirety.

SECTION 085313 VINYL WINDOWS

2.05 A., 1., a. REVISE as follows:

2.05 GLAZING

Laughlin Ricks Architecture, LLC



- A. Insulated Glass Units: ASTM E 774, Class A
 - 1. Glazing Type: Dual
 - a. 1/8" SunCoatMAX® Low-E/solarbronze over 1/8" Clear

SECTION 088100 GLASS GLAZING

SECTION 2.1 MATERIALS ADD

E. fire-rated glass shall be Fire Lite Plus

ARCHITECTURAL DRAWINGS

REVISE Sheet A2-6 per attached.

REVISE Sheet A4-1 per attached.

REVISE Sheet A9-0 per attached.

REVISE Sheet A9-1 per attached.

REVISE Sheet A9-2 per attached.

REVISE Sheet A9-3 per Attached.

REVISE Sheet A9-4 per Attached.

REVISE Sheet A9-5 per Attached.

REVISE Sheet A9-10 per Attached.

Sheet A10-2 delete drainage mat from details. All WRB shall be 1 layer Type D building paper.

Sheet A10-4 delete drainage mat from details. All WRB shall be 1 layer Type D building paper.

REVISE Sheet A10-8 per Attached.

PLUMBING DRAWINGS

REVISE Sheet P1-0 per attached: Add waste piping for mop sinks on Levels 2, 3 and 4. Add waste piping for floor sink in Pump Room 1.19P. Add waste piping for Pool Area Drains.

REVISE Sheet P1-1 per attached: Add waste piping for mop sinks on Levels 2, 3 and 4. Add waste and vent piping for floor sink in Pump Room 1.19P. Add pool area drains and vent piping. Add plan notes.

REVISE Sheet P1-2 per attached: Add waste piping for mop sinks on Levels 2, 3 and 4. Add waste and vent piping for floor sink in Pump Room 1.19P. Add pool area waste and vent piping. Add plan notes.

REVISE Sheet P1-2 per attached: Add mop sink in Carts / Stg 2.1 room with associated piping. Pipe size chart revision. Add plan notes.

REVISE Sheet P1-3 per attached: Add mop sink in Carts / Stg 3.1 room with associated piping. Pipe size chart revision. Add and modify plan notes. Add Mech. Room 3.7 Water Slide Piping Plan.

REVISE Sheet P1-4 per attached: Add mop sink in Carts / Stg 4.1 room with associated piping. Pipe size chart revision.

REVISE Sheet P1-5 per attached: Add 2" VTR serving mop sinks on Levels 2, 3 and 4.

REVISE Sheet P3-1 per attached: Add mop sink MS-1 and Pool Area Drain PD-1 to Fixture Schedule.

MECHANICAL DRAWINGS

REVISE Sheet M1-1 per attached: Ductwork and return grille revisions for new Pump Room 1.19P addition.

REVISE Sheet M1-2 per attached: Ductwork revisions for structural coordination.

REVISE Sheet M1-3 per attached: Ductwork revisions for structural coordination.

REVISE Sheet M1-4 per attached: Ductwork exposed in room and no longer in chase or soffit. Add plan note 6.

REVISE Sheet M1-5 per attached: Add 2" VTR serving mop sinks on Levels 2, 3 and 4.

laughlin ricks architecture

ELECTRICAL DRAWINGS

REVISE Sheet E1.0

REVISE Sheet E2.2

REVISE Sheet E5.0

REVISE Sheet E5.1

REVISE Sheet E5.2

REVISE Sheet E5.3

STRUCTURAL DRAWINGS

REVISE Sheet S001

APPROVED SUBSTITUTION REQUESTS

- 081000 Interior Door Frames: Timely Prefinished Steel Door Frames, C-Series (18 gauge)
- 2. 22 3600 WATER SOFTENERS: Eco Water Systems / North Star Water Treatment Systems
- 3. Lighting & Controls:
 - 1. The following lighting are Pre-approved from the following:
 - a) (Hubbell) The MH Companies Boise, ID
 - b) (Cooper) Idaho Lighting Solutions Boise, ID

Summary of Attachments to Addendum No. 3

(Bidders check to verify receipt of all attachments.)

SPECIFICATIONS

Section 081423 PAINT GRADE STILE & RAIL WOOD DOORS

ARCHITECTURAL DRAWINGS

Sheets A2-6, A4-1, A9-0, A9-1, A9-2, A9-3, A9-4, A9-5, A9-10, A10-8

PLUMBING DRAWINGS

Sheets P1-0, P1-1, P1-2, P1-3, P1-4, P1-5, P3-1

MECHANICAL DRAWINGS

Sheets M1-1, M1-2, M1-3, M1-4, M1-5

ELECTRICAL DRAWINGS

Sheets E1.0, E2.2, E5.0, E5.1, E5.2, E5.3

STRUCTURAL DRAWINGS

Sheet S001

END OF ADDENDUM No. 3

SECTION 08 14 23

PAINT GRADE STILE AND RAIL WOOD DOORS

PART 1 GENERAL

1.1 SECTION INCLUDES

A. Interior Paint Grade Stile and Rail Wood Doors

1.2 REFERENCES

- A. NFPA 80 Standard for Fire Doors and Other Opening Protectives.
- B. Window and Door Manufacturers Association I.S.6-A-13 Industry Standards for Architectural Stile and Rail Doors

1.3 SUBMITTALS

- A. Product Data: For each type of product
 - 1. Include detailed specification of construction.
 - 2. Include factory-finishing specifications.
- B. Shop Drawings: For stile and rail doors. Indicate size; elevation of each kind of door; location; hand of each door; construction details not covered in Product Data, including those for stiles, rails, panels, sticking, and moldings; and other pertinent data.
 - 1. Dimensions of doors for after-factory pre-fitting.
 - 2. Requirements/Templates for door hardware machining.
 - 3. Doors to be factory finished and finish requirements.
 - 4. Fire-protection ratings for fire-rated doors.
- C. Samples for Initial Selection: For factory-finished doors.
- D. Samples for Verification
 - 1. Finish color samples of factory-finished doors, minimum size of 8.5 x 11 inches, for each color.
 - 2. Corner section of doors, minimum size of 12 by 12 inches, with panel, and sticking profile required.

1.4 INFORMATION SUBMITTALS

A. Sample Warranty: For standard warranty.

1.5 QUALITY ASSURANCE

- A. Manufacturer Qualifications: Company specializing in manufacturing products specified in this section with minimum 10 years of documented experience.
 - 1. Qualified manufacturer that is certified for chain of custody by an FSC-accredited certification body.
- B. Manufacturer Qualifications: Fire-rated doors listed and labeled by approved agency.

1.6 REGULATORY REQUIREMENTS

- A. Conform to applicable Building Code for fire rated assemblies
 - 1. Fire rated assembly construction to conform to UL 10C, unless otherwise required by applicable Building Code.
 - 2. Installed Frame and Door Assemblies: Comply with NFPA 80 for fire rated class indicated.
 - 3. Installed Smoke Control Frame and Door Assemblies: Comply with NFPA 105.

1.7 DELIVERY, STORAGE AND HANDLING

- A. Delivery:
 - 1. Deliver doors to site in manufacturer's original, unopened containers and packaging, with labels clearly identifying product name and manufacturer.
- B. Storage: Doors shall be stored and handled in accordance with the manufacturer's recommendations and the WDMA Appendix Section "Care and Installation at Job Site".
 - 1. Doors shall be stored on a flat and level surface in a well-ventilated dry building. Doors shall not be stored on edge and shall be protected from dirt, water and abuse.
 - 2. Doors shall not be subjected to extreme heat or humidity. HVAC systems should be set to provide a temperature range of 50-90 degrees F and 25-55% relative humidity.
 - 3. Seal top and bottom edges if stored more than one week. Break seal on packaging, if bagged, on the site to permit ventilation.

C. Handling:

- 1. Handle doors in accordance with manufacturer's instructions.
- 2. Protect doors and finish during handling and installation to prevent damage.
- 3. Handle doors with clean hands or clean gloves.
- 4. Lift and carry doors. Do not drag doors across other doors or surfaces.
- 5. Do not 'walk' a door on its corners.
- 6. Doors require light sanding before being painted.

1.8 FIELD CONDITIONS

A. Environmental Limitations: Do not deliver or install doors until spaces are enclosed and weathertight, wet work in spaces is complete and dry, and HVAC system is operating and maintaining temperature between 50 and 90 deg F and relative humidity between 25 and 55 percent during remainder of construction period.

1.8 WARRANTY

- A. Standard Warranty: Manufacturer agrees to repair or replace doors that fail in materials or workmanship, or have warped (bow, cup, or twist) more than 1/4 inch in a 42 by 84-inch door section, within specified warranty period.
 - 1. Warranty shall be in effect during the following period of time from substantial completion:

a. Interior doors: Five Years

b. Glass Vision Panels: Five Years

PART 2 - PRODUCTS

2.1 MANUFACTURER

A. VT Industries, Inc., Phone (712-368-4381). www.vtindustries.com. door_info@vtindustries.com.

Design Standard: Supa Collection, SS500, 40 STC, color as selected.

- 1. Approved manufacturers.
 - a. Simpson
 - b. Lynden Door
 - c. TruStile
- B. Source Limitations: Obtain interior paint grade doors from single manufacturer offering Stile and Rail doors that meet performance duty level standards identified in either WDMA or AWI industry standards. All doors must be sourced from one single manufacturer with at least 10 years' experience constructing stile and rail doors. Routed doors are not acceptable.

2.2 MATERIALS

- A. General: Use only materials that comply with referenced standards and other requirements specified.
 - 1. Assemble interior doors, including components, with Type II adhesive.
- B. Certified Wood: Paint grade doors shall be certified as "FSC Percentage or Mix Credit" according to FSC STD-01-001 and FSC STD-40-004.
- C. Composite Wood Products: Products shall be made using ultra-low-emitting formaldehyde resins as defined in the California Air Resources Board's "Airborne Toxic Control Measure to Reduce Formaldehyde Emissions from Composite Wood Products" or shall be made with no added formaldehyde.
- D. Panel Products:
 - 2. Medium-density fiberboard (MDF), complying with ANSI A208.2, Grade 155.
- E. Safety Glass: Provide products complying with testing requirements in 16 CFR 1201, for Category II materials, unless those of Category I are expressly indicated and permitted.

1. Glass types per 088000.

2.3 INTERIOR NON-RATED STILE AND RAIL DOORS

- A. Paint grade stile and rail doors complying with [WDMA I.S.6A-13] [AWS latest edition] industry standard for wood stile and rail doors and with other requirements specified. All Fire doors must match non-rated doors.
 - 1. Panel Designs: **Raised**. Do not modify intended aesthetic effects, as judged solely by Architect, except with Architect's approval. If modifications are proposed, submit comprehensive explanatory data to Architect for review.
 - 2. Grade: Custom
 - 3. Finish: Opaque.
 - 4. Material: Align with industry standards and specified Performance Duty Levels
 - 5. Door Construction for Opaque Finish: Constructed to meet or exceed Performance Duty Levels outlined in industry standards
 - 6. Stile and Rail Widths: Manufacturer's standard, but not less than the following:
 - a. 1-3/4" Door
 - 1) Stiles: [6 inches] < Insert dimension>.
 - 2) Top Rail: [6 inches] <Insert dimension>.
 - 3) Intermediate Rails and Mullions: [6 inches] < Insert dimension>.
 - 4) Lock Rails: [6 inches] < Insert dimension>.
 - 5) Bottom Rails: [10 inches] < Insert dimension>.
 - 7. Raised-Panel Thickness:
 - a. 1-3/4-Inch Doors: Not less than 1-1/8 inches.
 - 8. Sticking Profile: Manufacturer's standard as selected by Architect from manufacturer's full range.
 - 9. Glass: clear, fully tempered float glass, 1/4 inch thick, complying with Section 088100 "Glass Glazing."

2.4 INTERIOR FIRE-RATED, STILE AND RAIL PAINT GRADE DOORS

- A. Interior Fire-Rated Paint Grade Doors: Doors complying with NFPA 80 that are listed and labeled by a qualified testing agency, for fire-protection ratings indicated, based on testing at the following.
- B. Interior Fire-Rated Paint Grade Stile and Rail Doors: Interior fire-rated (20/45/60/90-minute) doors complying with [WDMA I.S.6] [AWS's latest edition] industry standard for stile and rail doors and with other requirements specified.
 - 1. Panel Designs: **Raised.** Do not modify intended aesthetic effects, as judged solely by Architect, except with Architect's approval. If modifications are proposed, submit comprehensive explanatory data to Architect for review.

- 2. Finish: Opaque.
- Door Construction for Opaque Finish to meet performance duty levels outlined in industry standards
- Edge Construction: At outer vertical stile edges, provide solid-wood edge construction. Wood-veneer edges not acceptable. Comply with specified requirements for exposed edges.
 - a. Positive pressure Category A edge construction with intumescent seals concealed by outer stile solid-wood edge cap. Wood-veneer edges not acceptable.
- 5. Stile and Rail Widths: Manufacturer's standard, but not less than the following:
 - a. Stiles: 4.5 inches
 - b. Top Rail: 4.5 inches
 - c. Intermediate Rails and Mullions: 3.5 inches
 - d. Lock Rails: 4.5 inchese. Bottom Rails: 8 inches
- 6. Raised-Panel Thickness:
 - a. 1-3/4-Inch Doors: Not less than 1-1/4 inches.
- 7. Sticking Profile: Manufacturer's standard as selected by Architect from manufacturer's full range.
- 8. Glass: Fire Lite Plus, complying with Section 088100 "Glass Glazing."

2.5 JAMBS

A. Jambs: Per door schedule and specification 081000

2.6 STILE AND RAIL WOOD DOOR FABRICATION

- A. Factory fit doors to suit frame-opening sizes indicated, with the following uniform clearances and bevels unless otherwise indicated:
 - 1. Clearances: Provide 1/8 inch at heads, jambs, and between pairs of doors. Provide [7/8 inch] from bottom of door to top of decorative floor finish or covering. Where threshold is shown or scheduled, provide not more than [¾" inch] from bottom of door to top of threshold.
 - a. Comply with NFPA 80 for fire-rated doors.
 - 2. Non-Fire-Rated Swing Doors: Bevel 3 degrees at lock and hinge edges.
 - 3. Non-Fire-Rated Sliding Doors to have square edges.
 - 4. Fire-Rated Doors: Bevel 3 degrees at lock and hinge edges; trim stiles and rails only to extent permitted by labeling agency.
 - a. Fire-rated doors must be factory pre-fit and beveled.
 - No site modifications permitted without prior written authorization by manufacturer or labeling agency.

- 5. Smoke and Draft Control Doors: In addition to required fire rating, provide stile and rail door assemblies in compliance with WDMA I.S.6A requirements for "S" label; if necessary, provide additional gasketing or edge sealing.
- B. Factory machine doors for hardware that is not surface applied. Locate hardware to comply with DHI-WDHS-3. Comply with final hardware schedules, door frame Shop Drawings, BHMA-156.115-W, and hardware templates.
 - 1. Coordinate measurements of hardware mortises in metal frames to verify dimensions and alignment before factory machining.
 - 2. Fire-rated doors must be factory machined for door hardware.
 - a. No site modifications permitted without prior written authorization by manufacturer or labeling agency.
- C. Glazed Openings: Trim openings indicated for glazing moldings, with one side removable. Mitered moldings at corner joints.
- D. Glazed Openings: Factory install glazing in doors, Install glass using manufacturer's standard elastomeric glazing sealant complying with ASTM C 920. Secure glass in place with removable moldings. Miter moldings at corner joints.
- E. Transom and Side Panels: Fabricate panels to match adjoining doors in materials, finish, and quality of construction.

2.7 FACTORY FINISHING

- A. Doors for Factory Finish of Interior Doors for Opaque Finish: Per WDMA I.S.6A, and with other requirements specified.
 - Finish faces and all four edges of doors. Fillers may be omitted edges of cutouts, and mortises
 - 2. Finish: WDMA approved finishing system
 - 3. Paint: As selected by Architect
 - 4. Sheen: Satin
- B. Factory finish doors in accordance with approved sample.

PART 3 - EXECUTION

3.1 EXAMINATION

- A. Examine doors and installed door frames, with Installer present, before hanging doors.
 - 1. Verify that installed frames comply with indicated requirements for type, size, location, and swing characteristics and have been installed with level heads and plumb jambs.
 - 2. Reject doors with defects.
- B. Proceed with installation only after unsatisfactory conditions have been corrected.


3.2 INSTALLATION

- A. Hardware: For installation, see Section 087100 Door Hardware.
- B. Installation Instructions: Install doors to comply with manufacturer's written instructions and referenced quality standard, and as indicated.
 - 1. Install fire-rated doors in accordance with NFPA 80, Intertek/Warnock Hersey (WHI), and UL requirements as applicable.
 - 2. Install smoke and draft control doors in accordance with NFPA 105 requirements.
- C. Factory-Fitted Doors: Align and fit doors in frames with uniform clearances and bevels as indicated below; do not trim stiles and rails in excess of limits set by manufacturer or permitted with fire-rated doors. Machine doors for hardware. Seal edges of doors, edges of cutouts, and mortises after fitting and machining.
 - Clearances: Provide 1/8 inch at heads, jambs, and between pairs of doors. Provide [7/8 inch] from bottom of door to top of decorative floor finish or covering unless otherwise indicated. Where threshold is shown or scheduled, provide [1/4 inch (6 mm)] [³/₄" inch (10 mm)] from bottom of door to top of threshold unless otherwise indicated.
 - a. Comply with NFPA 80 for fire-rated doors.
 - b. No site modifications permitted without prior written authorization by manufacturer or labeling agency; undercutting doors and machining for surface hardware is acceptable but limited.
- D. **Factory**-Finished Doors: Restore finish before installation if fitting or machining is required at Project site.

3.3 ADJUSTING

- A. Operation: Rehang or replace doors that do not swing or operate freely.
- B. Finished Doors: Replace doors that are damaged or do not comply with requirements. Doors may be repaired or refinished if Work complies with requirements and shows no evidence of repair or refinishing.

END OF SECTION

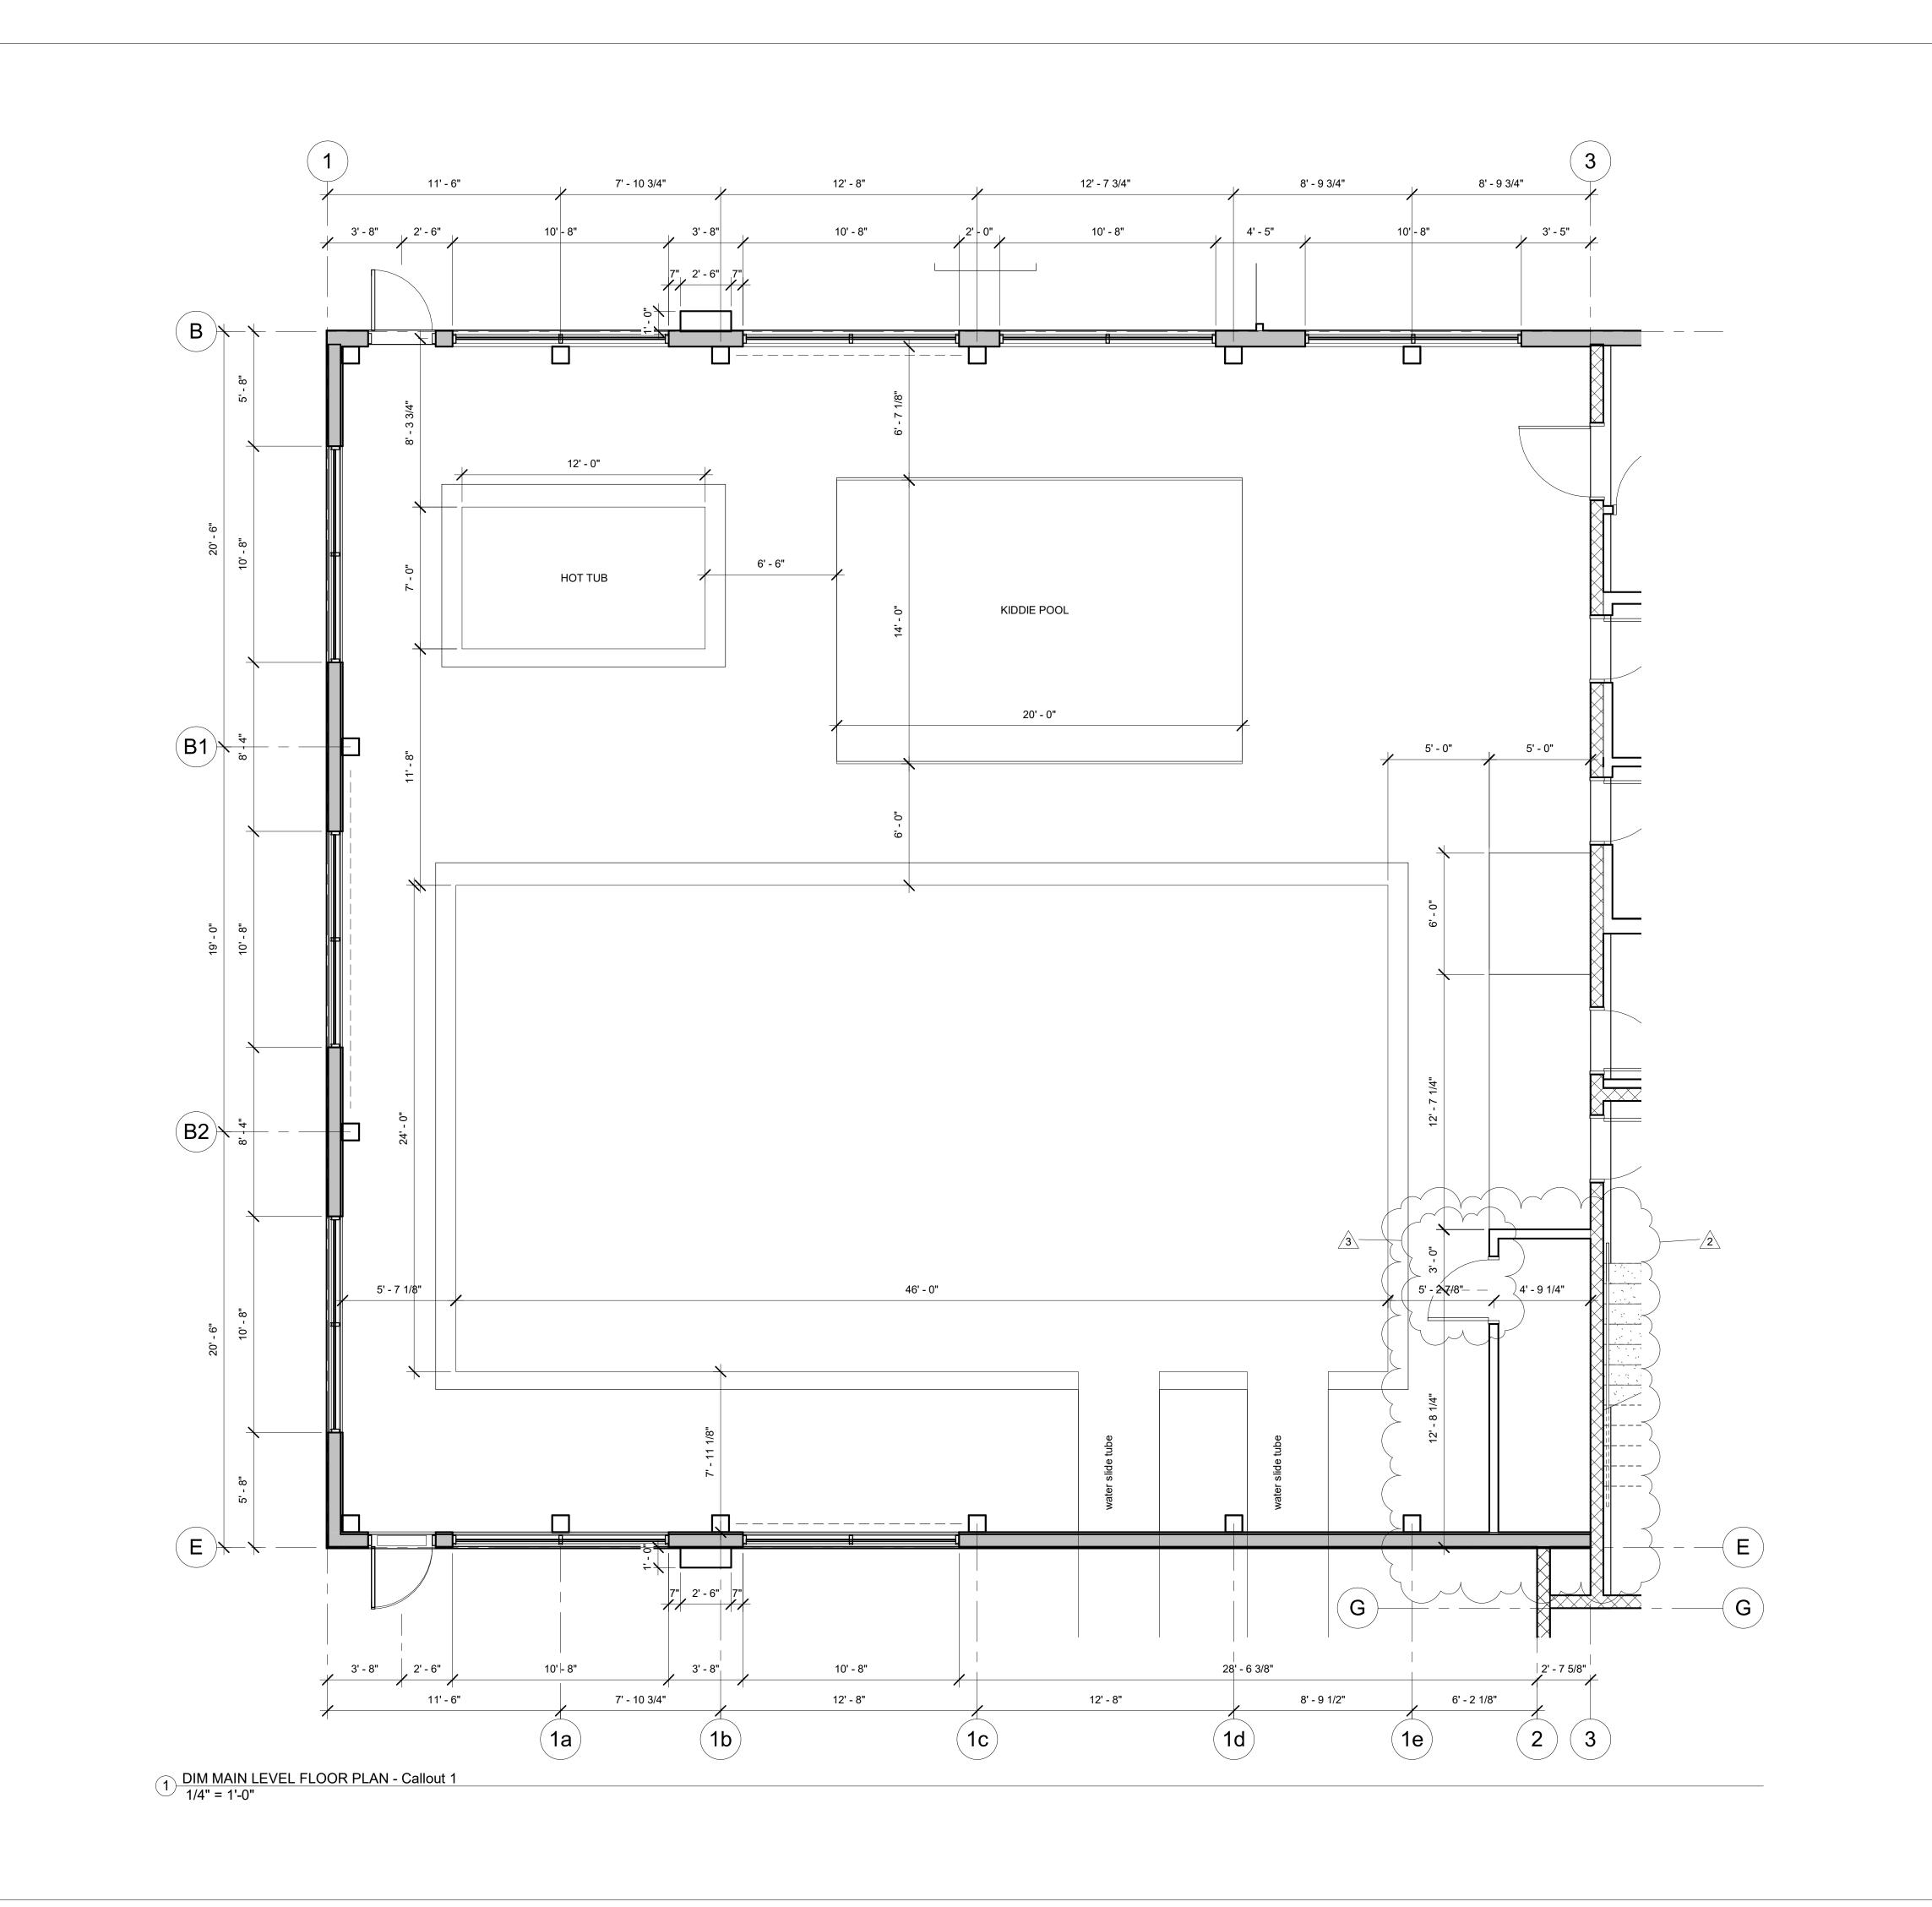

A NEW HOTEL FOR:

TERRA DEVELOPMENT LLC

TWIN FALLS, ID

MAIN DIM PLAN - CALLOUT 1

LICENSED ARCHITECT AR-985708


R. COLBY/RICKS STATE OF IDAHO 5/6/2022

Laughlin Ricks Architecture

architecture/planning

134 3RD AVE. E. * Twin Falls, Idaho 83301
PHONE: (208) 736-8050

DATE: 5/6/2022 RCR Checked

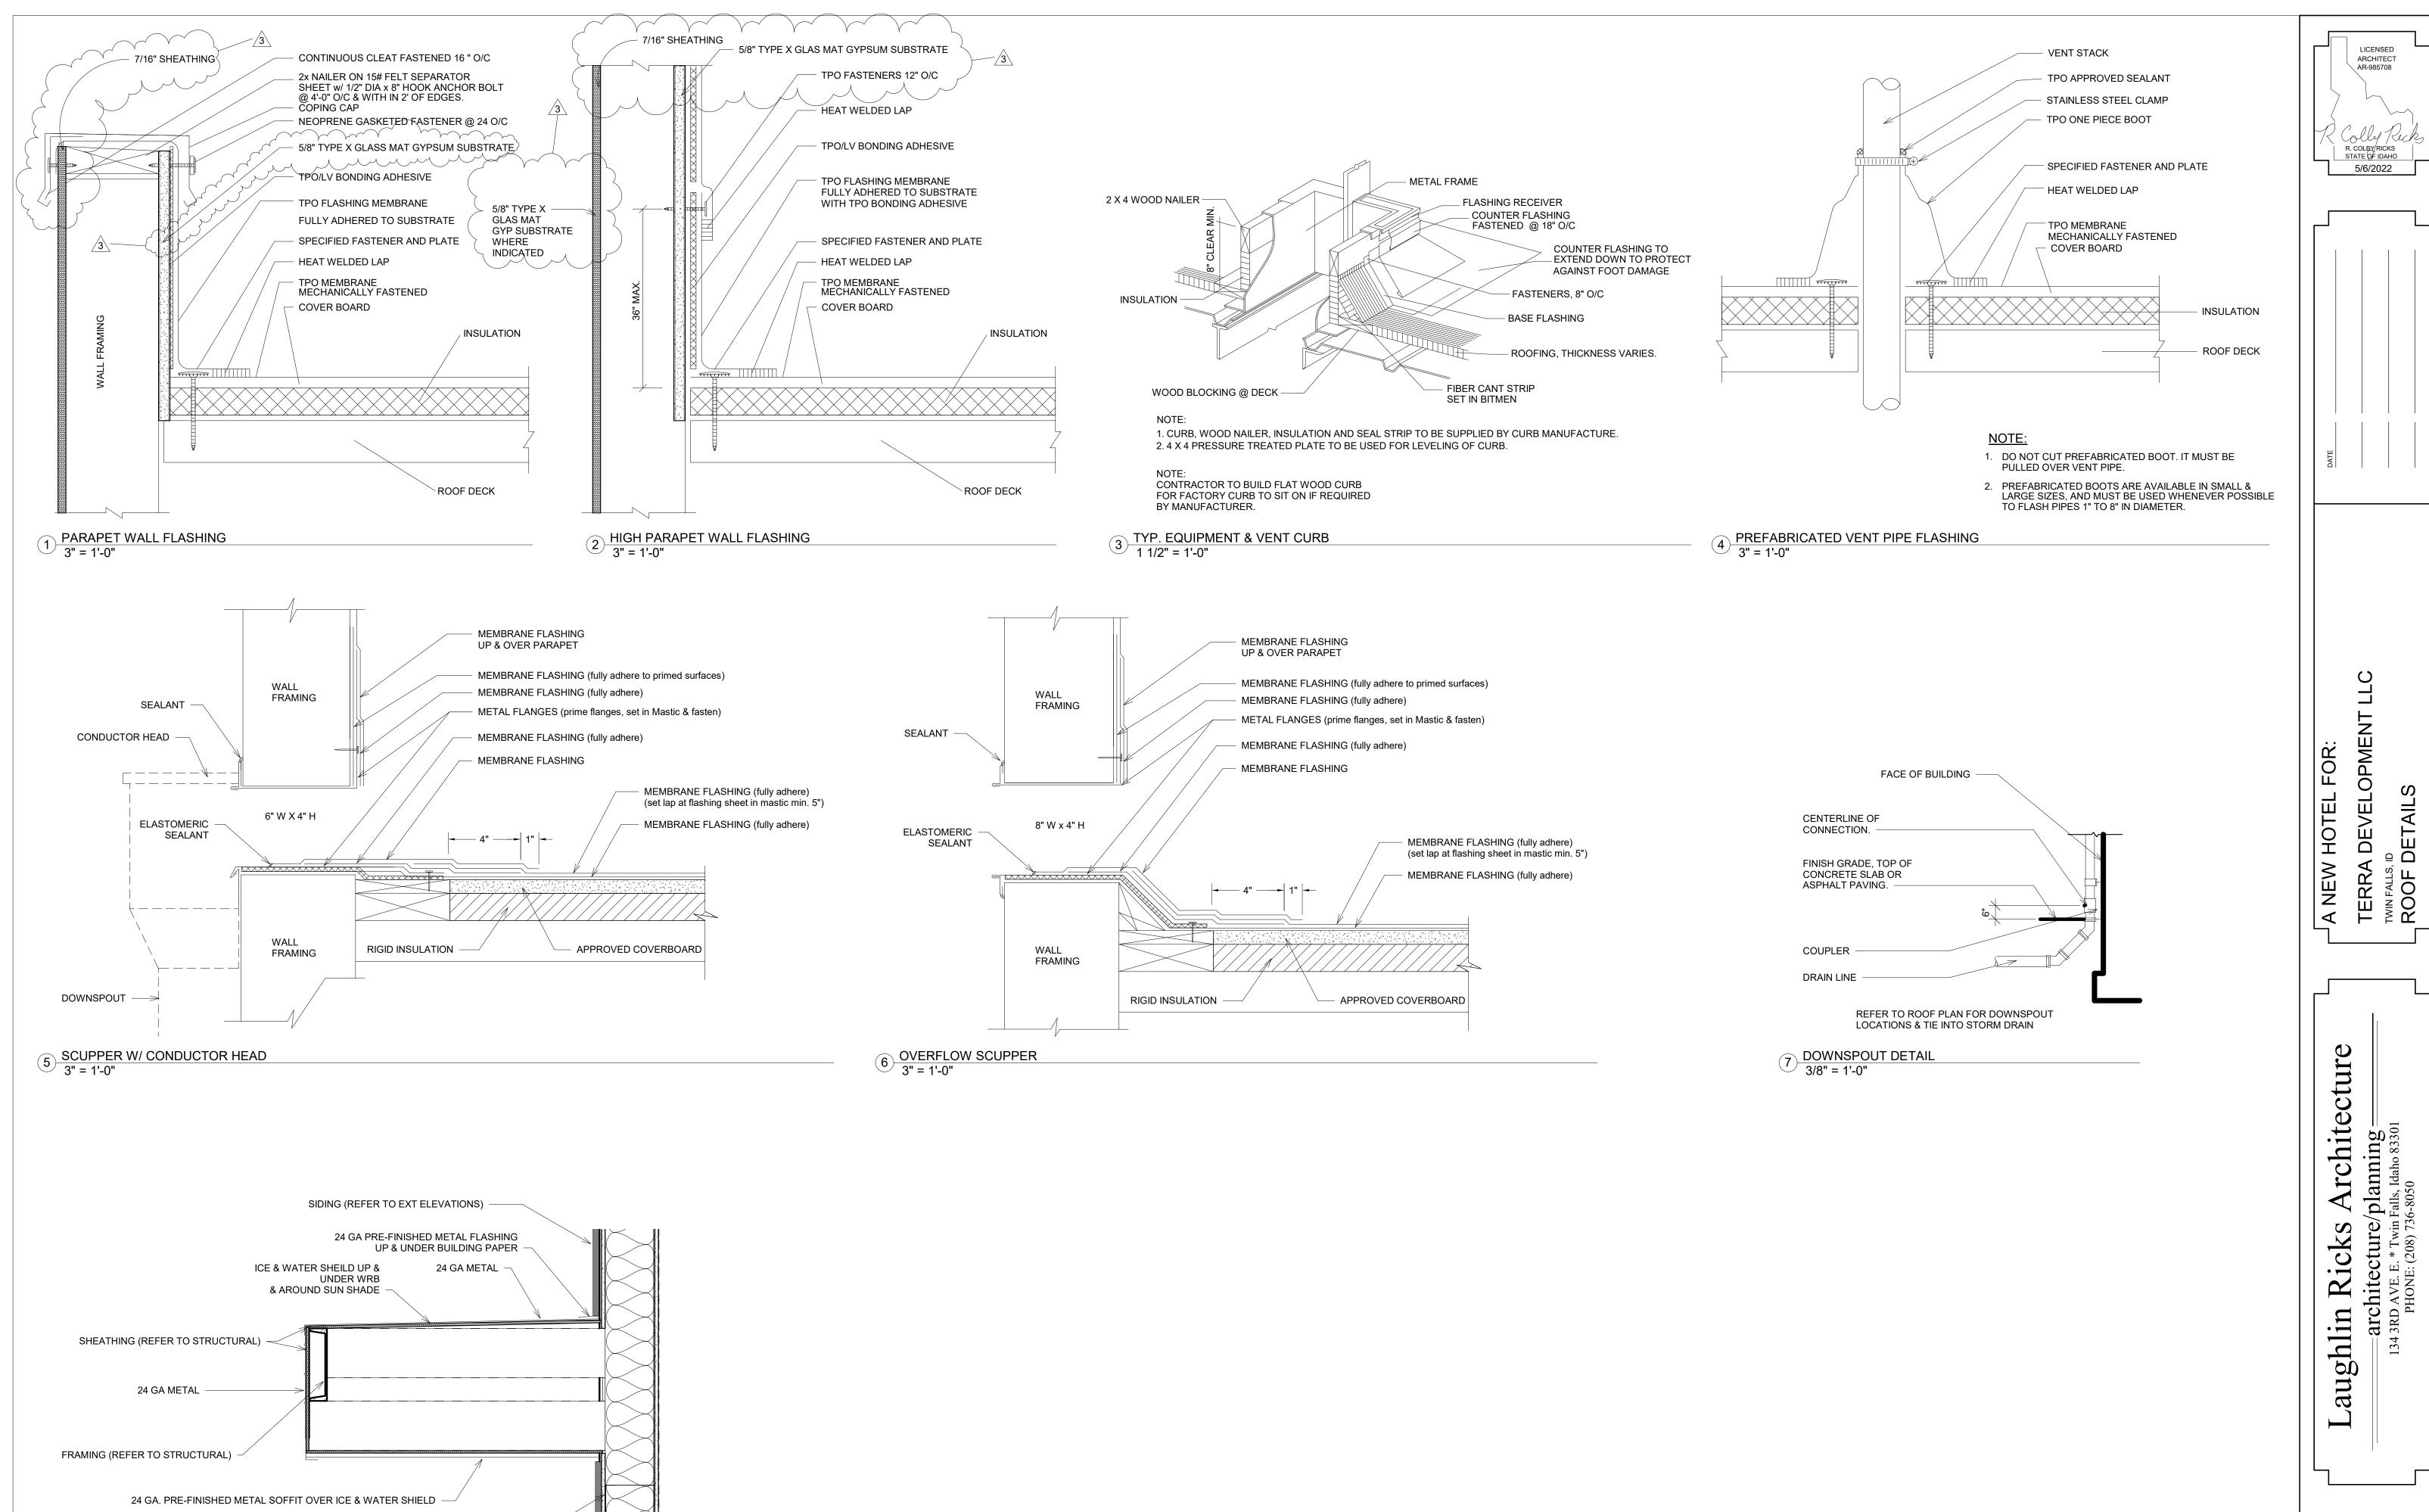

TYPE D BUILDING PAPER

SIDING (REFER TO EXT ELEVATIONS)

8 RED CANOPY 1" = 1'-0"


Architecture =architecture/planning 134 3RD AVE. E. * Twin Falls, Idaho 8330 PHONE: (208) 736-8050 aughlin Ricks


DETAILS

LICENSED

ARCHITECT AR-985708

DATE: 5/6/2022

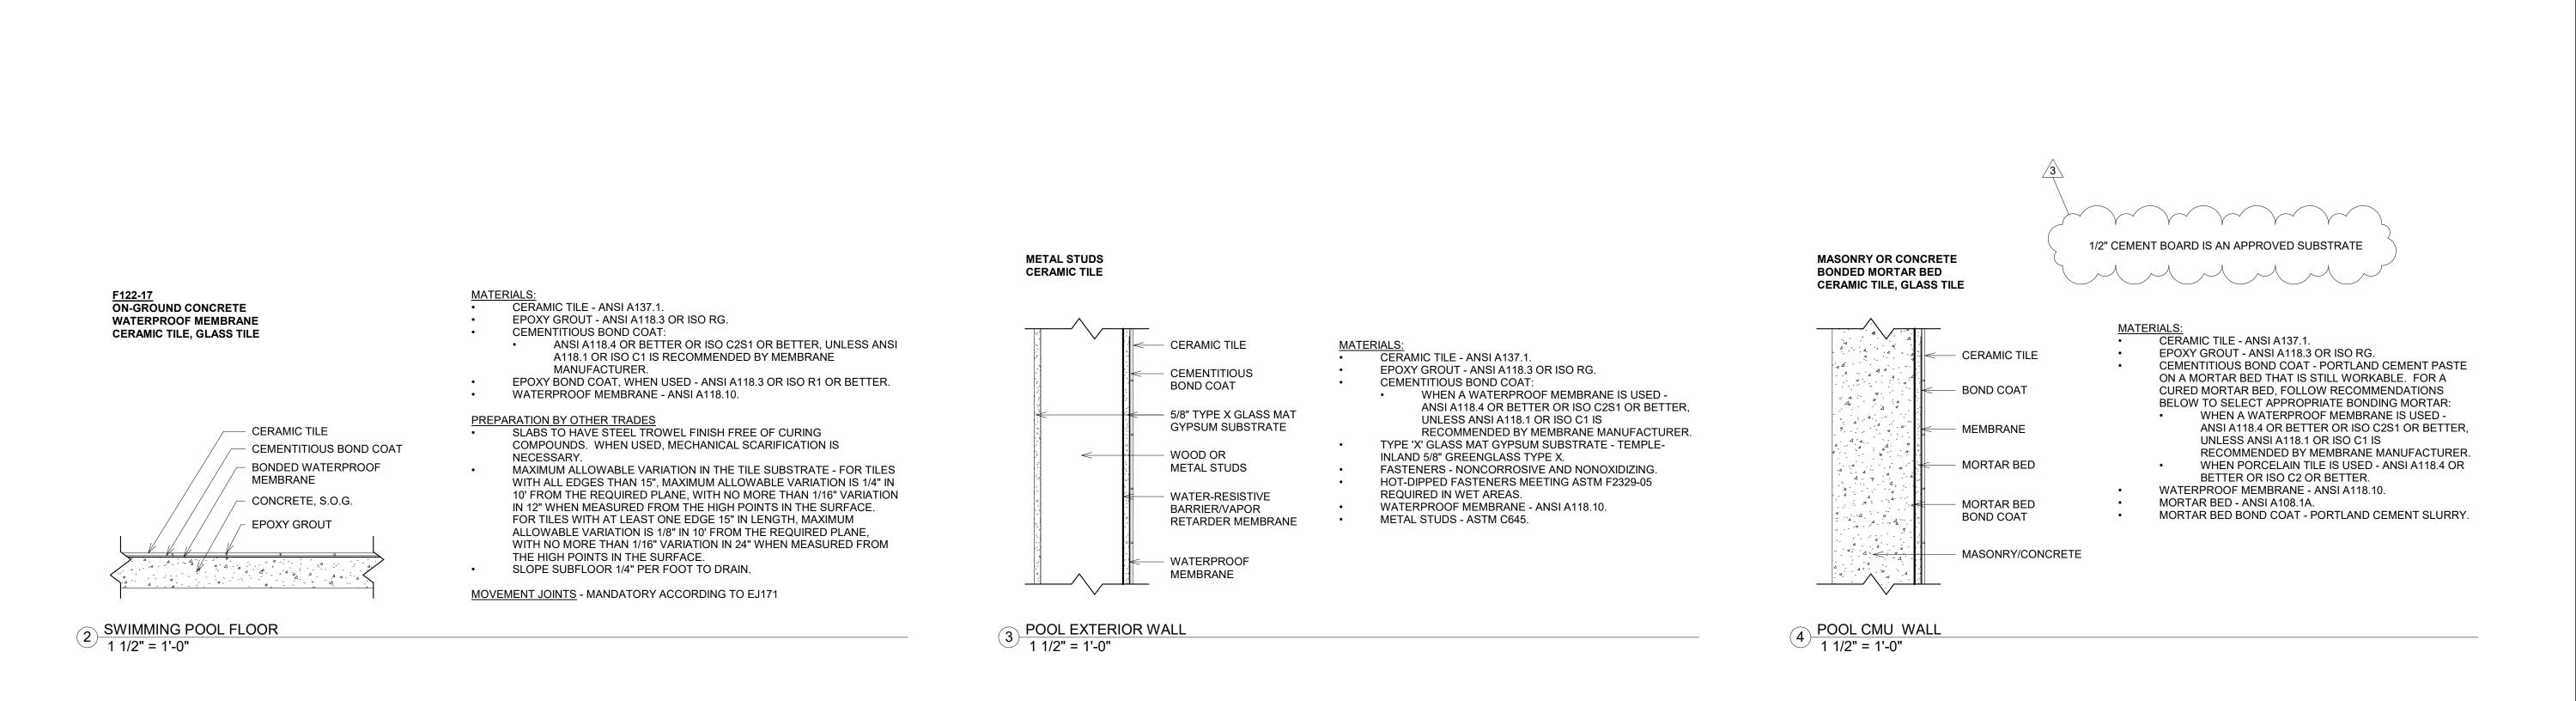

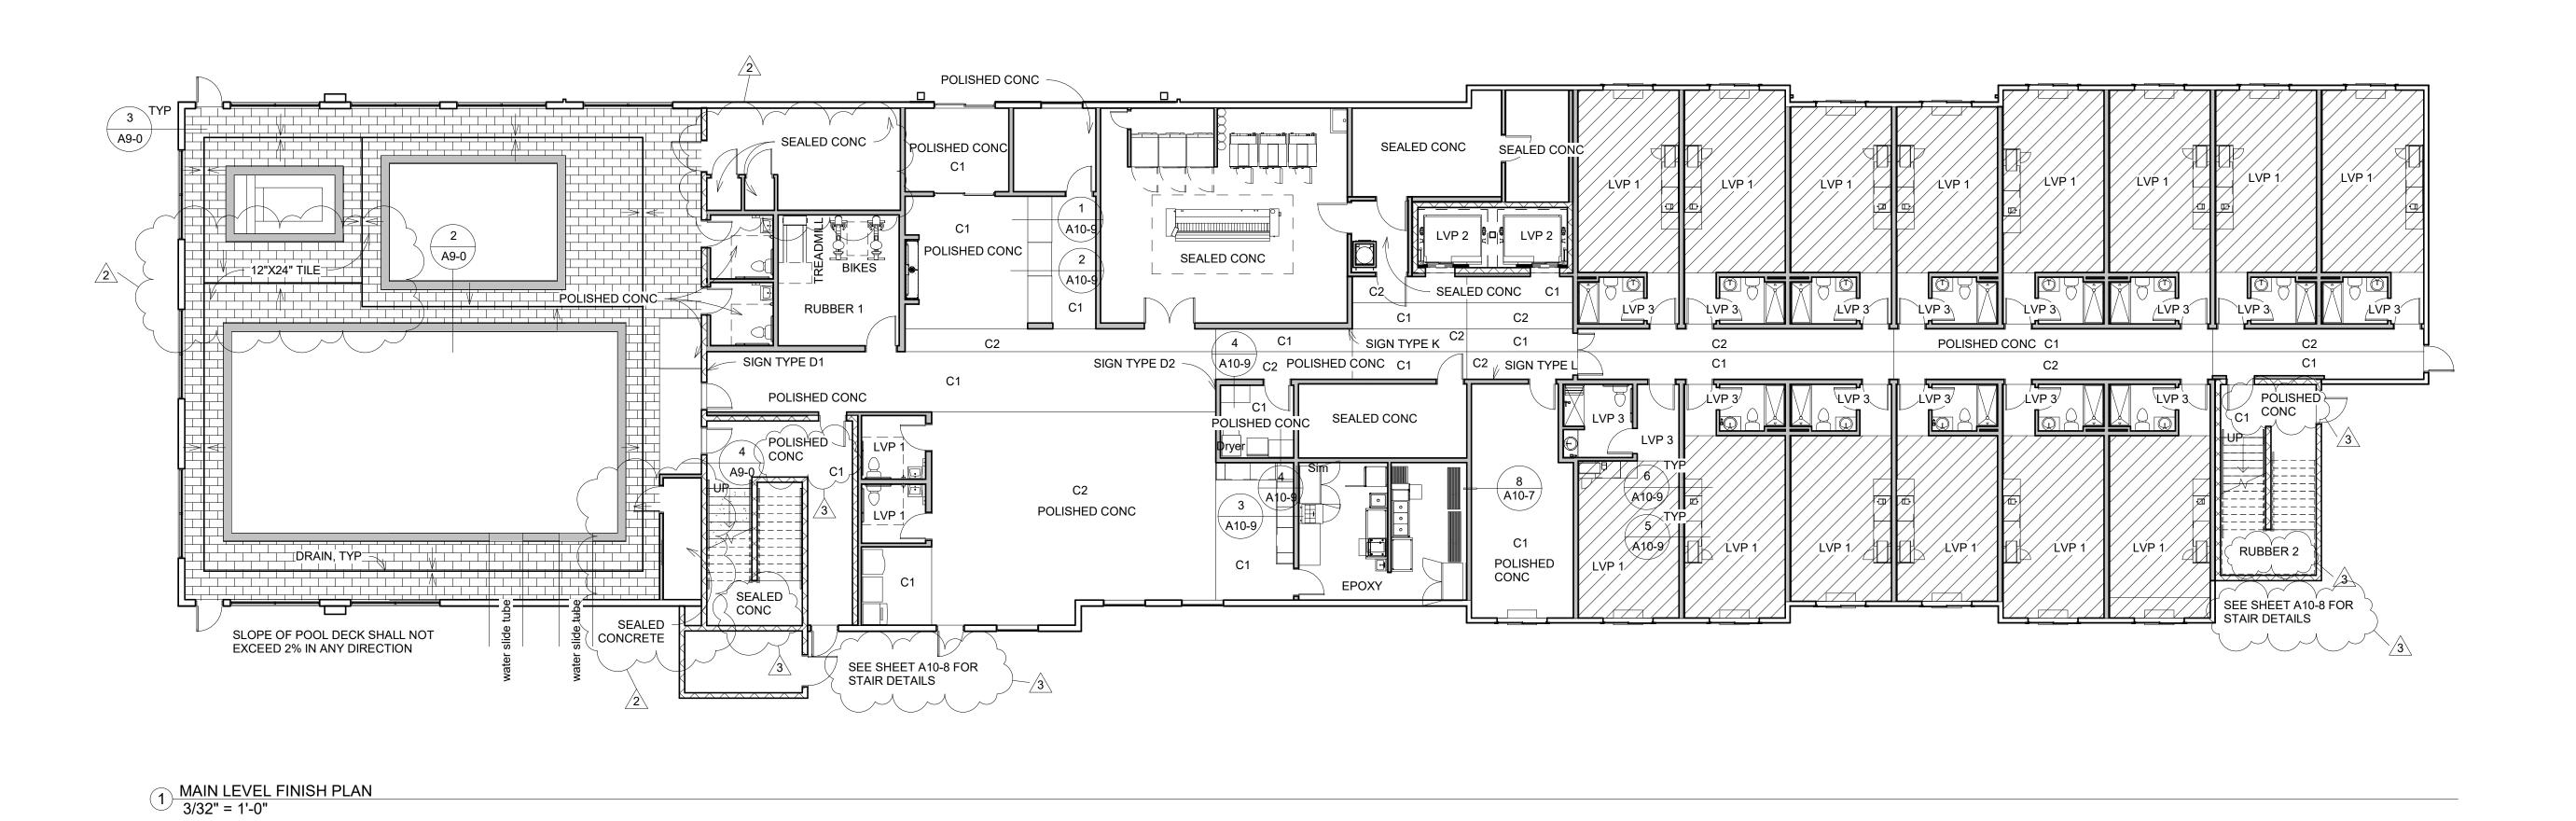

Architectur =architecture/planning=34 3RD AVE. E. * Twin Falls, Idaho 83301 PHONE: (208) 736-8050 Ricks aughlin

DATE: 5/6/2022

Checked

DEVELOPMENT LLC

A NEW HOTEL FOR:

TERRA DEVELOPMENT L
TWIN FALLS, ID
MAIN FLOOR FINISH PLA

R. COLBY/RICKS STATE OF IDAHO 5/6/2022

LICENSED ARCHITECT AR-985708


1 2ND LEVEL FINISH PLAN 3/32" = 1'-0"

Laughlin Ricks Architecture

architecture/planning

134 3RD AVE. E. * Twin Falls, Idaho 83301
PHONE: (208) 736-8050

A NEW HOTEL FOR:
TERRA DEVELOPMENT LLC
TWIN FALLS, ID
2ND FLOOR FINISH PLAN

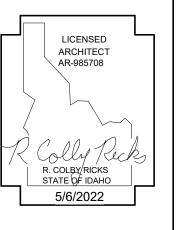

DATE: 5/6/2022



Laughlin Ricks Architecture

architecture/planning


134 3RD AVE. E. * Twin Falls, Idaho 83301
PHONE: (208) 736-8050

DATE: 5/6/2022

A9-2

RCR Checked


A NEW HOTEL FOR:
TERRA DEVELOPMENT LLC
TWIN FALLS, ID
3RD FLOOR FINISH PLAN

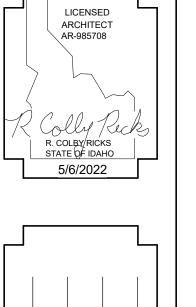



F141-17 JOISTS MAX. 16" O.C./PLYWOOD SUBFLOOR UNBONDED MORTAR BED CERAMIC TILE, GLASS TILE

1 4TH LEVEL FINISH PLAN 3/32" = 1'-0"

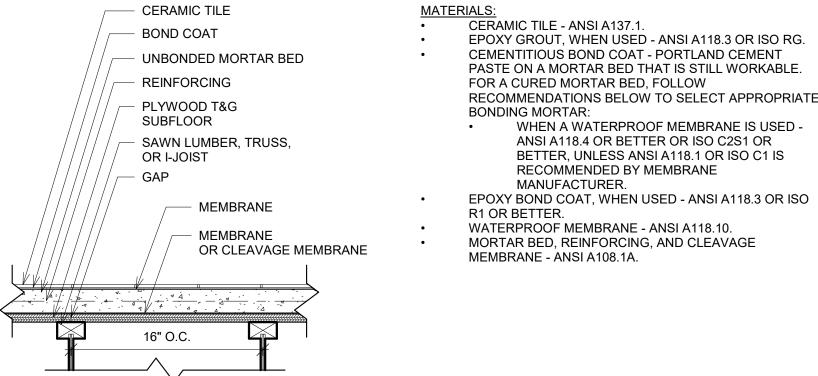

EPOXY GROUT, WHEN USED - ANSI A118.3 OR ISO RG. CEMENTITIOUS BOND COAT - PORTLAND CEMENT PASTE ON A MORTAR BED THAT IS STILL WORKABLE. RECOMMENDATIONS BELOW TO SELECT APPROPRIATE

2 POOL LAUNCH FLOOR 1 1/2" = 1'-0"

aughlin Ricks

ghlin Ricks Architecture

architecture/planning

134 3RD AVE. E. * Twin Falls, Idaho 83301
PHONE: (208) 736-8050

A NEW HOTEL FOR:

TERRA DEVELOPMENT LLC

TWIN FALLS, ID

4TH FLOOR FINISH PLAN

LICENSED ARCHITECT AR-985708

DATE: 5/6/2022

Main Floor Room Finish Schedule Materials Finishes Ceiling														
Number	Name	Base Finish	Floor Finish	North	Mate East	erials South	West	North	Fin East	ishes South	West	Ceiling Material	Ceiling Finish	REMARKS
1.1	VESTIBULE	RUBBER 2	POLISHED CONCRETE	GYP BD	GYP BD	GYP BD	GYP BD	PT	PT	PT	PT	WOOD	STAINED	
1.2	LOBBY	RUBBER 2	POLISHED	GYP BD			GYP BD	PT			PT	2X2 ACT/	FF/PT	
1.3	REC	RUBBER 2	CONCRETE POLISHED	GYP BD	GYP BD			PT	PT			GYP BD 2X2 ACT/	FF/PT	
1.4	OFFICE	RUBBER 2	CONCRETE POLISHED	GYP BD	GYP BD	GYP BD	GYP BD	ACC PT	PT	PT	PT	GYP BD 2X2 ACT	FF	
1.5	LAUNDRY/CARTS		CONCRETE SEALED CONCRETE	TBB	TBB	ТВВ	TBB	PT	PT	PT	PT	2X2 ACT	FF	
1.6	ELEC	RUBBER 3	SEALED CONCRETE	GYP BD	GYP BD	GYP BD	GYP BD	PT	PT	PT	PT	GYP BD	PT	
1.7	EQUIP				GYP BD	GYP BD	GYP BD	PT	PT	PT	PT	GYP BD	PT	
1.8	CHUTE RUBBER 3 SEALED CONCRETE GYP BD GYP BD DISCHARGE					GYP BD	GYP BD	PT	PT	PT	PT	GYP BD	PT	
1.9	ELEV STAIR	PER MFG	LVP2 POLISHED	PER MFG	PER MFG	PER MFG CMU	PER MFG / CMU	FF PT	FF PT	FF	FF PT	PER MFG GYP BD	FF PT	RUBBER 2
1.10	CONCRETE					Civio	OWIG					OH BB		FLOORING ON STAIRS
1.11	1.12 LAUNDRY RUBBER 2 POLISHED TBB TB					TBB TBB	TBB TBB	PT	PT	PT	PT	GYP BD	PT FF	
			CONCRETE					PT	, ,	PT		2X4 ACT	FF V	
1.13 1.14	KITCHEN DINING	COVED 6" RUBBER 2	EPOXY POLISHED	TBB	TBB GYP BD/MDF	TBB GYP BD	TBB GYP BD/MDF	FRP	FRP PT/ACC PT	FRP PT	FRP PT/ACC PT	2X4 ACT GYP BD	FF PT	FRP TO 10'-0"
1.15	RR	RUBBER 2	CONCRETE LVP 1	TBB	TBB	TBB	TBB	EPOXY	EPOXY	EPOXY	EPOXY	GYP BD	PT	TILE TO 7'-0"
1:16	RR	RUBBER 2	LWP 1	₹BB	TBB	ТВВ	TBB	PT/TILE ÆPOXY	PT/TILE EPOXY	PT/TILE EPØXY	PT/TILE EPOXY	GYP BD		TILE TO 7'-0"
								PT/TILE	PIVILE	PT/TILE V	PT/TILE			
1.17 ^Y	STAIR Y	RUBBER 3 Y	POLÍSHED CONCRETE	CMU ^Y	ĆΜU ,	Y CMU	Y CMU Y	PT	PT A	Y PT Y	YPT ,	ČONCRETE ^Y	PT ^Y	SEALÉD CONCRETE STAIRS
1.18	GYM	RUBBER 1	RUBBER 1	GYP BD	GYP BD	GYP BD	GYP BD	PT	PT	PT	PT	GYP BD	PT	STAIRS
1.19	SWIMMING POOL	TILE	TILE	GYP BD	GYP BD	GYP BD	GYP BD	EPOXY PT/TILE	EPOXY PT/TILE	EPOXY PT/TILE	EPOXY PT/TILE	METAL DECK		TILE TO 8'-6", ACC PT @ COLUMNS
1.19P 1.20	PUMP RR	RUBBER 3 RUBBER 2	SEALED CONCRETE POLISHED	TBB TBB	TBB TBB	TBB TBB	TBB TBB	EPOXY PT EPOXY	EPOXY PT EPOXY	EPOXY PT EPOXY	EPOXY PT EPOXY	STRUCTURE GYP BD	EPOXY PT PT	TILE TO 7'-0" -
1.21	RR	RUBBER 2	CONCRETE POLISHED	TBB	TBB	ТВВ	TBB	PT/TILE EPOXY	PT/TILE EPOXY	PT/TILE EPOXY	PT/TILE EPOXY	GYP BD		TILE TO 7'-0"
			CONCRETE					PT/TILE	PT/TILE	PT/TILE	PT/TILE			TILL TO 7 -0
1.22	POOL EQUIPMENT	RUBBER 3	SEALED CONCRETE	TBB	TBB	ТВВ	TBB	EPOXY PT	EPOXY PT	EPOXY PT	EPOXY PT	GYP BD	EPOXY PT	
1.22E 1.23	CHEMICAL	RUBBER 3 RUBBER 3	SEALED CONCRETE SEALED CONCRETE	TBB TBB	TBB TBB	TBB TBB	TBB TBB	EPOXY PT EPOXY PT	EPOXY PT EPOXY PT	EPOXY PT EPOXY PT	EPOXY PT EPOXY PT	GYP BD GYP BD	EPOXY PT EPOXY PT	
1.24	CORR	RUBBER 2	POLISHED CONCRETE	GYP BD/MDF	GYP BD/MDF	GYP BD/MDF	CMU	PT/ACC PT	PT/ACC PT	PT/ACC PT	PT	2X2 ACT/ GYP BD	FF/PT	
1.25	CORR	RUBBER 2	POLISHED CONCRETE	GYP BD/MDF	GYP BD/MDF	GYP BD/MDF	GYP BD/MDF	PT/ACC PT	PT/ACC PT	PT/ACC PT	PT/ACC PT	2X2 ACT/ GYP BD	FF/PT	
1.26	BUSINESS CENTER	RUBBER 2	POLISHED CONCRETE	GYP BD	GYP BD	GYP BD	GYP BD	PT/WOOD	PT/WOOD	PT/WOOD	PT/WOOD	2X2 ACT	FF	
1.27	FRR Room	RUBBER 3 WOOD, PT	SEALED CONCRETE LVP 1/3	CMU GYP BD	CMU GYP BD	CMU GYP BD	CMU GYP BD	SEALED ACC PT	SEALED PT	SEALED PT	SEALED PT	2X2 ACT DEC	FF	
101B	RR	TILE	LVP 3	TBB	TBB	TBB	TBB	EPOXY PT/TILE	EPOXY PT	EPOXY PT	EPOXY PT	GYP BD	PT	
102	ADA Room	WOOD, PT	LVP 1/3	GYP BD	GYP BD	GYP BD	GYP BD	PT	PT	ACC PT	PT	2X2 ACT DEC	FF	
102B	RR	TILE	LVP 3	TBB	TBB	ТВВ	ТВВ	EPOXY PT/TILE	EPOXY PT/TILE	EPOXY PT	EPOXY PT	GYP BD	PT	
103 103B	Room RR	WOOD, PT	LVP 1/3 LVP 3	GYP BD TBB	GYP BD TBB	GYP BD TBB	GYP BD TBB	ACC PT EPOXY PT/TILE	PT EPOXY PT	PT EPOXY PT	PT EPOXY PT	2X2 ACT DEC GYP BD	FF PT	
104 104B	Room RR	WOOD, PT TILE	LVP 1/3 LVP 3	GYP BD TBB	GYP BD TBB	GYP BD TBB	GYP BD TBB	PT EPOXY PT	PT EPOXY PT	ACC PT EPOXY	PT EPOXY PT	2X2 ACT DEC GYP BD	FF PT	
		WOOD, PT	LVP 1/3	GYP BD	GYP BD	GYP BD	GYP BD	ACC PT	PT	PT/TILE PT		2X2 ACT DEC	FF	
105 105B	Room RR	TILE	LVP 1/3	TBB	TBB	TBB	TBB	EPOXY PT/TILE	EPOXY PT	EPOXY PT	PT EPOXY PT	GYP BD	PT	
106 106B	Room RR	WOOD, PT TILE	LVP 1/3 LVP 3	GYP BD TBB	GYP BD TBB	GYP BD TBB	GYP BD TBB	PT EPOXY PT	PT EPOXY PT	ACC PT EPOXY	PT EPOXY PT	2X2 ACT DEC GYP BD	FF PT	
				GYP BD			GYP BD	ACC PT	PT	PT/TILE		2X2 ACT DEC		
107 107B	Room RR	WOOD, PT	LVP 1/3 LVP 3	TBB	GYP BD TBB	GYP BD TBB	TBB	EPOXY PT/TILE	EPOXY PT	PT EPOXY PT	PT EPOXY PT	GYP BD	PT	
108 108B	Room RR	WOOD, PT TILE	LVP 1/3 LVP 3	GYP BD TBB	GYP BD TBB	GYP BD TBB	GYP BD TBB	PT EPOXY PT	PT EPOXY PT	ACC PT EPOXY	PT EPOXY PT	2X2 ACT DEC GYP BD	FF PT	
109	Room	WOOD, PT	LVP 1/3	GYP BD	GYP BD	GYP BD	GYP BD	ACC PT	PT	PT/TILE PT	PT	2X2 ACT DEC		
109B	RR	TILE	LVP 3	TBB	TBB	TBB	TBB	EPOXY	EPOXY PT	EPOXY PT	EPOXY PT	GYP BD	PT	
110 110B	Room RR	WOOD, PT	LVP 1/3 LVP 3	GYP BD TBB	GYP BD TBB	GYP BD TBB	GYP BD TBB	PT/TILE PT EPOXY PT	PT EPOXY PT	ACC PT EPOXY	PT EPOXY PT	2X2 ACT DEC GYP BD	FF PT	
111 111B	Room RR	WOOD, PT	LVP 1/3 LVP 3	GYP BD TBB	GYP BD TBB	GYP BD TBB	GYP BD TBB	ACC PT EPOXY	PT EPOXY PT	PT/TILE PT EPOXY PT	PT EPOXY PT	2X2 ACT DEC GYP BD	FF PT	
112	Room	WOOD, PT	LVP 1/3	GYP BD	GYP BD	GYP BD	GYP BD	PT/TILE PT	PT	ACC PT	PT	2X2 ACT DEC	FF	
112B	RR	TILE	LVP 3	TBB	TBB	TBB	TBB	EPOXY PT	EPOXY PT	EPOXY PT/TILE	EPOXY PT	GYP BD	PT	
113 113B	Room RR	WOOD, PT	LVP 1/3 LVP 3	GYP BD TBB	GYP BD TBB	GYP BD TBB	GYP BD TBB	ACC PT EPOXY	PT EPOXY PT	PT EPOXY PT	PT EPOXY PT	2X2 ACT DEC GYP BD	FF PT	
115	Room	WOOD, PT	LVP 1/3	GYP BD	GYP BD	GYP BD	GYP BD	PT/TILE ACC PT	PT	PT	PT	2X2 ACT DEC	FF	
115B	RR	TILE	LVP 3	TBB	TBB	TBB	TBB	EPOXY PT	EPOXY PT	EPOXY PT/TILE	EPOXY PT	GYP BD	PT	

NOTE: ALL GYPSUM BOARD SHALL BE TYPE 'X'

					Mate	riale	or Room Finis		Fi	shes		O : ""		
Number	Name	Base Finish	Floor Finish	North	East	South	West	North	East	South	West	Ceiling Material	Ceiling Finish	REMARKS
2.1	CARTS/STG	RUBBER 3	LVP 3	GYP BD	GYP BD	GYP BD	GYP BD	PT	PT	PT	PT	GYP BD	PT	
2.2	ELEC	RUBBER 3	LVP 3	GYP BD	GYP BD	GYP BD	GYP BD	PT	PT	PT	PT	GYP BD	PT	
$\overline{}$	CHUTE	RUBBER 3	LVP 3	GYP BD	GYP BD	GYP BD	GYP BD	PT FF	PT	PT	PT	GYP BD	PT	
2.4	STAIR	PER MFG RUBBER 3	LVP 2 LVP 2 LANDING	PER MFG CMU	PER MFG CMU	PÈR MFG CMU	PER MFG CMU	PT	✓ FF, ✓ PT	PT	FF PT	PER MFG GYP BD	PT	RUBBER 2 FLOORING ON STAIRS
2.6	STAIR	RUBBER 3	SEALED CONCRETE LANDING	СМИ	CMU	CMU	CMU	PT	PT	PT	PT	CONCRETE	PT	SEALED CONCRETE STAIRS
2.7	CORR	RUBBER 2	VP 2/4	GYP BD/MDF	GYP BD/MDF	GYP BD/MDF	CMU	PT/ACC PT	PT/ACC PT	PTVACC PT	PT	2X2 ACT/ GYP BD	FF/PT	OTAIL O
201	Room	WOOD, PT	LVP 1/3	GYP BD	GYP BD	GYP BD	GYP BD	ACC PT	PT	PT	PT	GYP BD	FF	
201B	RR	TILE	LVP 3	ТВВ	TBB	TBB	TBB	EPOXY PT/TILE	EPOXY PT	EPOXY PT	EPOXY PT	GYP BD	PT	
	ADA Room	WOOD, PT	LVP 1/3	GYP BD	GYP BD	GYP BD	GYP BD	PT	PT FROM PT	ACC PT	PT	GYP BD	FF	
202B 203	RR	TILE WOOD, PT	LVP 3	TBB GYP BD	TBB GYP BD	TBB GYP BD	TBB GYP BD	EPOXY PT/TILE ACC PT	EPOXY PT PT	EPOXY PT PT	EPOXY PT/TILE PT	GYP BD GYP BD	PT FF	
203 203B	RR	TILE	LVP 1/3	TBB	TBB	TBB	TBB	EPOXY PT/TILE	EPOXY PT	EPOXY PT	EPOXY PT	GYP BD	PT	
204	Room	WOOD, PT	LVP 1/3	GYP BD	GYP BD	GYP BD	GYP BD	PT	PT	ACC PT	PT	GYP BD	FF	
204B	RR	TILE	LVP 3	ТВВ	ТВВ	TBB	TBB	EPOXY PT	EPOXY PT	EPOXY PT/TILE	EPOXY PT	GYP BD	PT	
205	Room	WOOD, PT	LVP 1/3	GYP BD	GYP BD	GYP BD	GYP BD	ACC PT	PT	PT	PT	GYP BD	FF	
205B	RR	TILE	LVP 3	TBB	TBB	TBB	TBB	EPOXY PT/TILE	EPOXY PT	EPOXY PT	EPOXY PT	GYP BD	PT	
206 206B	Room RR	WOOD, PT TILE	LVP 1/3 LVP 3	GYP BD TBB	GYP BD TBB	GYP BD TBB	GYP BD TBB	PT EPOXY PT	PT EPOXY PT	ACC PT EPOXY	PT EPOXY PT	GYP BD GYP BD	FF PT	
										PT/TILE				
207 207B	Room RR	WOOD, PT TILE	LVP 1/3 LVP 3	GYP BD TBB	GYP BD TBB	GYP BD TBB	GYP BD TBB	ACC PT EPOXY	PT EPOXY PT	PT EPOXY PT	PT EPOXY	GYP BD GYP BD	FF PT	
208	Room RR	WOOD, PT	LVP 1/3	GYP BD	GYP BD	GYP BD TBB	GYP BD TBB	PT/TILE PT	PT EDOXY BT	ACC PT EPOXY	PT/TILE PT	GYP BD GYP BD	FF PT	
			LVP 3	TBB	TBB			EPOXY PT	EPOXY PT	PT/TILE	EPOXY PT			
	Room RR	WOOD, PT TILE	LVP 1/3 LVP 3	GYP BD TBB	GYP BD TBB	GYP BD TBB	GYP BD TBB	ACC PT EPOXY PT/TILE	PT EPOXY PT	PT EPOXY PT	PT EPOXY PT	GYP BD GYP BD	FF PT	
	Room RR	WOOD, PT TILE	LVP 1/3 LVP 3	GYP BD TBB	GYP BD TBB	GYP BD TBB	GYP BD TBB	PT EPOXY PT	PT EPOXY PT	ACC PT EPOXY PT/TILE	PT EPOXY PT	GYP BD GYP BD	FF PT	
	Room RR	WOOD, PT TILE	LVP 1/3 LVP 3	GYP BD TBB	GYP BD TBB	GYP BD TBB	GYP BD TBB	ACC PT EPOXY PT/TILE	PT EPOXY PT	PT EPOXY PT	PT EPOXY PT	GYP BD GYP BD	FF PT	
212 212B	Room RR	WOOD, PT	LVP 1/3 LVP 3	GYP BD TBB	GYP BD TBB	GYP BD TBB	GYP BD TBB	PT EPOXY PT	PT EPOXY PT	ACC PT EPOXY PT/TILE	PT EPOXY PT	GYP BD GYP BD	FF PT	
213 213B	Room RR	WOOD, PT TILE	LVP 1/3 LVP 3	GYP BD TBB	GYP BD TBB	GYP BD TBB	GYP BD TBB	ACC PT EPOXY	PT EPOXY PT	PT EPOXY PT	PT EPOXY PT	GYP BD GYP BD	FF PT	
214 214B	Room RR	WOOD, PT	LVP 1/3 LVP 3	GYP BD TBB	GYP BD TBB	GYP BD TBB	GYP BD TBB	PT/TILE PT EPOXY PT	PT EPOXY PT	ACC PT EPOXY	PT EPOXY PT	GYP BD GYP BD	FF PT	
220 220B	Room RR	WOOD, PT TILE	LVP 1/3 LVP 3	GYP BD TBB	GYP BD TBB	GYP BD TBB	GYP BD TBB	PT EPOXY PT	PT EPOXY PT	ACC PT EPOXY	PT EPOXY PT	GYP BD GYP BD	FF PT	
221	Room	WOOD, PT	LVP 1/3	GYP BD	GYP BD	GYP BD	GYP BD	ACC PT	PT	PT/TILE PT	PT	GYP BD	FF	
	RR	TILE	LVP 3	ТВВ	TBB	TBB	TBB	EPOXY PT/TILE	EPOXY PT	EPOXY PT	EPOXY PT	GYP BD	PT	
222	Room	WOOD, PT	LVP 1/3	GYP BD	GYP BD	GYP BD	GYP BD	PT EDOXY DT	PT EDOXY DT	ACC PT	PT FROM PT	GYP BD	FF	
	RR	TILE	LVP 3	TBB	TBB	TBB	TBB	EPOXY PT	EPOXY PT	EPOXY PT/TILE	EPOXY PT	GYP BD	PT	
223 223B	Room RR	WOOD, PT	LVP 1/3 LVP 3	GYP BD TBB	GYP BD TBB	GYP BD TBB	GYP BD TBB	ACC PT EPOXY PT/TILE	PT EPOXY PT	PT EPOXY PT	PT EPOXY PT	GYP BD GYP BD	FF PT	
224	Room	WOOD, PT	LVP 1/3	GYP BD	GYP BD	GYP BD	GYP BD	PT	PT	ACC PT	PT	GYP BD	FF	
224B	RR	TILE	LVP 3	ТВВ	ТВВ	ТВВ	TBB	EPOXY PT	EPOXY PT	EPOXY PT/TILE	EPOXY PT	GYP BD	PT	
	Room	WOOD, PT	LVP 1/3	GYP BD	GYP BD	GYP BD	GYP BD	ACC PT	PT	PT	PT	GYP BD	FF	
225B	RR	TILE	LVP 3	TBB	TBB	TBB	TBB	EPOXY PT/TILE	EPOXY PT	EPOXY PT	EPOXY PT	GYP BD	PT	
	Room RR	WOOD, PT TILE	LVP 1/3 LVP 3	GYP BD TBB	GYP BD TBB	GYP BD TBB	GYP BD TBB	PT EPOXY PT	PT EPOXY PT	ACC PT EPOXY	PT EPOXY PT	GYP BD GYP BD	FF PT	
	Room	WOOD, PT	LVP 1/3	GYP BD	GYP BD	GYP BD	GYP BD	ACC PT	PT	PT/TILE PT	PT	GYP BD	FF	
	RR	TILE	LVP 1/3	TBB	TBB	TBB	TBB	EPOXY	EPOXY PT	EPOXY PT	EPOXY PT	GYP BD	PT	

LICENSED
ARCHITECT
AR-985708

R. COLBYRICKS
STATE OF IDAHO
5/6/2022

Laughlin Ricks Architecture

architecture/planning

134 3RD AVE. E. * Twin Falls, Idabo 83301
PHONE: (208) 736-8050

A NEW HOTEL FOR:

TERRA DEVELOPMENT LLC

TWIN FALLS, ID

ROOM FINISH SCHEDULE 1ST & 2ND

DATE: 5/6/2022

NM RCR

Drawn Checked

A9-4

3.1 3.2 3.3 3.4 3.5 3.6	Name CARTS/STG ELEC	Base Finish	Floor Finish	North	East	South	West	Manth	Foot	South	West	Ceiling Material	Cailing Finish	REMARKS
3.2 3.3 3.4 3.5 3.6		DUDDED				South	vvest	North	East	South	VVESI	iviatei iai	Cennig i misn	
3.3 3.4 3.5 3.6	_	RUBBER 3	LVP 3	GYP BD GYP BD	GYP BD GYP BD	GYP BD GYP BD	GYP BD GYP BD	PT PT	PT PT	PT PT	PT PT	GYP BD GYP BD	PT PT	
3.5	CHUTE	RUBBER 3 PER MFG	LVP 3	GYP BD PER MFG	GYP BD PER MFG	GYP BD PER MFG	GYP BD PER MFG	PT	PT	PT FF	PT	GYP BD PER MFG	PT	
	STAIR	RUBBER 3	LVP 2 LANDING	CMU	CMU	CMU	CMU	PT	PT	PT	PT	GYP BD	PT	RUBBER 2 FLOORING
	STAIR	RUBBER 3	SEALED CONCRETE LANDING	CMU	СМИ	CMU	CMU	PT	PT	PT	PT	CONCRETE	PT	ON STAIRS SEALED CONCRET E STAIRS
3.7	MECH	RUBBER 3	LVP 3 LVP 2/4	GYP BD GYP BD/MDF	GYP BD	GYP BD/MDF	GYP BD/MDF	PT/ACC PT	PT	PT/ACC PT	PT/ACC PT	GYP BD 2X2 ACT/	PT FF/PT	LSTAIRS
3.9	CORR	RUBBER 2	LVP 2/4	GYP BD/MDF	GYP BD/MDF	GYP BD/MDF	GTP BD/MDF	PT/ACC PT	PT/ACC PT	PT/ACC PT	PI/ACC PI	GYP BD 2X2 ACT/	FF/PT	
301	Room	WOOD, PT	LVP 1/3	GYP BD	GYP BD	GYP BD	GYP BD	ACC PT	PT	PT	PT	GYP BD GYP BD	FF	
301B	RR	TILE	LVP 3	TBB	TBB	TBB	TBB	EPOXY PT/TILE	EPOXY PT	EPOXY PT	EPOXY PT	GYP BD	PT	
302 302B	Room RR	WOOD, PT TILE	LVP 1/3 LVP 3	GYP BD TBB	GYP BD TBB	GYP BD TBB	GYP BD TBB	PT EPOXY PT	PT EPOXY PT	ACC PT EPOXY	PT EPOXY PT	GYP BD GYP BD	FF PT	
303 303B	Room RR	WOOD, PT	LVP 1/3 LVP 3	GYP BD TBB	GYP BD TBB	GYP BD TBB	GYP BD TBB	ACC PT EPOXY PT/TILE	PT EPOXY PT	PT/TILE PT EPOXY PT	PT EPOXY PT	GYP BD GYP BD	FF PT	
304 304B	Room RR	WOOD, PT	LVP 1/3 LVP 3	GYP BD TBB	GYP BD TBB	GYP BD TBB	GYP BD TBB	PT EPOXY PT	PT EPOXY PT	ACC PT EPOXY	PT EPOXY PT	GYP BD GYP BD	FF PT	
305	Room	WOOD, PT	LVP 1/3	GYP BD	GYP BD	GYP BD	GYP BD	ACC PT	PT	PT/TILE PT	PT	GYP BD	FF	
305B	RR	TILE	LVP 3	ТВВ	ТВВ	TBB	TBB	EPOXY PT/TILE	EPOXY PT	EPOXY PT	EPOXY PT	GYP BD	PT	
306 306B	Room RR	WOOD, PT TILE	LVP 1/3 LVP 3	GYP BD TBB	GYP BD TBB	GYP BD TBB	GYP BD TBB	PT EPOXY PT	PT EPOXY PT	ACC PT EPOXY	PT EPOXY PT	GYP BD GYP BD	FF PT	
307	ADA Room	WOOD, PT	LVP 1/3	TBB	TBB	TBB	TBB	ACC PT	PT	PT/TILE PT	PT	GYP BD	FF	
307B	Room	TILE	LVP 3	GYP BD	GYP BD	GYP BD	GYP BD	EPOXY PT	EPOXY PT/TILE	EPOXY PT/TILE	EPOXY PT	GYP BD	PT	
308 308B	ADA Room RR	WOOD, PT	LVP 1/3 LVP 3	TBB TBB	TBB TBB	TBB TBB	TBB TBB	PT EPOXY PT/TILE	PT EPOXY PT	ACC PT EPOXY PT	PT EPOXY PT/TILE	GYP BD GYP BD	FF PT	
309 309B	Room RR	WOOD, PT	LVP 1/3 LVP 3	GYP BD TBB	GYP BD TBB	GYP BD TBB	GYP BD TBB	ACC PT EPOXY	PT EPOXY PT	PT EPOXY PT	PT EPOXY PT	GYP BD GYP BD	FF PT	
310	Room	WOOD, PT	LVP 1/3	GYP BD	GYP BD	GYP BD	GYP BD	PT/TILE PT	PT	ACC PT	PT	GYP BD	FF	
310B	RR	TILE	LVP 3	ТВВ	ТВВ	TBB	ТВВ	EPOXY PT	EPOXY PT	EPOXY PT/TILE	EPOXY PT	GYP BD	PT	
311 311B	Room RR	WOOD, PT TILE	LVP 1/3 LVP 3	GYP BD TBB	GYP BD TBB	GYP BD TBB	GYP BD TBB	ACC PT EPOXY	PT EPOXY PT	PT EPOXY PT	PT EPOXY PT	GYP BD GYP BD	FF PT	
312	Room	WOOD, PT	LVP 1/3	GYP BD	GYP BD	GYP BD	GYP BD	PT/TILE PT	PT	ACC PT	PT	GYP BD	FF	
312B	RR	TILE	LVP 3	TBB	TBB	TBB	TBB	EPOXY PT/TILE	EPOXY PT	EPOXY PT/TILE	EPOXY PT	GYP BD	PT	
313 313B	Room RR	WOOD, PT	LVP 1/3 LVP 3	GYP BD TBB	GYP BD TBB	GYP BD TBB	GYP BD TBB	ACC PT EPOXY PT/TILE	PT EPOXY PT	PT EPOXY PT	PT EPOXY PT	GYP BD GYP BD	FF PT	
314 314B	Room RR	WOOD, PT	LVP 1/3 LVP 3	GYP BD TBB	GYP BD TBB	GYP BD TBB	GYP BD TBB	PT EPOXY PT	PT EPOXY PT	ACC PT EPOXY	PT EPOXY PT	GYP BD GYP BD	FF PT	
315	Room	WOOD, PT	LVP 1/3	GYP BD	GYP BD	GYP BD	GYP BD	ACC PT	PT	PT/TILE PT	PT	GYP BD	FF PT	
315B 316	RR	WOOD, PT	LVP 3	TBB GYP BD	TBB GYP BD	TBB GYP BD	TBB GYP BD	EPOXY PT/TILE PT	EPOXY PT PT	EPOXY PT ACC PT	EPOXY PT PT	GYP BD	FF	
316B	RR	TILE	LVP 3	ТВВ	ТВВ	ТВВ	ТВВ	EPOXY PT	EPOXY PT	EPOXY PT/TILE	EPOXY PT	GYP BD	PT	
317 317B	Room RR	WOOD, PT TILE	LVP 1/3 LVP 3	GYP BD TBB	GYP BD TBB	GYP BD TBB	GYP BD TBB	ACC PT EPOXY	PT EPOXY PT	PT EPOXY PT	PT EPOXY PT	GYP BD GYP BD	FF PT	
318	Room	WOOD, PT	LVP 1/3	GYP BD	GYP BD	GYP BD	GYP BD	PT/TILE PT	PT	ACC PT	PT	GYP BD	FF	
318B 319	RR	WOOD, PT	LVP 3	TBB GYP BD	TBB GYP BD	TBB GYP BD	TBB GYP BD	ACC PT	EPOXY PT PT	EPOXY PT/TILE PT	EPOXY PT PT	GYP BD	PT FF	
319B	Room RR	TILE	LVP 3	TBB	TBB	TBB	TBB	EPOXY PT/TILE	EPOXY PT	EPOXY PT	EPOXY PT	GYP BD	PT	
320 320B	Room RR	WOOD, PT	LVP 1/3 LVP 3	GYP BD TBB	GYP BD TBB	GYP BD TBB	GYP BD TBB	PT EPOXY PT	PT EPOXY PT	ACC PT EPOXY	PT EPOXY PT	GYP BD GYP BD	FF PT	
321	Room	WOOD, PT	LVP 1/3	GYP BD	GYP BD	GYP BD	GYP BD	ACC PT	PT	PT/TILE PT	PT	GYP BD	FF	
321B	RR	TILE	LVP 3	TBB	TBB	TBB	TBB	EPOXY PT/TILE	EPOXY PT	EPOXY PT	EPOXY PT	GYP BD	PT	
322 322B	Room RR	WOOD, PT	LVP 1/3 LVP 3	GYP BD TBB	GYP BD TBB	GYP BD TBB	GYP BD TBB	PT EPOXY PT	PT EPOXY PT	ACC PT EPOXY PT/TILE	PT EPOXY PT	GYP BD GYP BD	FF PT	
323 323B	Room RR	WOOD, PT	LVP 1/3 LVP 3	GYP BD TBB	GYP BD TBB	GYP BD TBB	GYP BD TBB	ACC PT EPOXY	PT EPOXY PT	PT EPOXY PT	PT EPOXY PT	GYP BD GYP BD	FF PT	
324	Room	WOOD, PT	LVP 1/3	GYP BD	GYP BD	GYP BD	GYP BD	PT/TILE PT	PT	ACC PT	PT	GYP BD	FF F	
324B	RR	TILE	LVP 3	TBB	TBB	TBB	TBB	EPOXY PT	EPOXY PT	EPOXY PT/TILE	EPOXY PT	GYP BD	PT	
325 325B	Room RR	WOOD, PT TILE	LVP 1/3 LVP 3	GYP BD TBB	GYP BD TBB	GYP BD TBB	GYP BD TBB	ACC PT EPOXY	PT EPOXY PT	PT EPOXY PT	PT EPOXY PT	GYP BD GYP BD	FF PT	
326	Room	WOOD, PT	LVP 1/3	GYP BD	GYP BD	GYP BD	GYP BD	PT/TILE PT	PT	ACC PT	PT	GYP BD	FF	
326B	RR	TILE WOOD PT	LVP 3	TBB GYP BD	TBB GVP BD	TBB GYP BD	TBB	EPOXY PT	EPOXY PT	EPOXY PT/TILE	EPOXY PT PT	GYP BD	PT	
327 327B	Room RR	WOOD, PT	LVP 1/3 LVP 3	TBB	GYP BD TBB	TBB	GYP BD TBB	ACC PT EPOXY PT/TILE	PT EPOXY PT	PT EPOXY PT	EPOXY PT	GYP BD GYP BD	FF PT	
328 328B	Room RR	WOOD, PT	LVP 1/3 LVP 3	GYP BD TBB	GYP BD TBB	GYP BD TBB	GYP BD TBB	PT EPOXY PT	PT EPOXY PT	ACC PT EPOXY PT/TILE	PT EPOXY PT	GYP BD GYP BD	FF PT	
329 329B	Room RR	WOOD, PT	LVP 1/3 LVP 3	GYP BD TBB	GYP BD TBB	GYP BD TBB	GYP BD TBB	ACC PT EPOXY	PT EPOXY PT	PT EPOXY PT	PT EPOXY PT	GYP BD GYP BD	FF PT	
	Room	WOOD, PT		GYP BD	GYP BD	GYP BD	GYP BD	PT/TILE PT	PT	ACC PT	PT	GYP BD	FF F	
330B	RR	TILE	LVP 3	TBB	TBB	TBB	TBB	EPOXY PT	EPOXY PT	EPOXY PT/TILE	EPOXY PT	GYP BD	PT	
331 331B	Room RR	WOOD, PT TILE	LVP 1/3 LVP 3	GYP BD TBB	GYP BD TBB	GYP BD TBB	GYP BD TBB	ACC PT EPOXY	PT EPOXY PT	PT EPOXY PT	PT EPOXY PT	GYP BD GYP BD	FF PT	
332	Room	WOOD, PT	LVP 1/3	GYP BD	GYP BD	GYP BD	GYP BD	PT/TILE PT	PT	ACC PT	PT	GYP BD	FF	
332B	RR	TILE WOOD PT	LVP 3	TBB GYP BD	TBB GYP BD	TBB GVP RD	TBB	EPOXY PT	EPOXY PT	EPOXY PT/TILE	EPOXY PT PT	GYP BD	PT FF	
333 333B	Room RR	WOOD, PT	LVP 1/3 LVP 3	TBB	TBB	GYP BD TBB	GYP BD TBB	ACC PT EPOXY PT/TILE	PT EPOXY PT	PT EPOXY PT	EPOXY PT	GYP BD GYP BD	PT	
335 335B	Room RR	WOOD, PT	LVP 1/3 LVP 3	GYP BD TBB	GYP BD TBB	GYP BD TBB	GYP BD TBB	PT EPOXY	PT EPOXY PT	ACC PT EPOXY PT	PT EPOXY PT	GYP BD GYP BD	FF PT	

					Mate	riale			Fin:	ishes		Cellin		
umber	Name	Base Finish	Floor Finish	North	East	South	West	North	East	South	West	Ceiling Material	Ceiling Finish	REMARKS
4.1 4.2	CARTS/STG ELEC	RUBBER 3 RUBBER 3	LVP 3 LVP 3	GYP BD GYP BD	GYP BD GYP BD	GYP BD GYP BD	GYP BD GYP BD	PT PT	PT PT	PT PT	PT PT	GYP BD	PT PT	
4.3	CHUTE ELÉV	RUBBER 3 PER MFG	LVP 3	GYP BD PER MFG	GYP BD PER MFG	GYP BD PER MFG	GYP BD PER MFG	PT FF	PT FF	PT FF	PT FF //	GYP BD PER MFG	PT FF	
4.5	STAIR	RUBBER 3	LVP 2 LANDING	CMU	СМО	CMU	CMU	PT	PT	PT	PT	GYP BD	PT	RUBBER 2 FLOORIN ON STAIRS
4.6	STAIR	RUBBER 3	SEALED CONCRETE LANDING	CMU	CMU	CMU	CMU	PT	PT	PT	PT	CONCRET E	PT	SEALED CONCRETE STAIRS
4.7 /	WATERSI/IDE LAUNCH	TILE	TILE	TBB	TBB	TBB	TBB	EPOXY PT/TILE	EPOXY PT/TILE	EPOXY / PI/IILE	EPOXY PT/TILE	GYP BD	PT	THICK SET TILE FLOOR, SLOPED
4.8	CORR	RUBBER 2	LVP 2/4	GYP BD/MDF			GYP BD/MDF	PT/ACC PT		PT/ACC PT	PT/ACC PT	2X2 ACT/ GYP BD	FF/PT	
4.9	CORR	RUBBER 2	LVP 2/4	GYP BD/MDF	GYP BD/MDF	GYP BD/MDF		PT/ACC PT	PT/ACC PT	PT/ACC PT		2X2 ACT/ GYP BD	FF/PT	
101 01B	Room RR	WOOD, PT TILE	LVP 1/3 LVP 3	GYP BD TBB	GYP BD TBB	GYP BD TBB	GYP BD TBB	ACC PT EPOXY	PT EPOXY PT	PT EPOXY PT	PT EPOXY PT	GYP BD GYP BD	FF PT	
102	Room	WOOD, PT	LVP 1/3	GYP BD	GYP BD	GYP BD	GYP BD	PT/TILE PT	PT	ACC PT	PT	GYP BD	FF	
02B	RR	TILE	LVP 3	TBB	TBB	TBB	TBB	EPOXY PT	EPOXY PT	EPOXY PT/TILE	EPOXY PT	GYP BD	PT	
103 03B	Room RR	WOOD, PT TILE	LVP 1/3 LVP 3	GYP BD TBB	GYP BD TBB	GYP BD TBB	GYP BD TBB	ACC PT EPOXY	PT EPOXY PT	PT EPOXY PT	PT EPOXY PT	GYP BD GYP BD	FF PT	
104	Room	WOOD, PT	LVP 1/3	GYP BD	GYP BD	GYP BD	GYP BD	PT/TILE PT	PT	ACC PT	PT	GYP BD	FF	
04B	RR	TILE	LVP 3	TBB	TBB	TBB	TBB	EPOXY PT	EPOXY PT	EPOXY PT/TILE	EPOXY PT	GYP BD	PT	
105 05B	Room RR	WOOD, PT TILE	LVP 1/3 LVP 3	GYP BD TBB	GYP BD TBB	GYP BD TBB	GYP BD TBB	ACC PT EPOXY	PT EPOXY PT	PT EPOXY PT	PT EPOXY PT	GYP BD GYP BD	FF PT	
406	Room	WOOD, PT	LVP 1/3	GYP BD	GYP BD	GYP BD	GYP BD	PT/TILE PT	PT	ACC PT	PT	GYP BD	FF	
06B	RR ADA Baara	TILE	LVP 3	TBB	TBB	TBB	TBB	EPOXY PT	EPOXY PT	EPOXY PT/TILE	EPOXY PT	GYP BD	PT FF	
107 07B	ADA Room RR	WOOD, PT TILE	LVP 1/3 LVP 3	GYP BD TBB	GYP BD TBB	GYP BD TBB	GYP BD TBB	ACC PT EPOXY PT	PT EPOXY PT/TILE	PT EPOXY PT/TILE	PT EPOXY PT	GYP BD GYP BD	PT	
408	ADA Room	WOOD, PT	LVP 1/3	GYP BD	GYP BD	GYP BD	GYP BD	PT	PT	ACC PT	PT	GYP BD	FF	
08B	RR	TILE	LVP 3	TBB	TBB	TBB	TBB	EPOXY PT/TILE	EPOXY PT	EPOXY PT/TILEPOXY PTE	EPOXY PT/TILE	GYP BD	PT	
109 09B	Room RR	WOOD, PT TILE	LVP 1/3 LVP 3	GYP BD TBB	GYP BD TBB	GYP BD TBB	GYP BD TBB	ACC PT EPOXY	PT EPOXY PT	PT EPOXY PT	PT EPOXY PT	GYP BD	FF PT	
410	Room	WOOD, PT	LVP 1/3	GYP BD	GYP BD	GYP BD	GYP BD	PT/TILE PT	PT	ACC PT	PT	GYP BD	FF	
10B	RR	TILE	LVP 3	TBB	TBB	TBB	ТВВ	EPOXY PT	EPOXY PT	EPOXY PT/TILE	EPOXY PT	GYP BD	PT	
111 11B	Room RR	WOOD, PT TILE	LVP 1/3 LVP 3	GYP BD TBB	GYP BD TBB	GYP BD TBB	GYP BD TBB	ACC PT EPOXY PT/TILE	PT EPOXY PT	PT EPOXY PT	PT EPOXY PT	GYP BD GYP BD	FF PT	
112	Room	WOOD, PT	LVP 1/3	GYP BD	GYP BD	GYP BD	GYP BD	PT	PT	ACC PT	PT	GYP BD	FF	
12B	RR	TILE WOOD, PT	LVP 3	TBB GYP BD	TBB GYP BD	TBB GYP BD	TBB GYP BD	EPOXY PT	EPOXY PT PT	EPOXY PT/TILE PT	EPOXY PT PT	GYP BD	PT FF	
13B	Room RR	TILE	LVP 1/3 LVP 3	TBB	TBB	TBB	TBB	ACC PT EPOXY PT/TILE	EPOXY PT	EPOXY PT	EPOXY PT	GYP BD	PT	
114 14B	Room RR	WOOD, PT TILE	LVP 1/3 LVP 3	GYP BD TBB	GYP BD TBB	GYP BD TBB	GYP BD TBB	PT EPOXY PT	PT EPOXY PT	ACC PT EPOXY	PT EPOXY PT	GYP BD	FF PT	
115	Room	WOOD, PT	LVP 1/3	GYP BD	GYP BD	GYP BD	GYP BD	ACC PT	PT	PT/TILE PT	PT	GYP BD	FF	
15B	RR	TILE	LVP 3	TBB	TBB	TBB	TBB	EPOXY PT/TILE	EPOXY PT	EPOXY PT	EPOXY PT	GYP BD	PT	
116 16B	Room RR	WOOD, PT TILE	LVP 1/3 LVP 3	GYP BD TBB	GYP BD TBB	GYP BD TBB	GYP BD TBB	PT EPOXY PT	PT EPOXY PT	ACC PT EPOXY	PT EPOXY PT	GYP BD	FF PT	
117	Room	WOOD, PT	LVP 1/3	GYP BD	GYP BD	GYP BD	GYP BD	ACC PT	PT	PT/TILE PT	PT	GYP BD	FF	
128 28B	Room RR	WOOD, PT TILE	LVP 1/3 LVP 3	GYP BD TBB	GYP BD TBB	GYP BD TBB	GYP BD TBB	PT EPOXY	PT EPOXY	ACC PT EPOXY	PT EPOXY	GYP BD GYP BD	FF PT	
129	ADA Room	WOOD, PT	LVP 1/3	GYP BD	GYP BD	GYP BD	GYP BD	PT/TILE ACC PT/TILE	PT/TILE PT	PT/TILE PT	PT/TILE PT/TILE	GYP BD	FF	
29B	RR	TILE	LVP 3	TBB	TBB	TBB	TBB	EPOXY PT	EPOXY PT	EPOXY PT/TILE	EPOXY PT/TILE	GYP BD	PT	
30B	Room RR	WOOD, PT TILE	LVP 1/3 LVP 3	GYP BD TBB	GYP BD TBB	GYP BD TBB	GYP BD TBB	PT EPOXY PT	PT EPOXY PT	ACC PT EPOXY PT/TILE	PT EPOXY PT	GYP BD GYP BD	FF PT	
31 31B	Room RR	WOOD, PT	LVP 1/3 LVP 3	GYP BD TBB	GYP BD TBB	GYP BD TBB	GYP BD TBB	ACC PT/TILE EPOXY PT	PT/TILE EPOXY	PT/TILE PT EPOXY	PT EPOXY PT	GYP BD GYP BD	FF PT	
31B 	Room	WOOD, PT	LVP 3	GYP BD	GYP BD	GYP BD	GYP BD	PT EPOXY P1	PT/TILE PT	PT/TILE ACC PT	PT	GYP BD	FF FF	
32B	RR	TILE	LVP 1/3	TBB	TBB	TBB	TBB	EPOXY PT	EPOXY PT	EPOXY PT/TILE	EPOXY PT	GYP BD	PT	
	1	WOOD, PT	LVP 1/3	GYP BD	GYP BD	GYP BD	GYP BD			PT	PT	GYP BD	FF	

NOTE: ALL GYPSUM BOARD SHALL BE TYPE 'X' 6-22 REV 3

A NEW HOTEL FOR:

TERRA DEVELOPMENT LLC

TWIN FALLS, ID

ROOM FINISH SCHEDULE 3RD & 4TH

LICENSED ARCHITECT AR-985708

DATE: 5/6/2022

NM RCR


Drawn Checked

Laughlin Ricks Architecture

architecture/planning

134 3RD AVE. E. * Twin Falls, Idaho 83301
PHONE: (208) 736-8050

A9-5

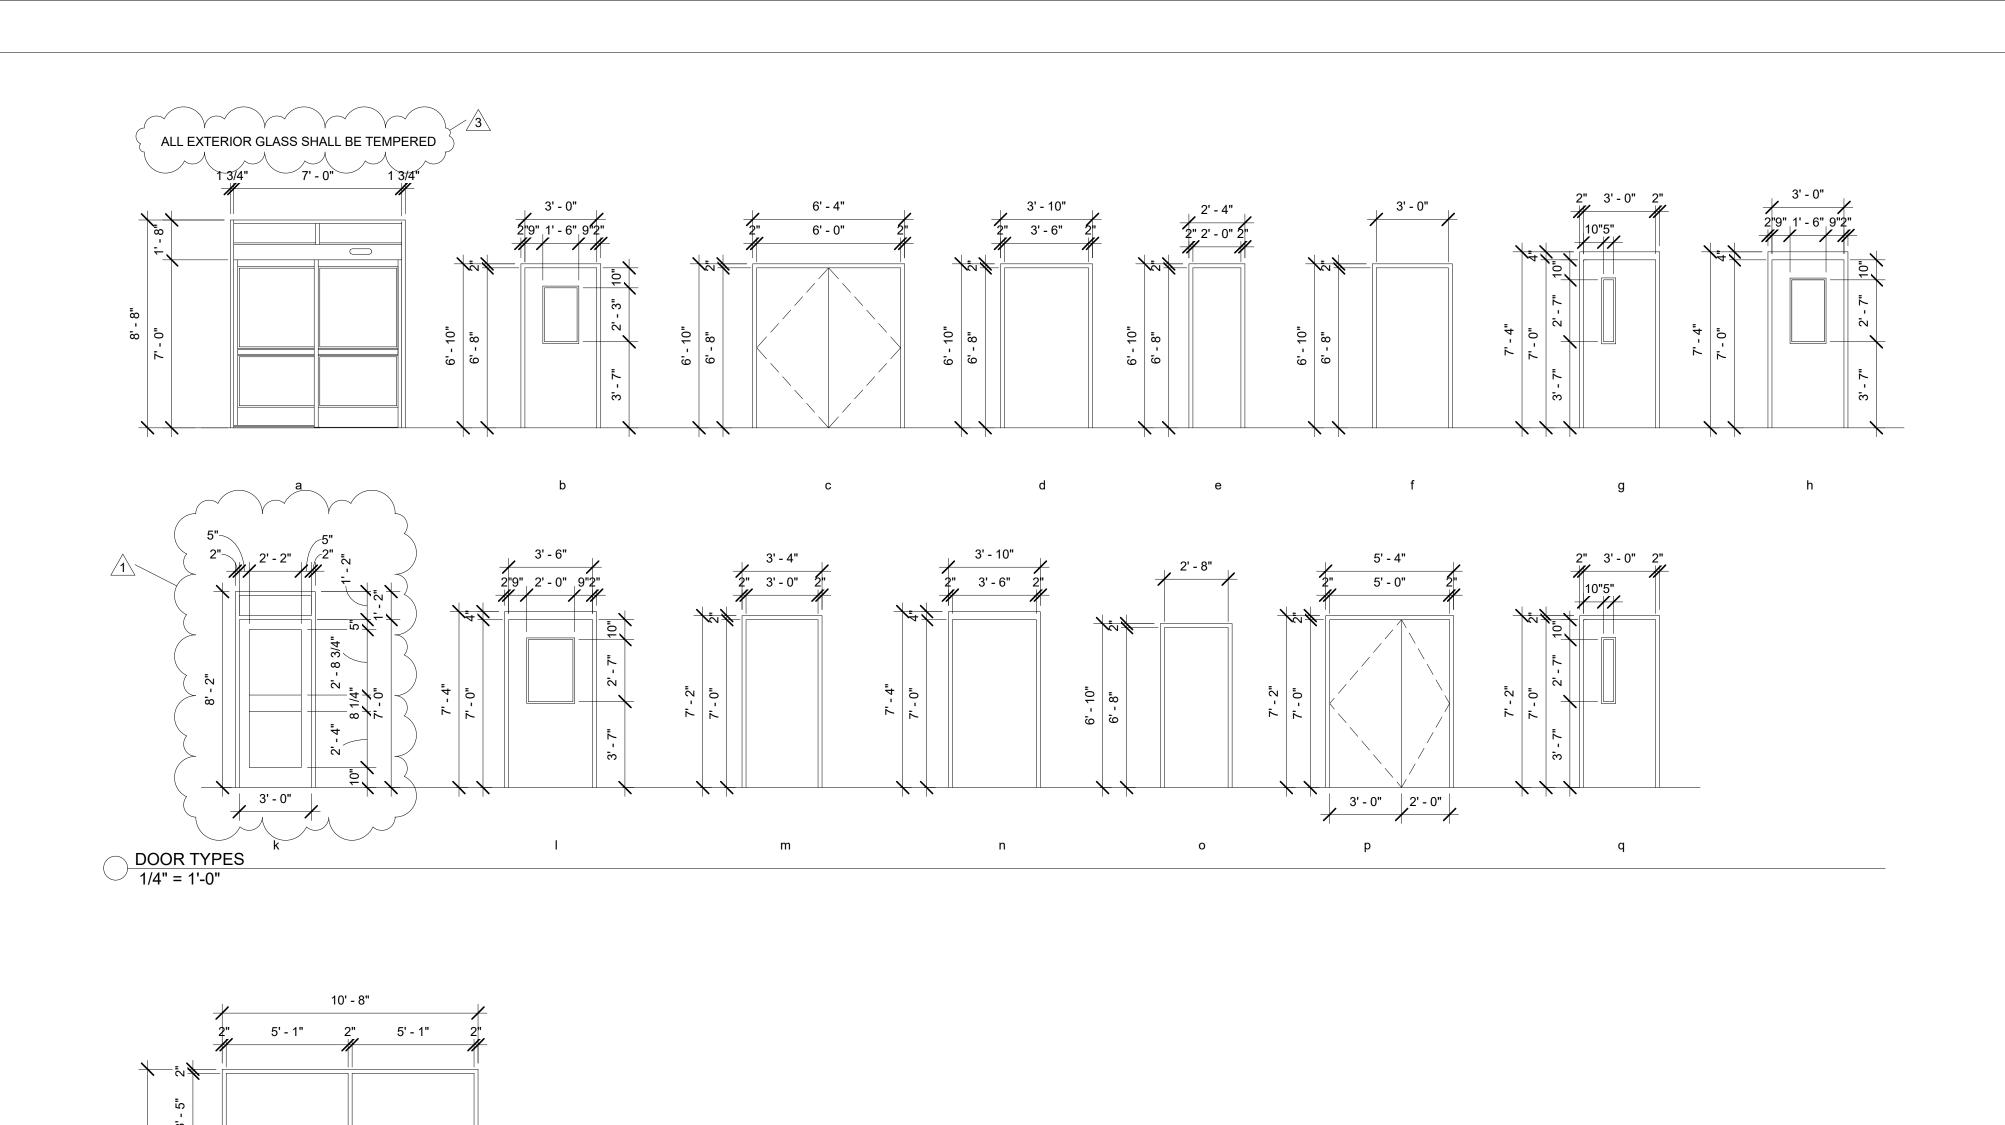

6' - 0" 3" 2' - 7 1/2" 2' - 7 1/2" 3"

4" MAX OPENING

C

2" 2' - 3" 2" 2' - 3" 2"

 \bigcirc B

TEMPERED GLASS

WINDOW TYPES 1/4" = 1'-0"

A

EMERGENCY ESCAPE & RESUÉ OPENINGS ARE NOT REQUIRED IN R-1 OCCUPANCIES PER SECTION 1030 PROVIDE SYNTHETIC MARBLE SILLS AT ALL GUESTROOM WINDOWS ALL EXTERIOR GLASS SHALL BE TEMPERED


Architecture ===architecture/planning= 134 3RD AVE. E. * Twin Falls, Idaho 83301 PHONE: (208) 736-8050 Laughlin Ricks

A NEW HOTEL FOR:
TERRA DEVELOPMENT LLC
TWIN FALLS, ID
DOOR & WINDOW TYPES

LICENSED ARCHITECT AR-985708

R. COLBY/RICKS STATE OF IDAHO 5/6/2022


DATE: 5/6/2022 RCR

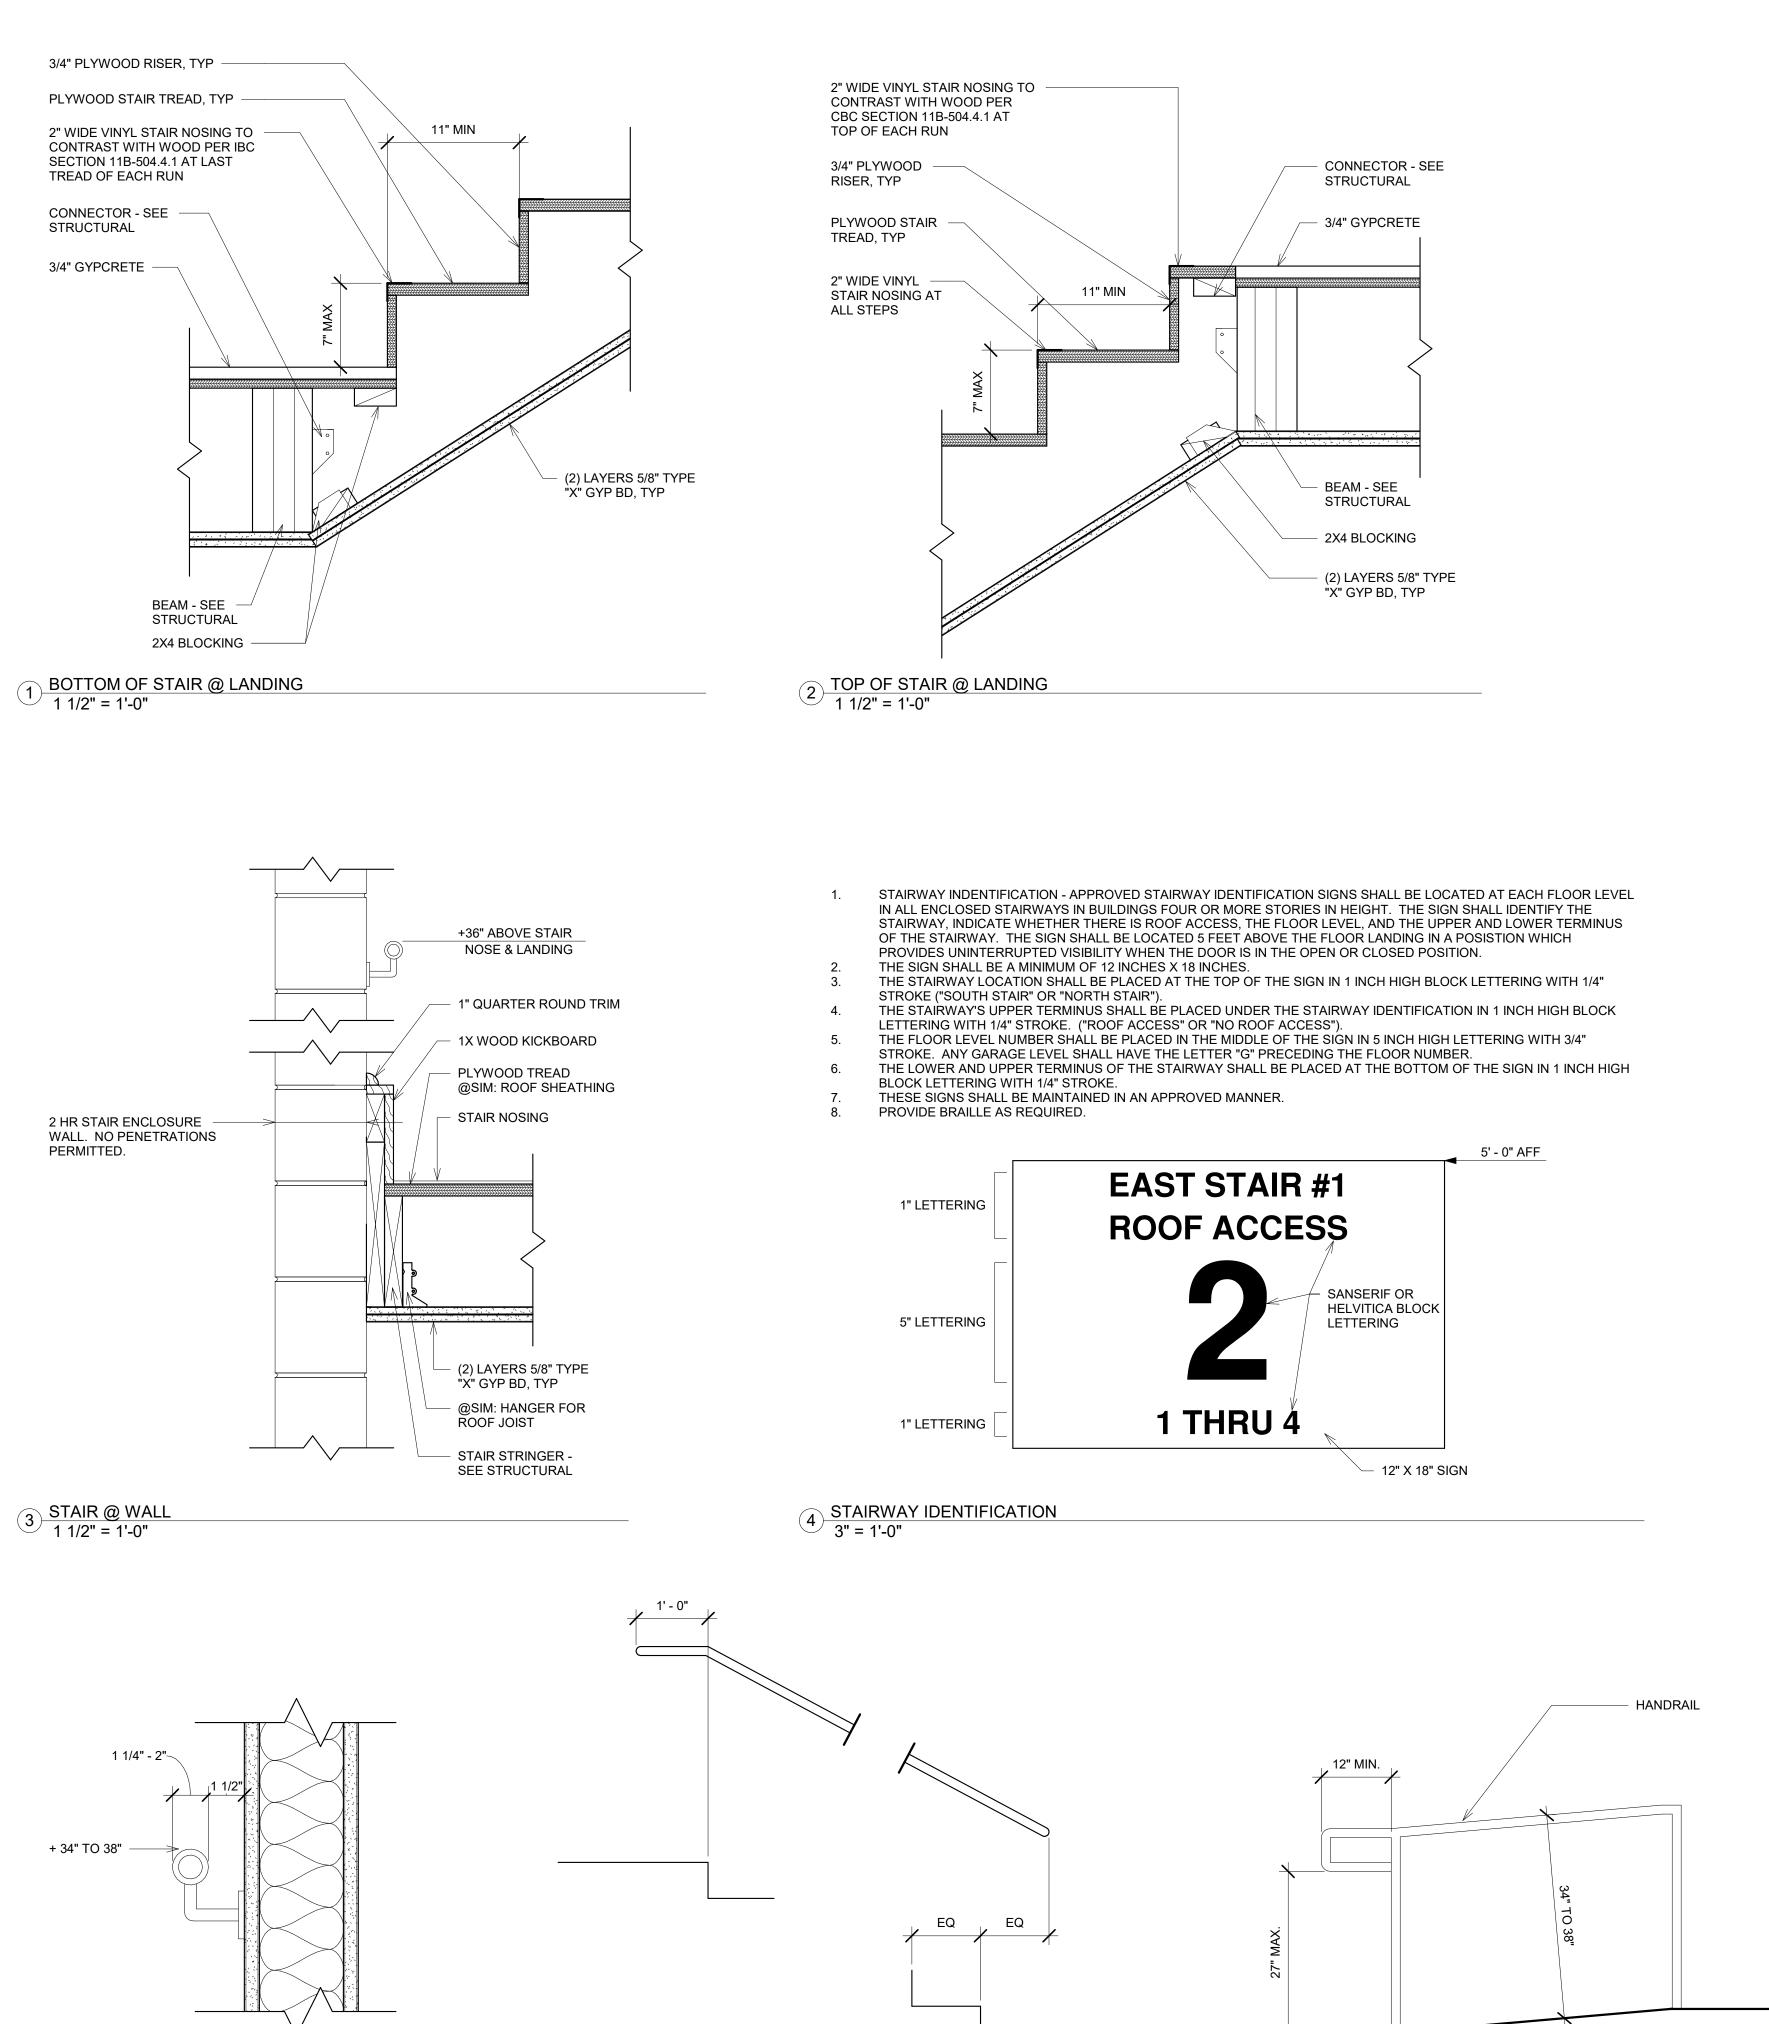

7 HANDRAIL EXTENSION @ RAMP 3/4" = 1'-0"

6 STAIR EXTENSIONS
3/4" = 1'-0"

5 HANDRAIL TO BUILDING DETAIL
3" = 1'-0"

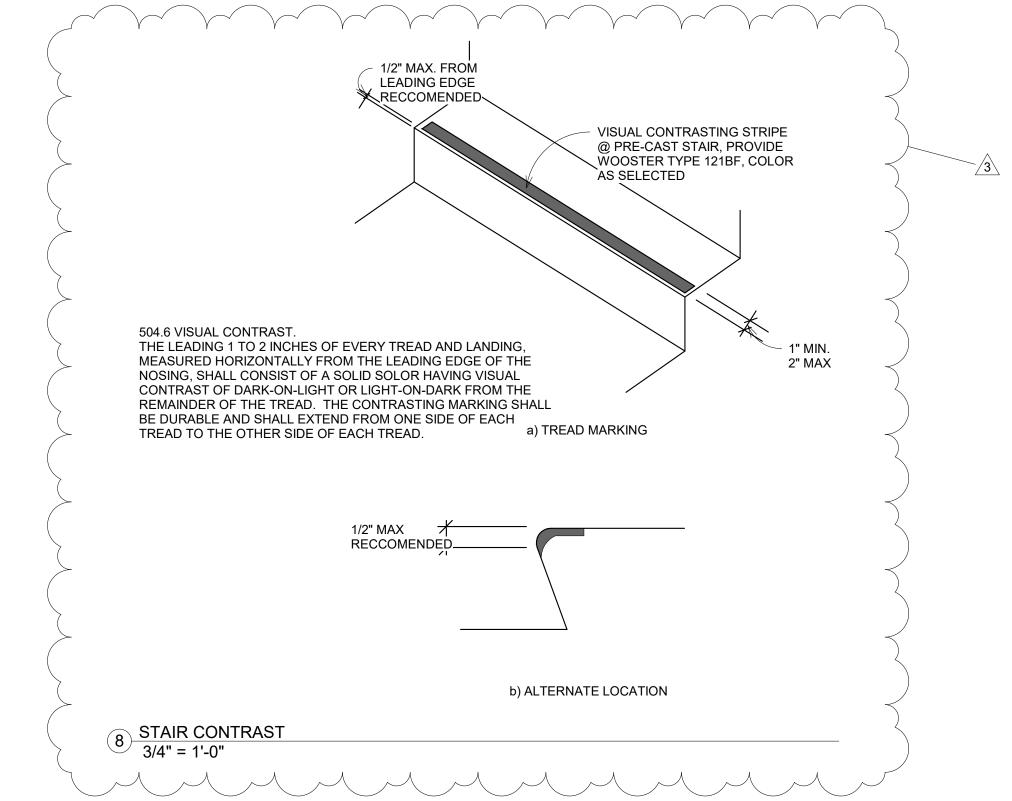

A NEW HOTEL FOR:
TERRA DEVELOPMEN
TWIN FALLS, ID
DETAILS - STAIR DET

STAIR DETAIL


LICENSED ARCHITECT AR-985708

R. COLBY/RICKS STATE OF IDAHO

5/6/2022

Architecture =architecture/planning
134 3RD AVE. E. * Twin Falls, Idaho 8330
PHONE: (208) 736-8050 aughlin Ricks


DATE: 5/6/2022

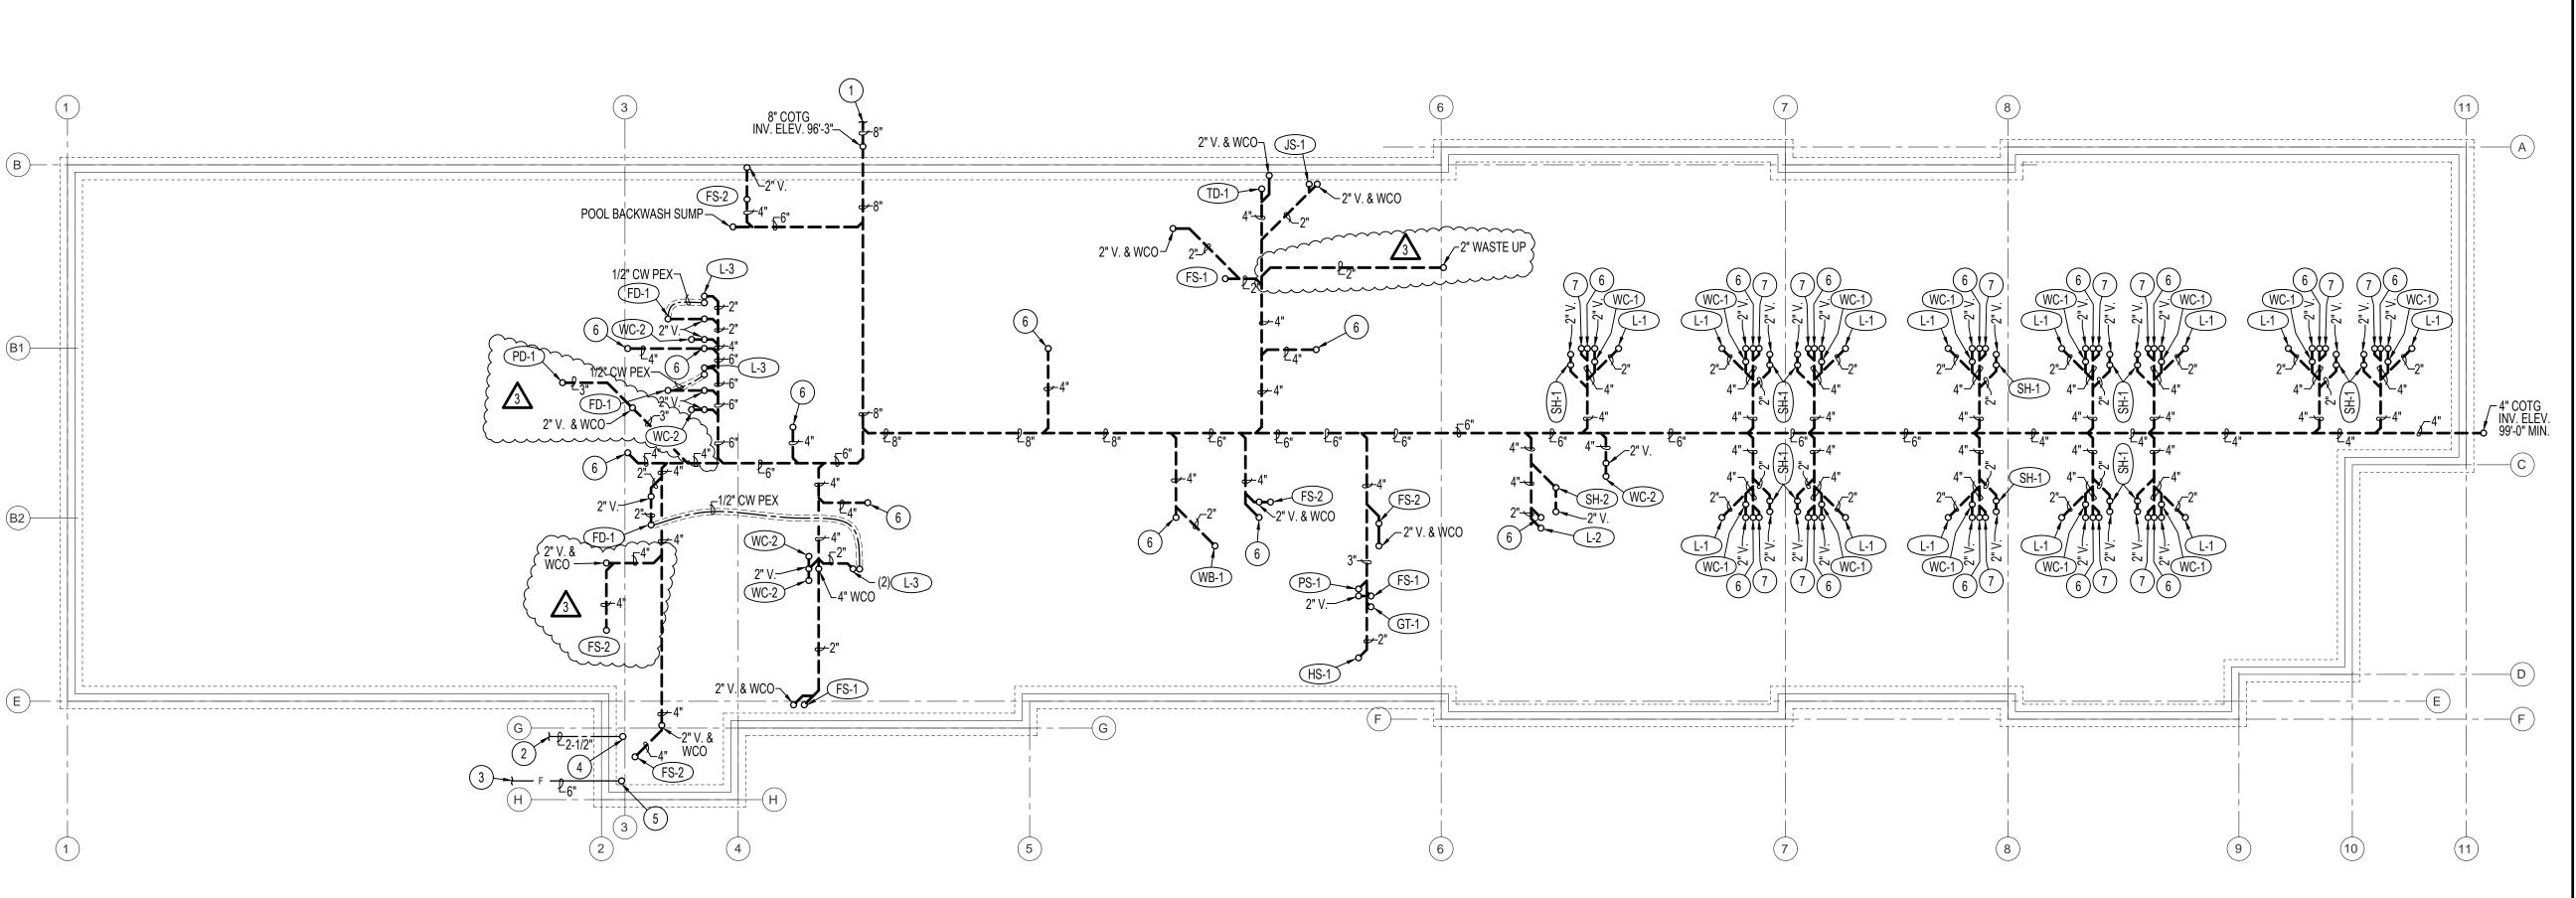


FOUNDATION - PLUMBING FLOOR PLAN


SCALE: 3/32" = 1'-0"

North

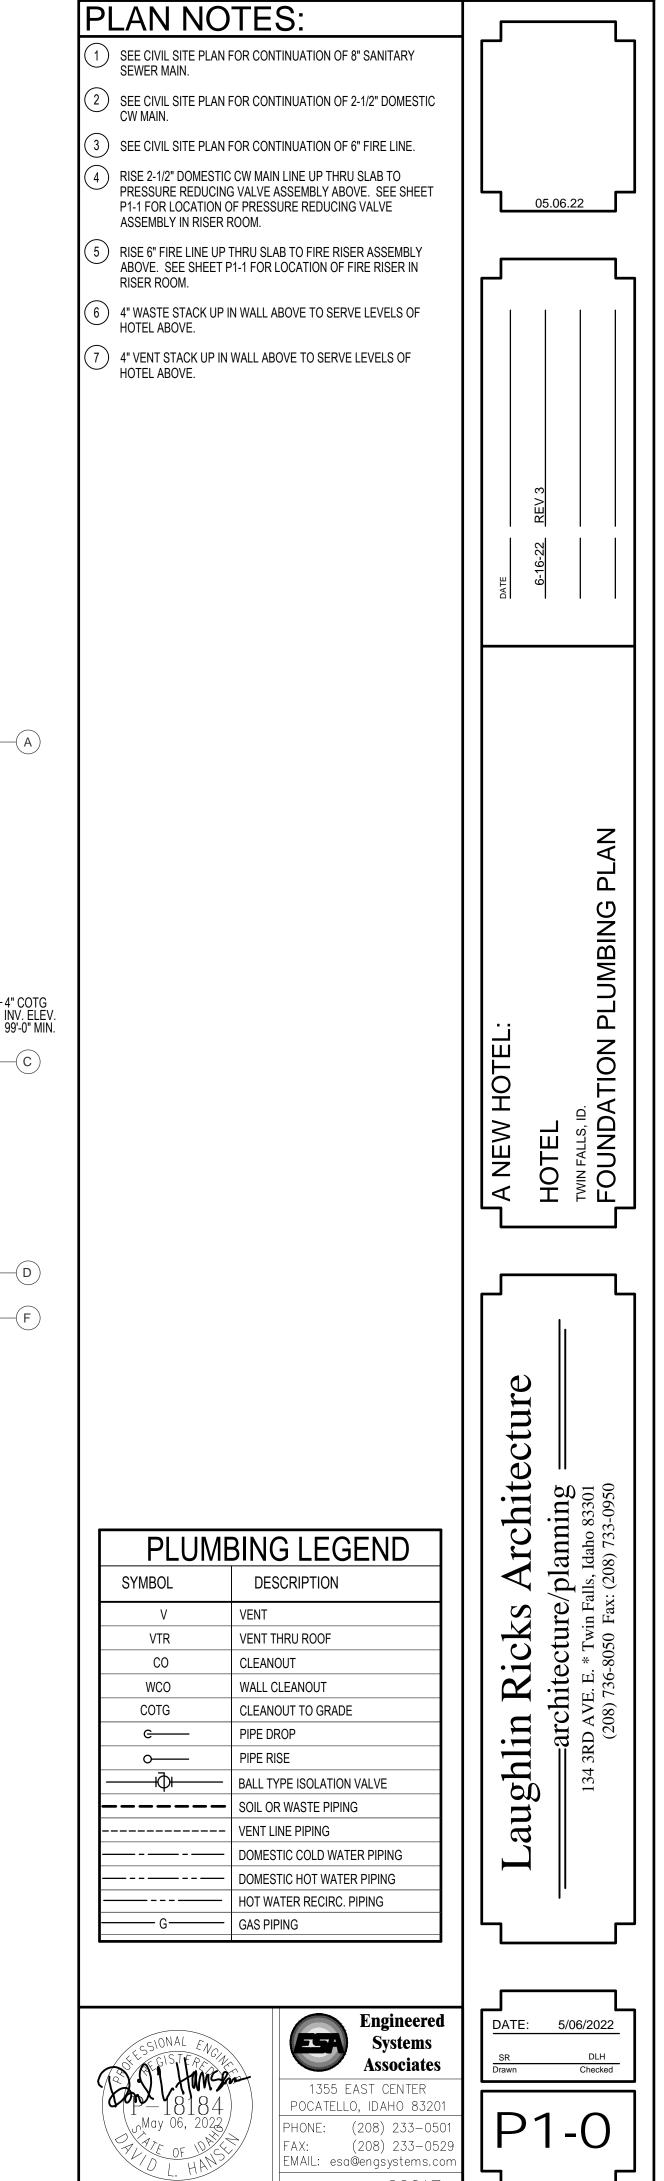



ESA JOB NUMBER: 2201

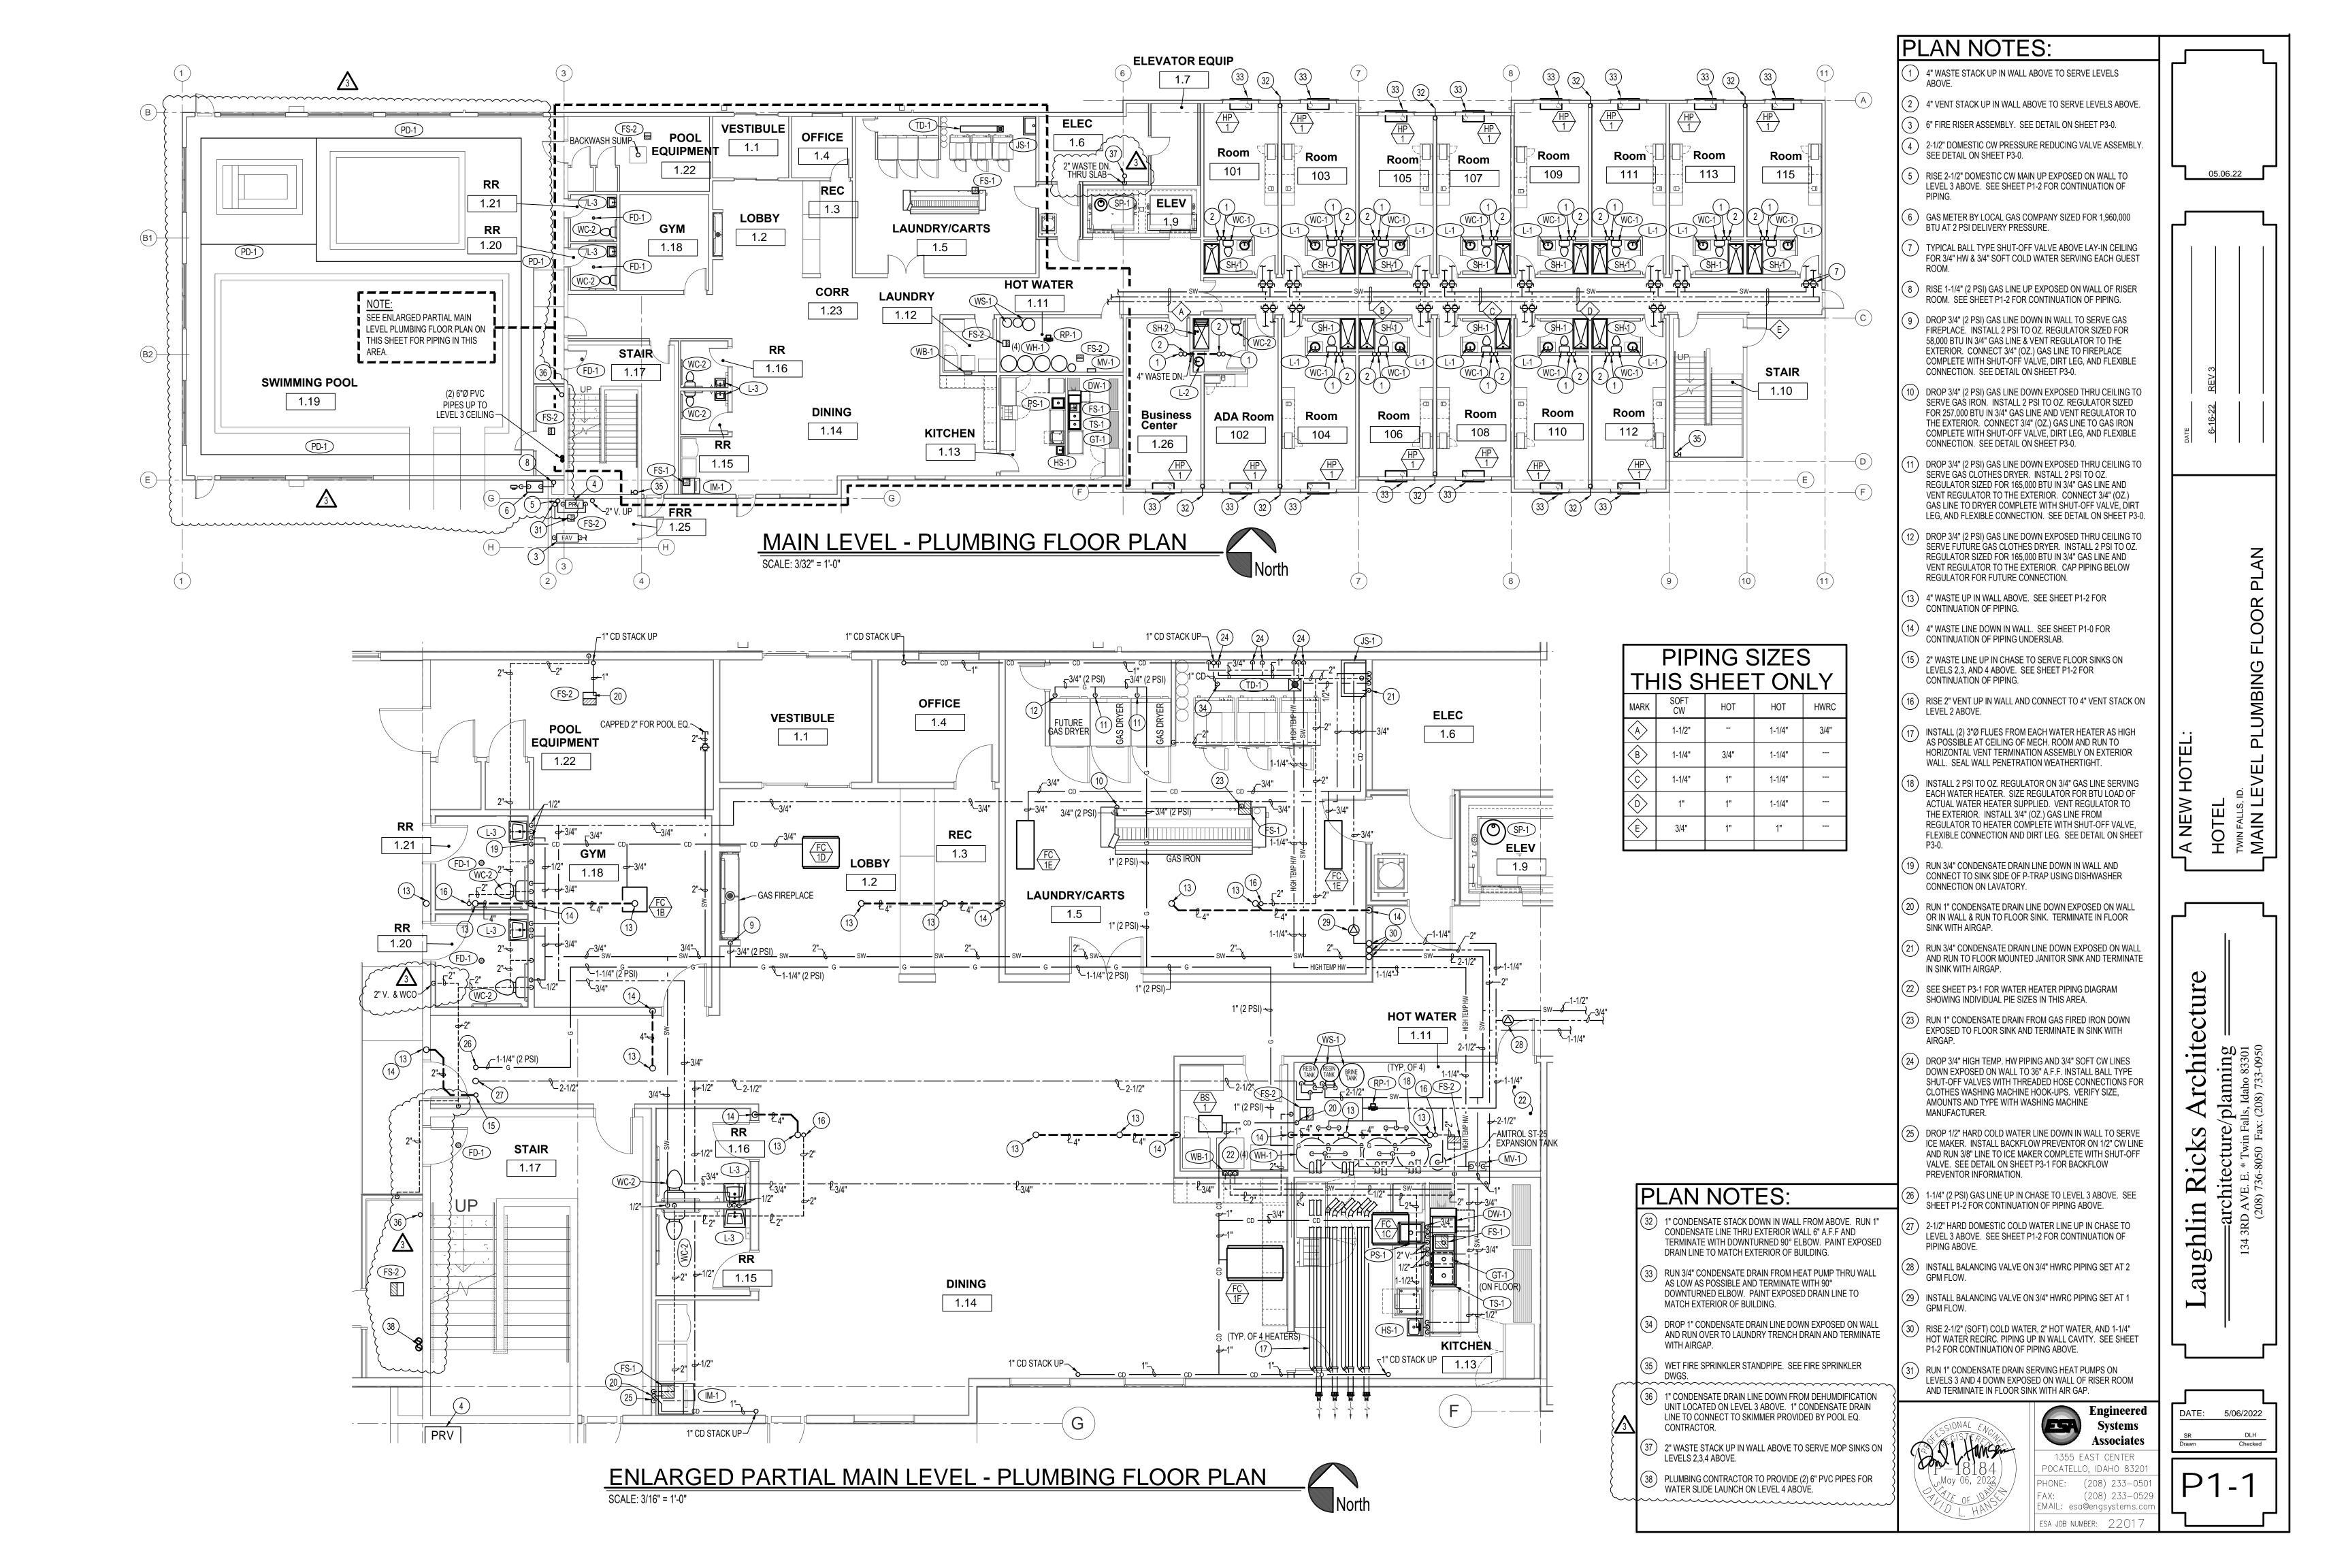


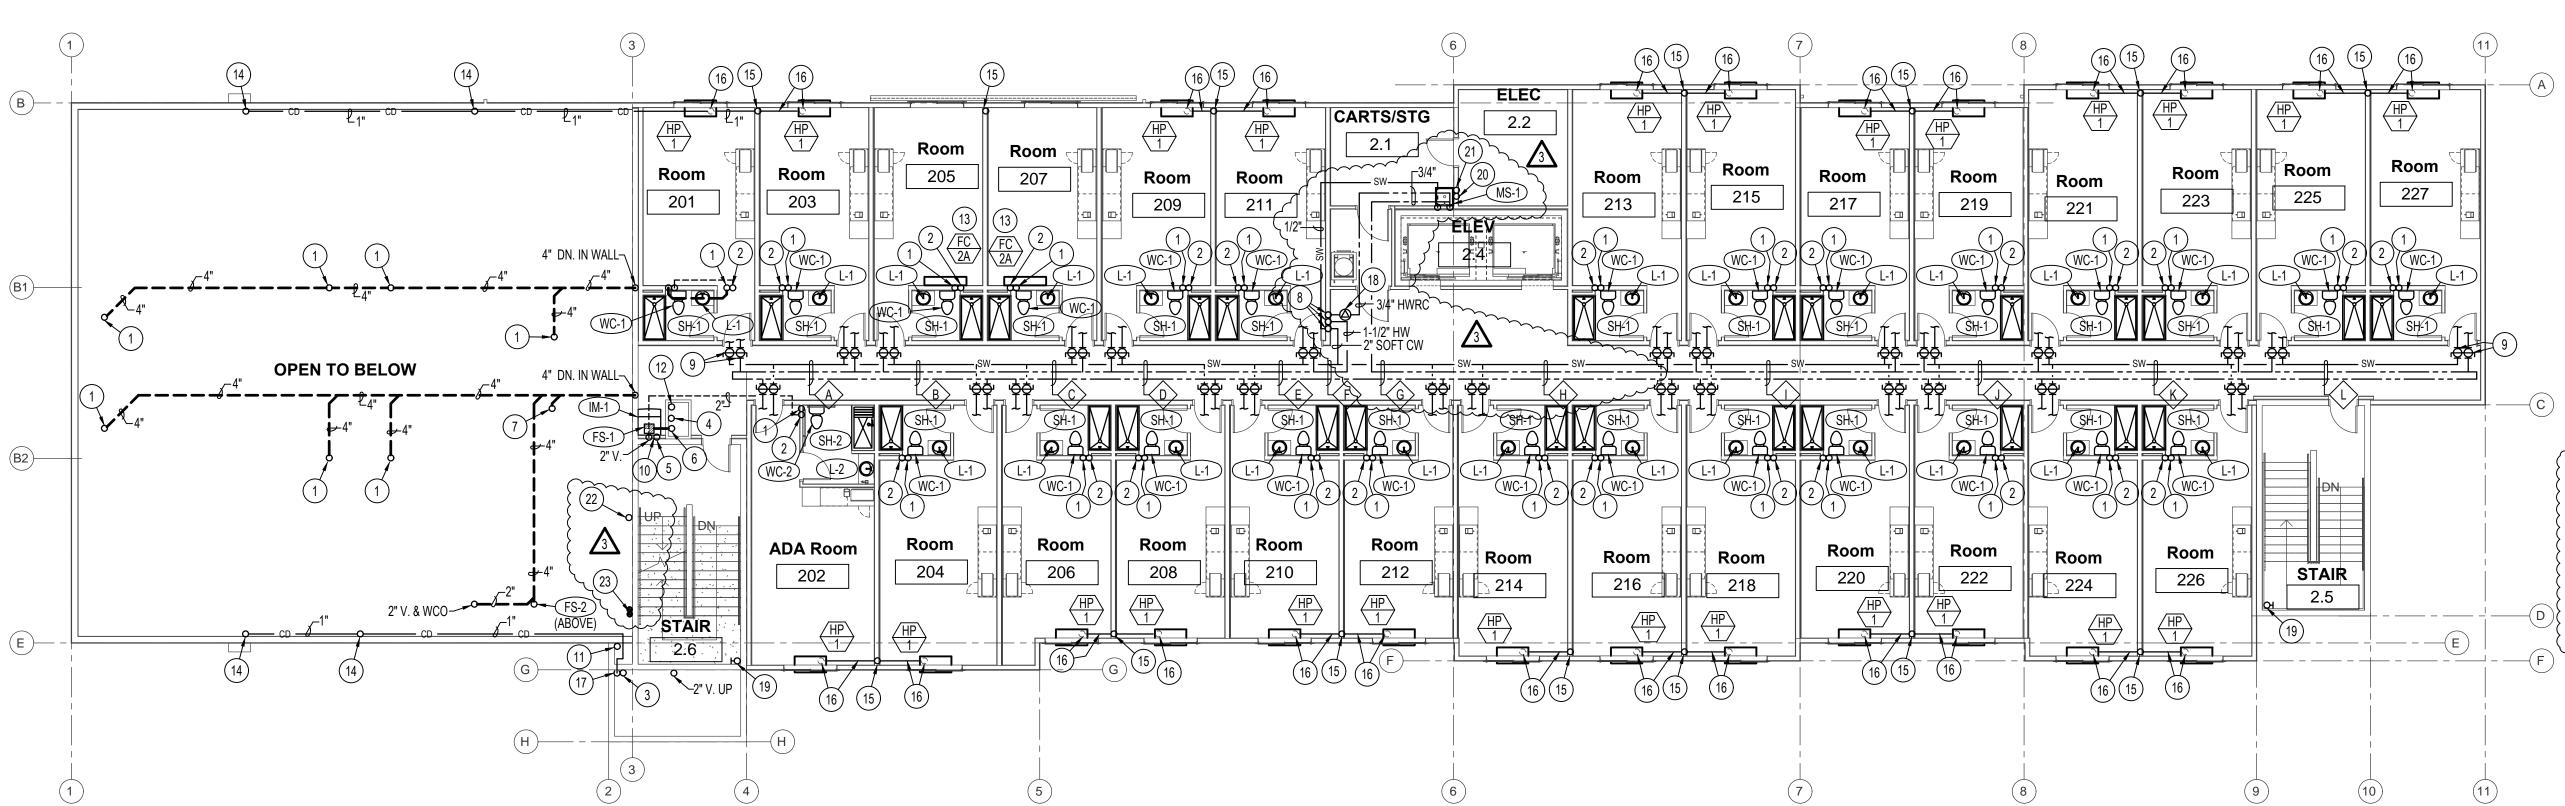



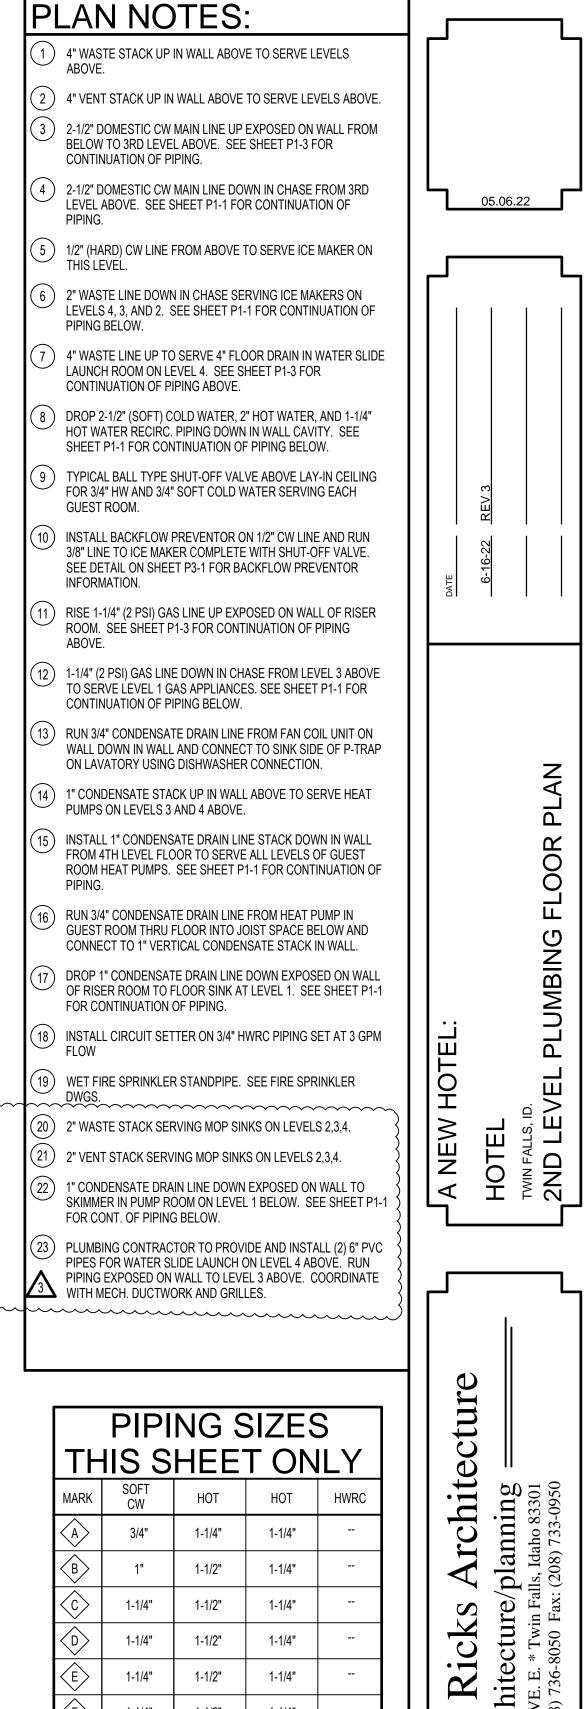

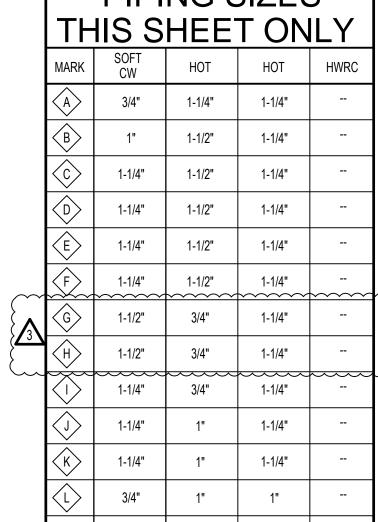


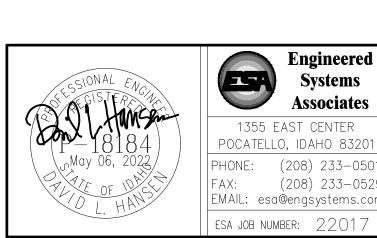




DATE: 5/06/2022 1355 EAST CENTER POCATELLO, IDAHO 83201 (208) 233-050


aughlin

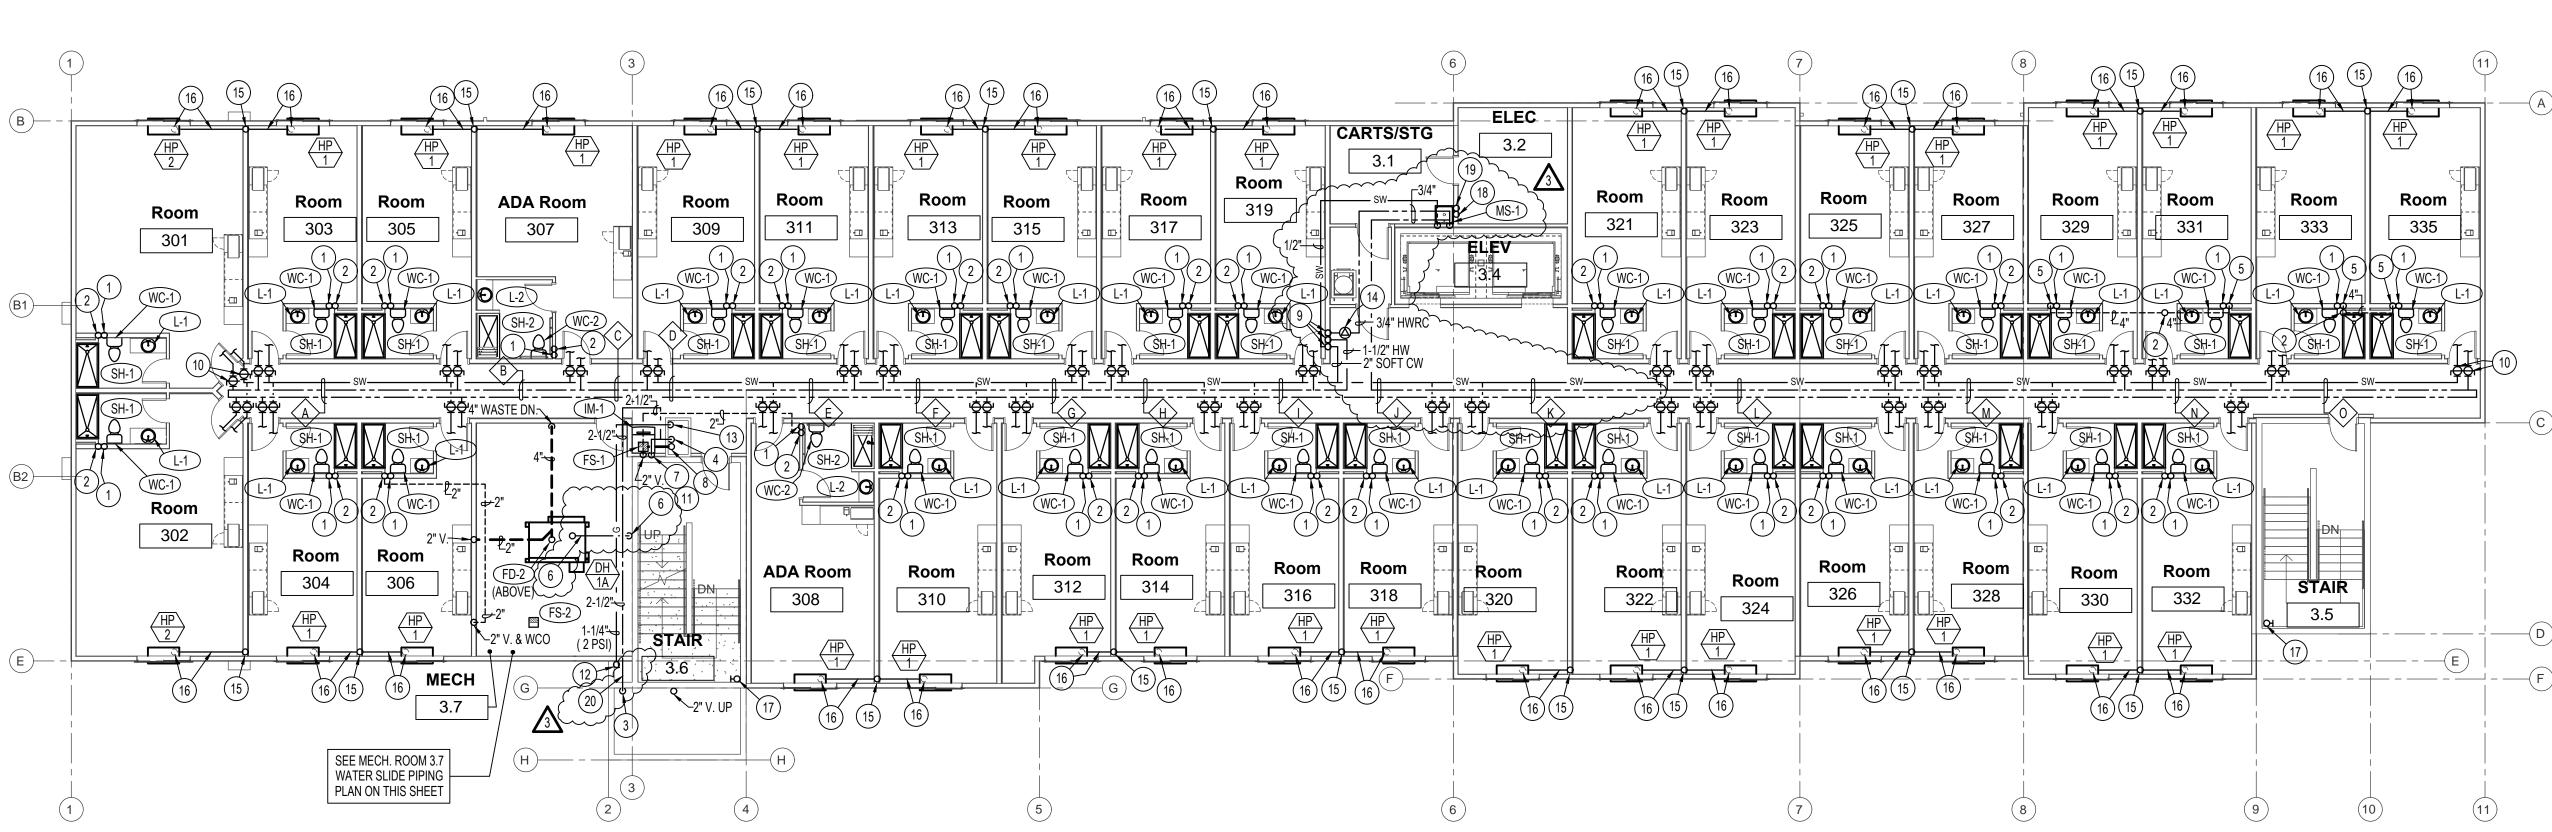






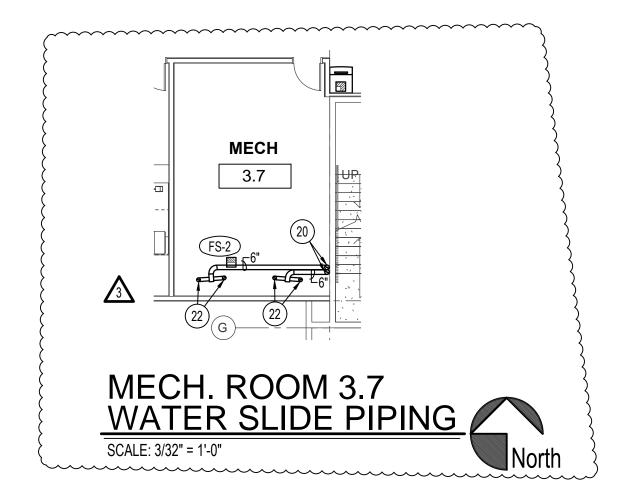

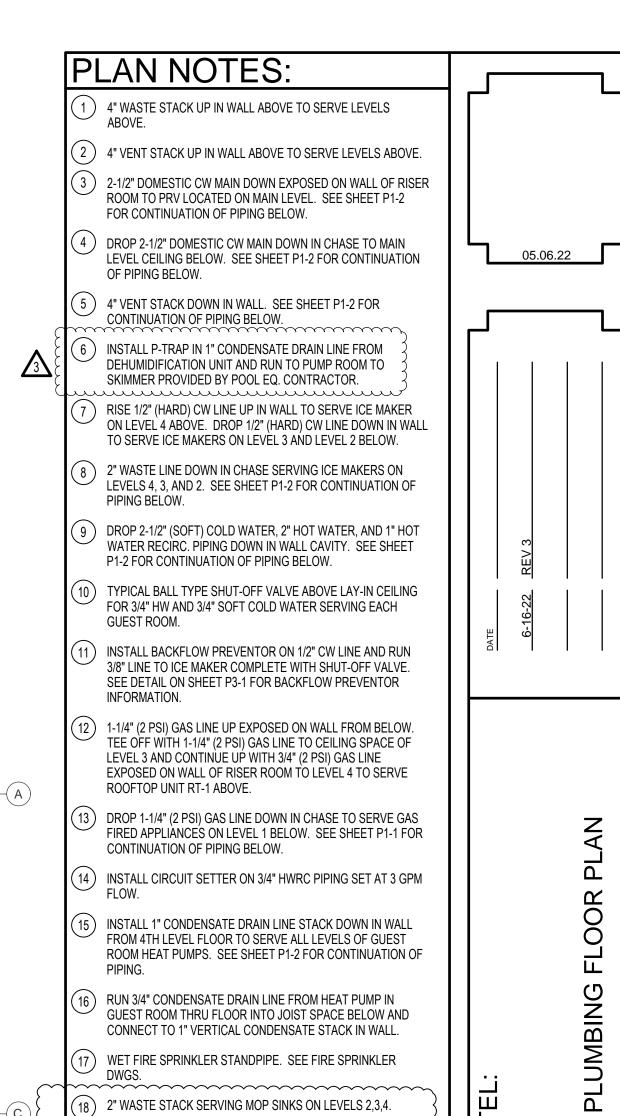

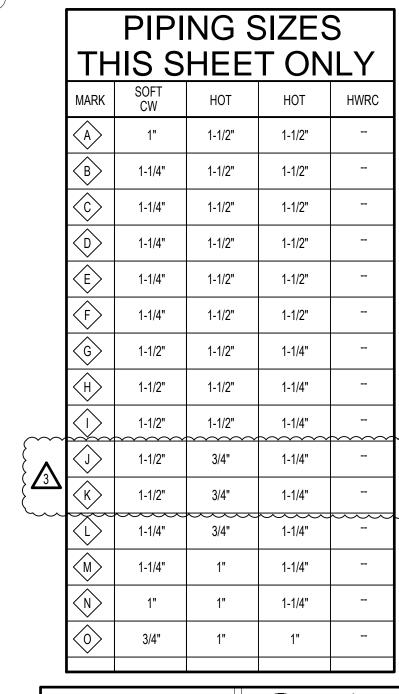

17) WET FIRE SPRINKLER STANDPIPE. SEE FIRE SPRINKLER

18) 2" WASTE STACK SERVING MOP SINKS ON LEVELS 2,3,4.

19) 2" VENT STACK SERVING MOP SINKS ON LEVELS 2,3,4.

PROVIDE HEAT TO SURROUND PIPE.

20) PROVIDE 6" PVC SLEEVE FOR DOMESTIC CW LINE TO RUN THRU COLD CHASE. LEAVE SLEEVE OPEN ON BOTH ENDS TO

21) PLUMBER TO INSTALL (2) 6" PVC PIPES FROM LEVEL 1 PUMP ROOM TO LEVEL 3 CEILING.


TEE OFF OF 6" MAIN WITH (2) 4" PVC PIPES RISING UP TO CONNECT TO WATER SLIDE LAUNCH ON LEVEL 4 ABOVE. SEAL

PIPING AT CEILING / FLOOR PENETRATION WATER TIGHT.


HOTI TWIN FAL

Architecture


aughlin Ricks

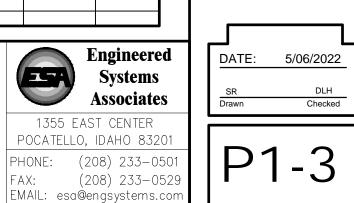

ESA JOB NUMBER: 2201

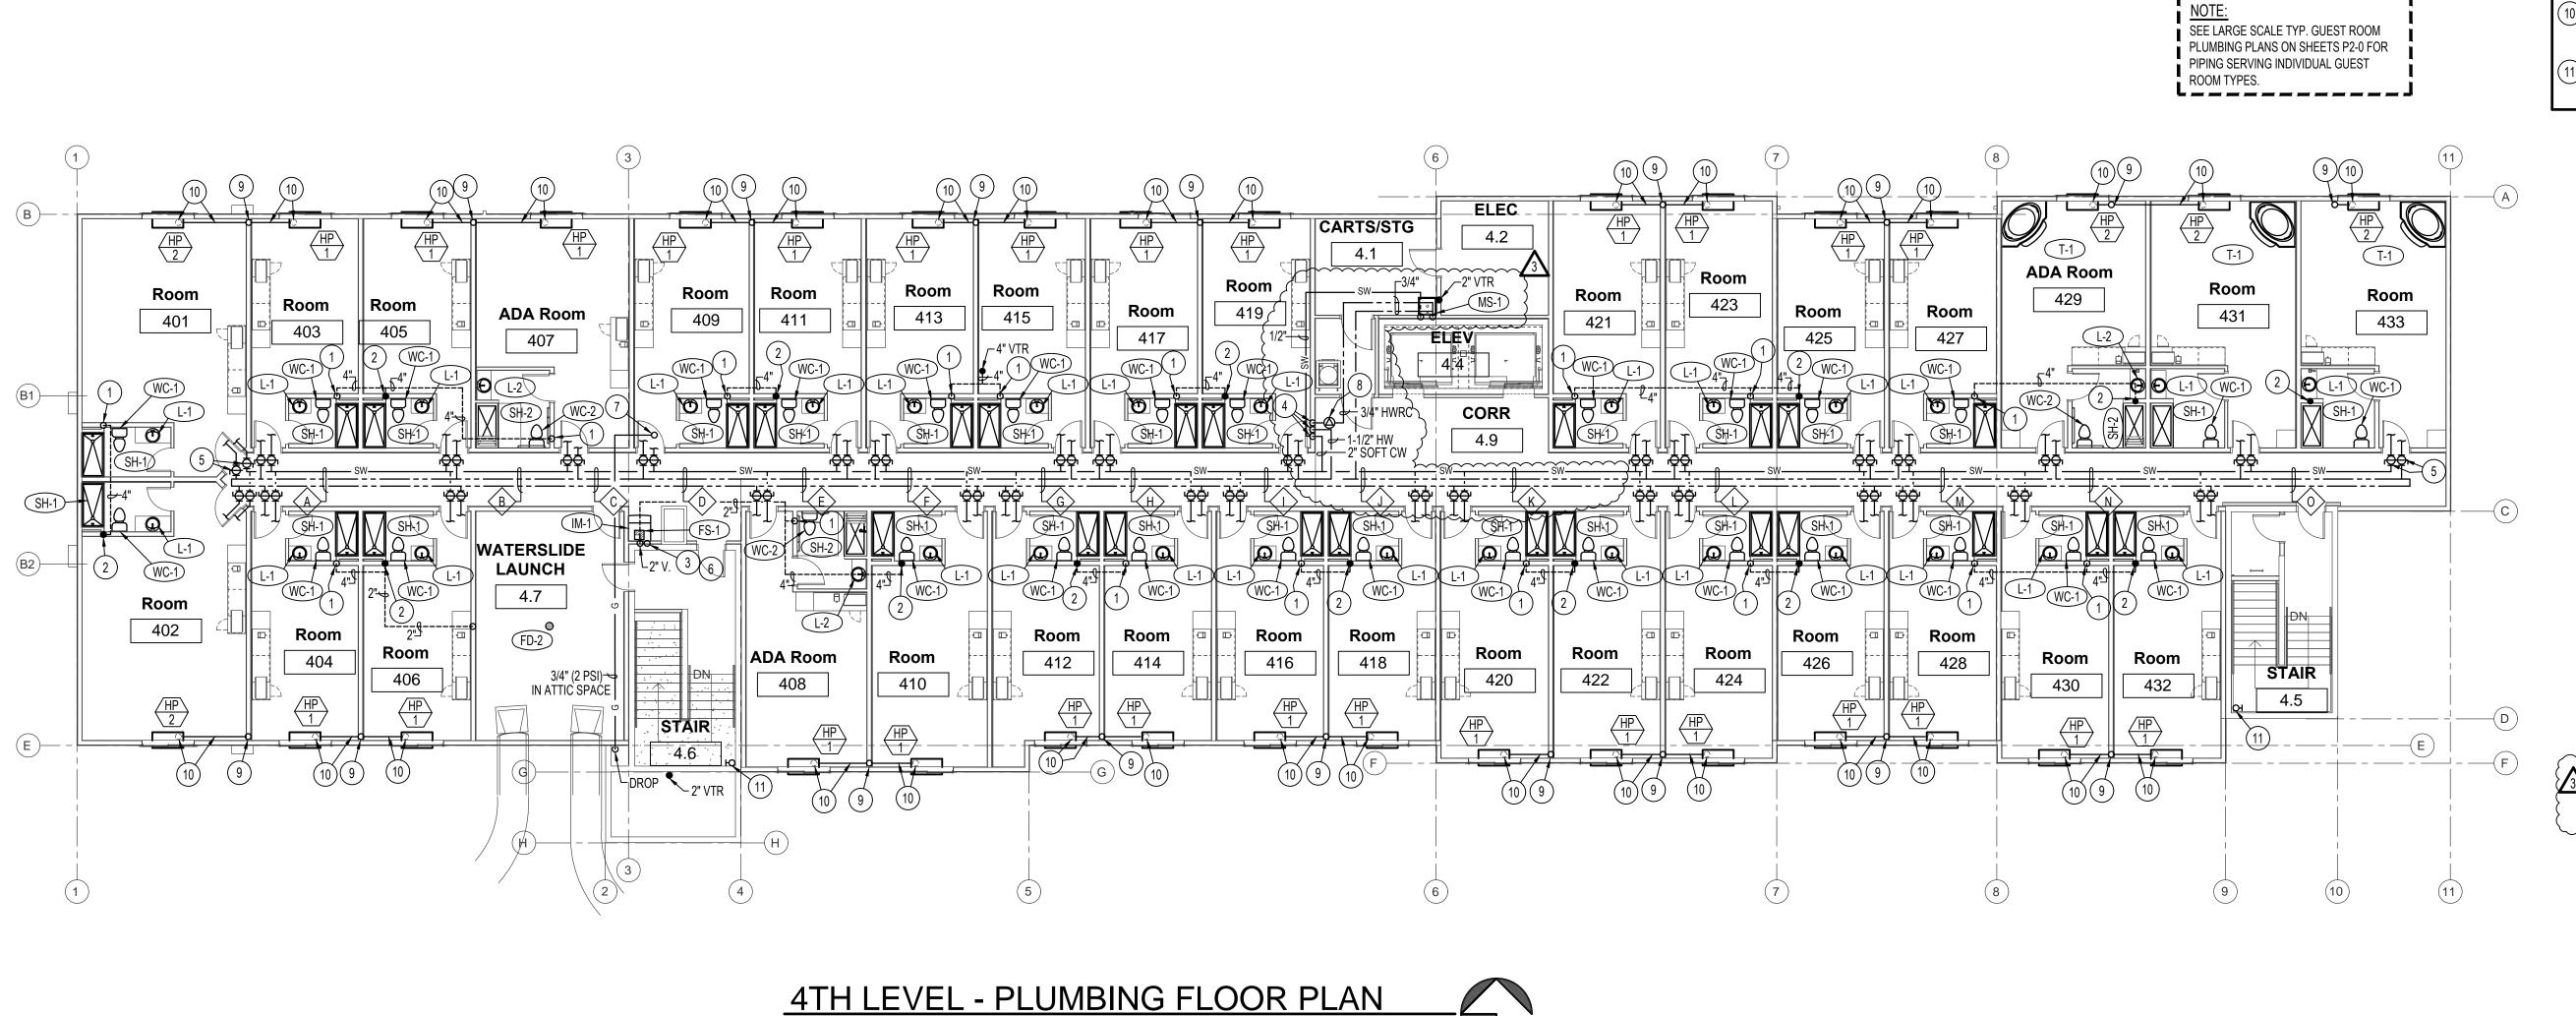


SCALE: 3/32" = 1'-0"

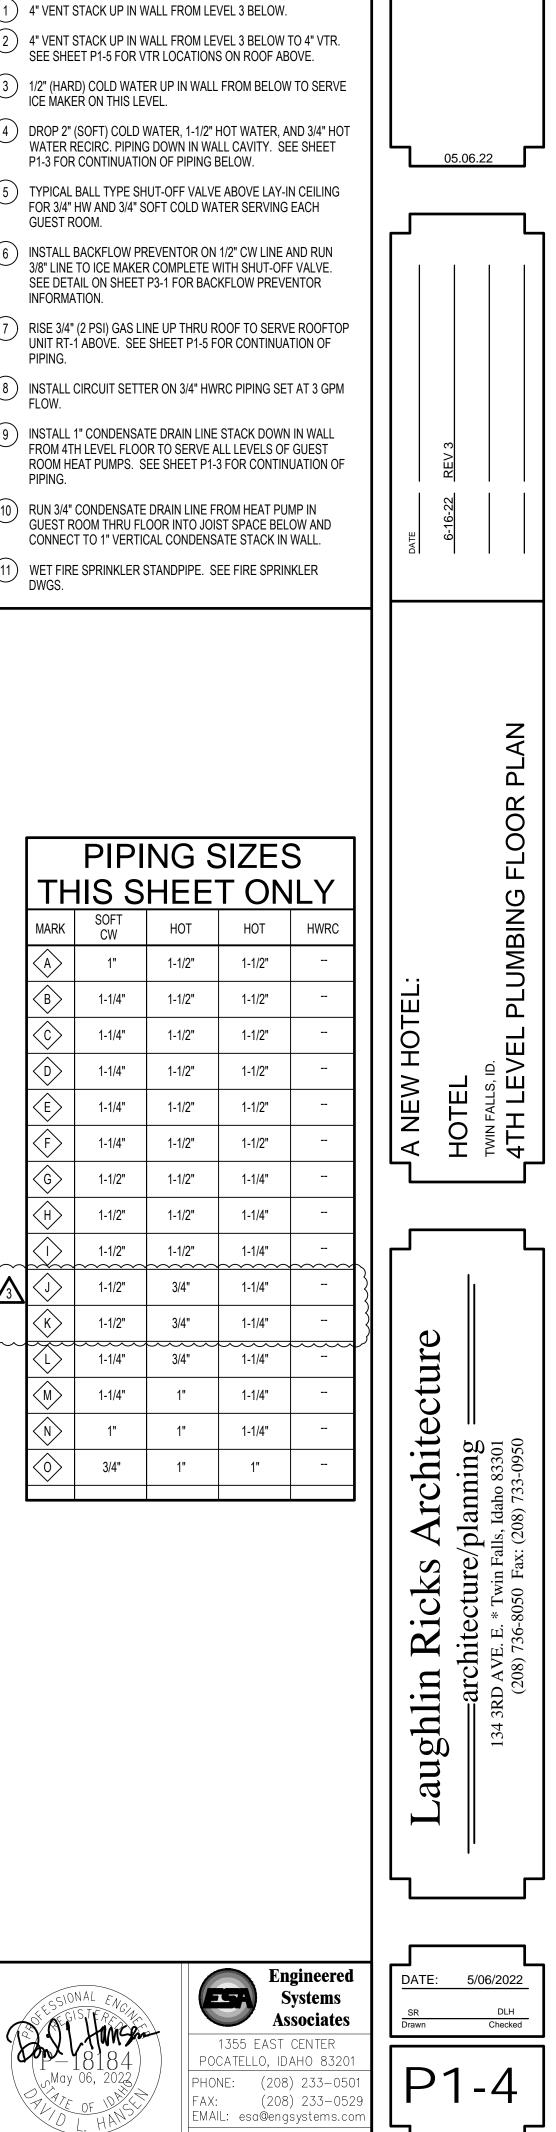


ESA JOB NUMBER: 22017


PLAN NOTES:

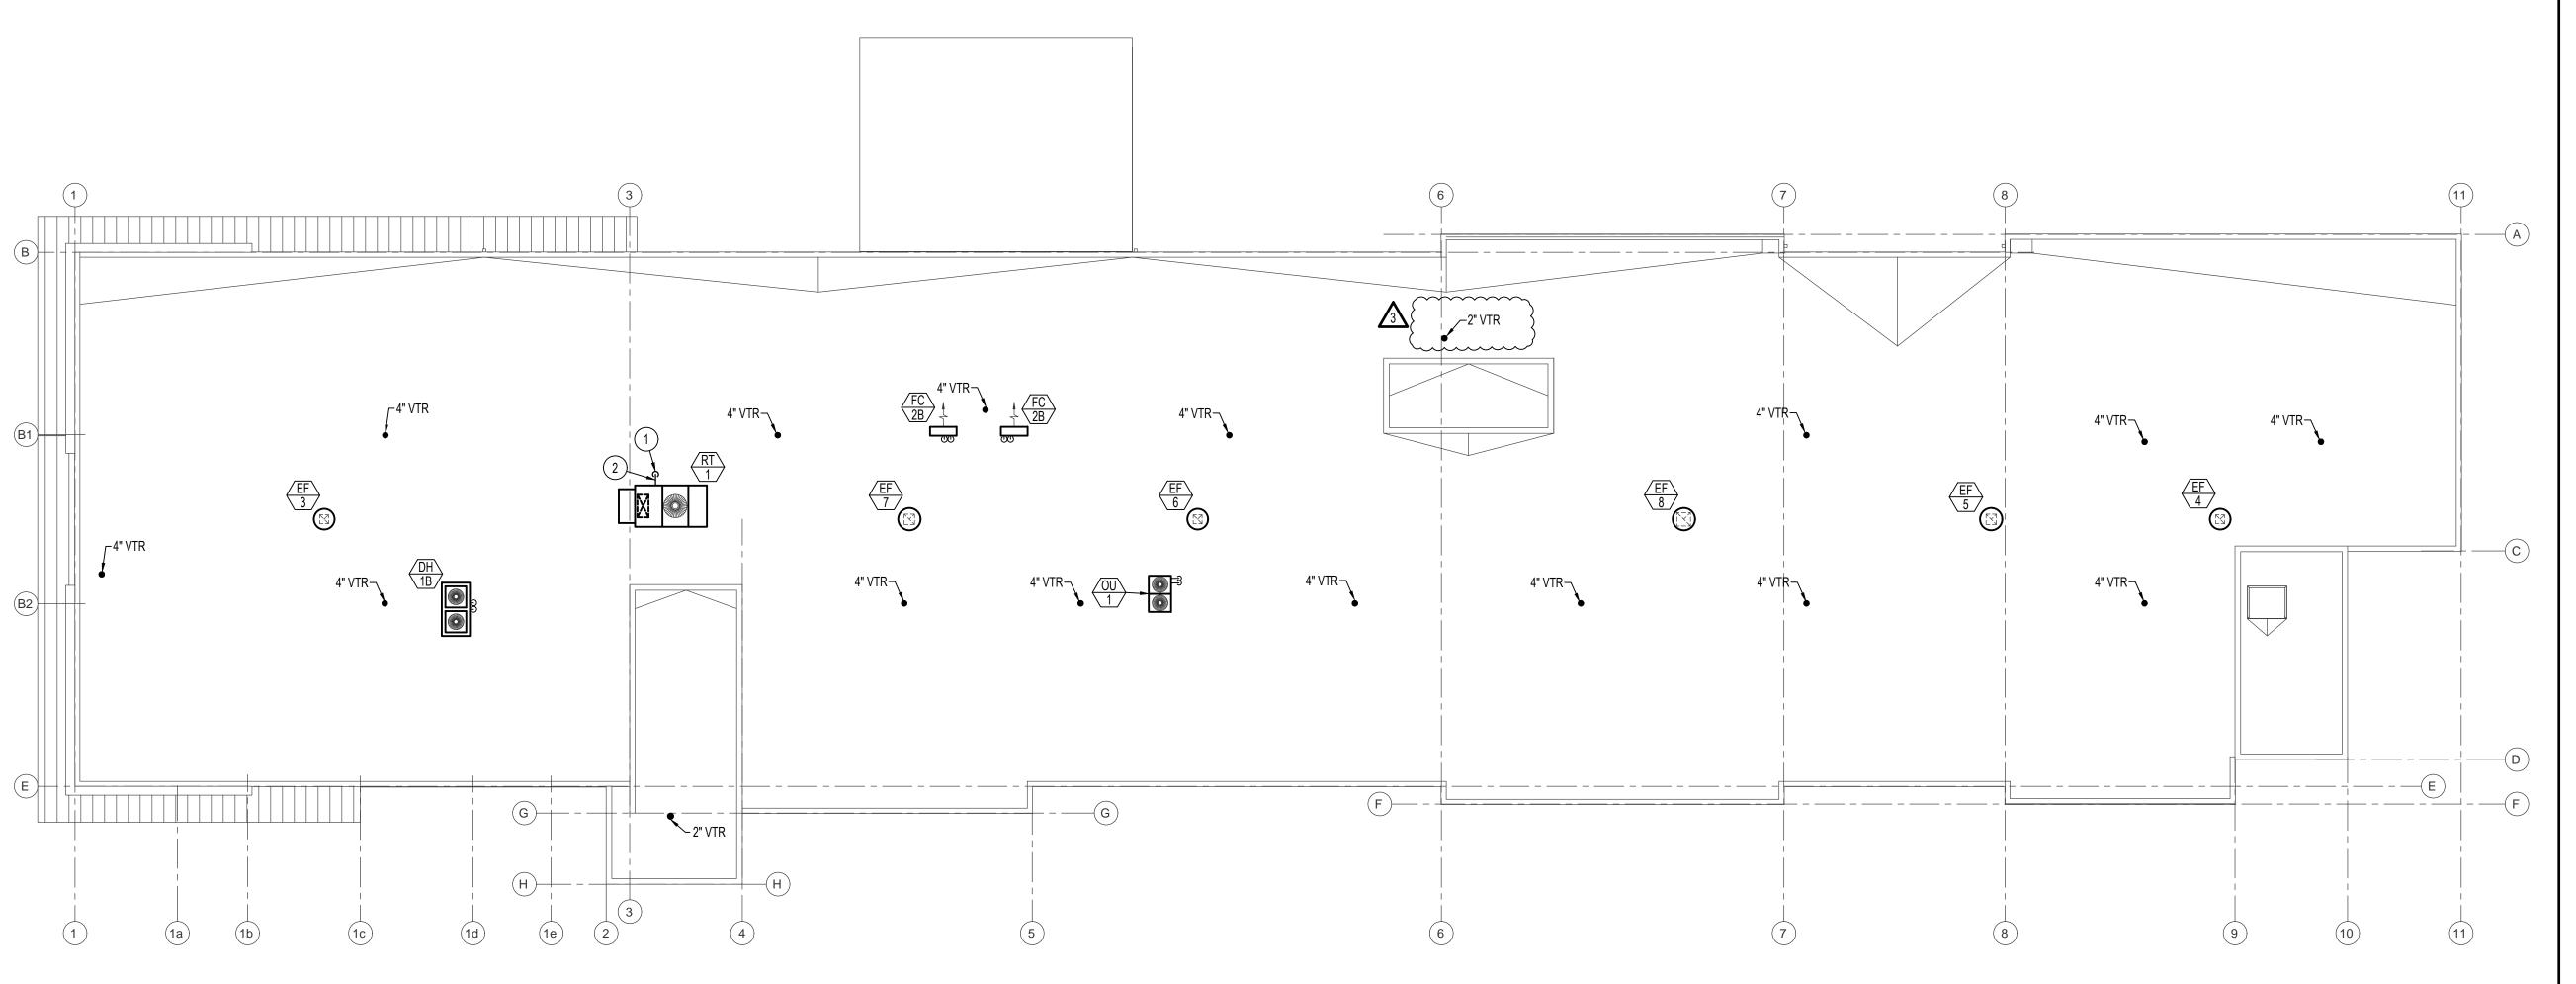


ROOF LEVEL - PLUMBING FLOOR PLAN

SCALE: 3/32" = 1'-0"

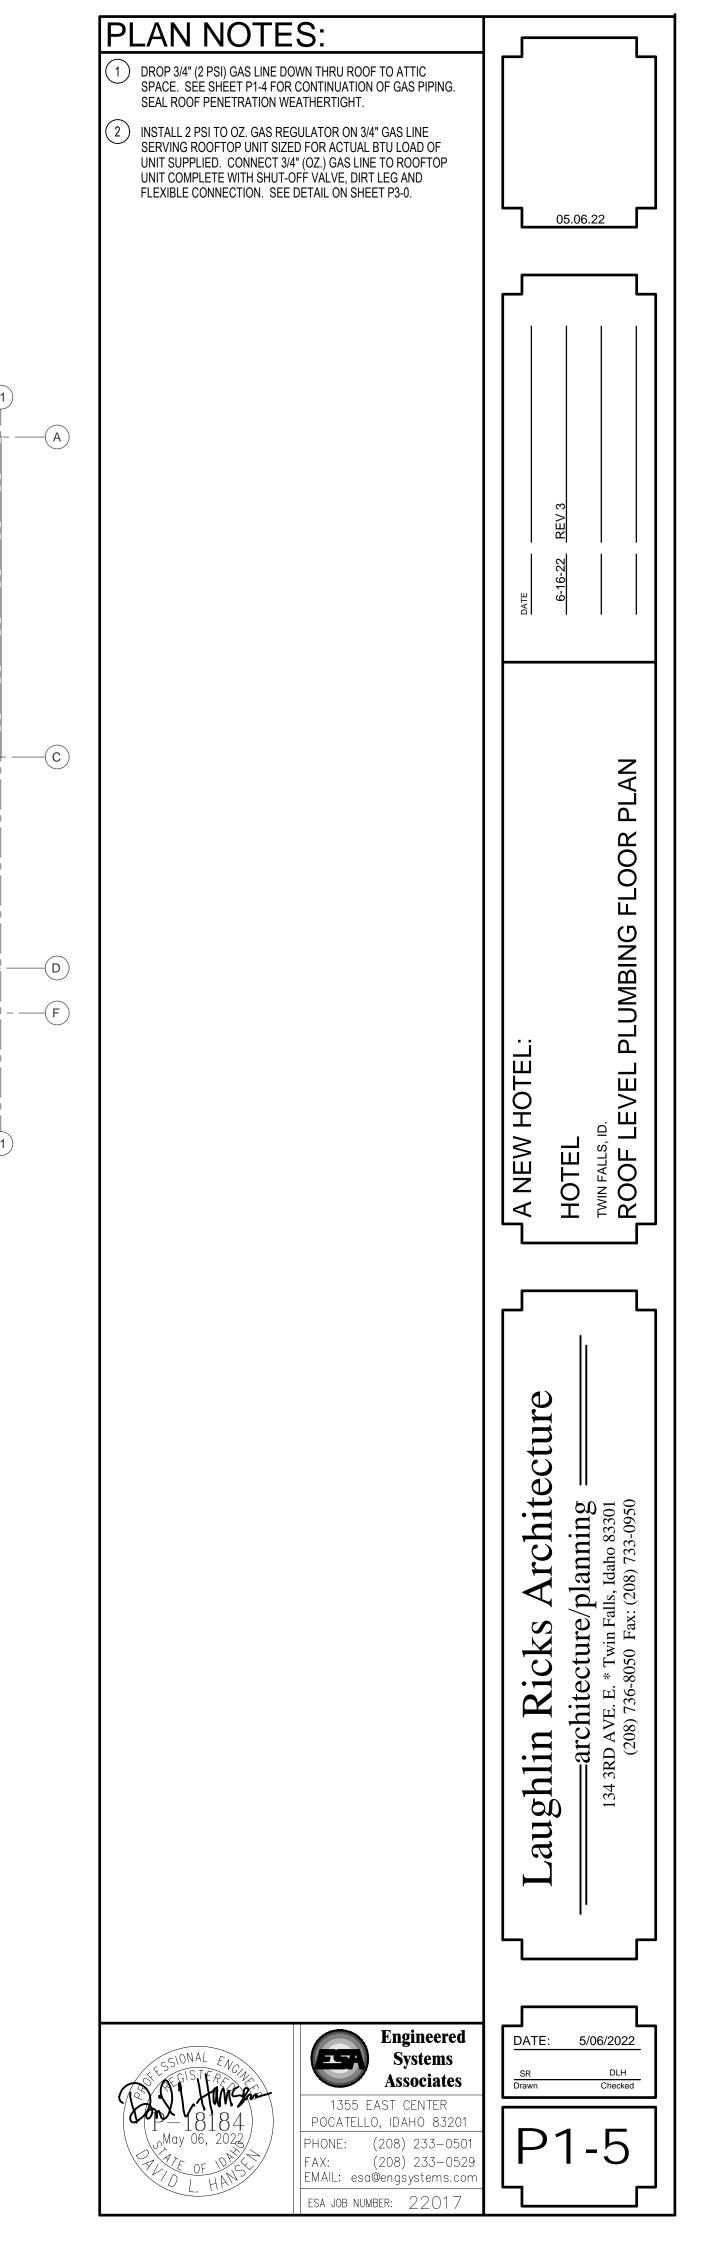


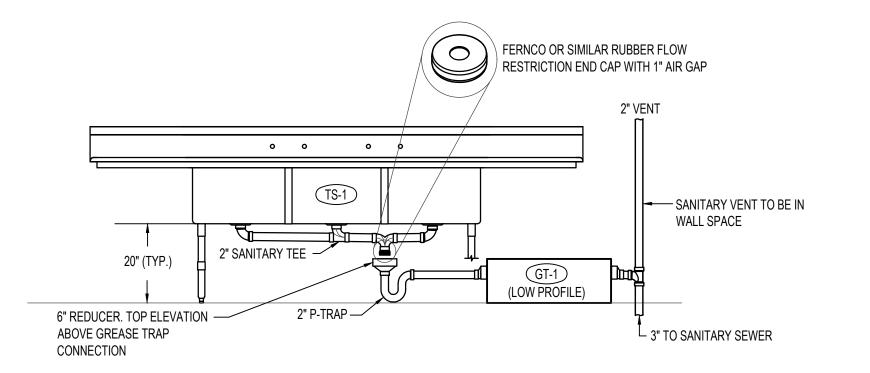

INDIRECT GREASE TRAP DETAIL

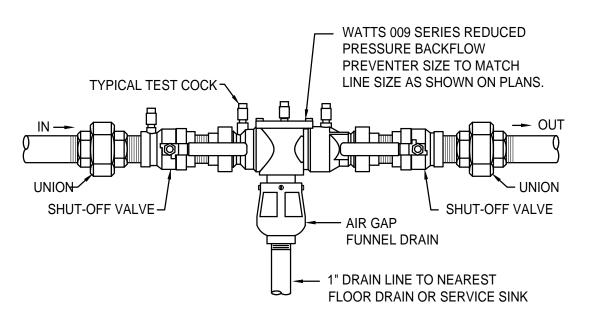

ICE MAKER CW SUPPLY LINE BACKFLOW PREVENTER DETAIL

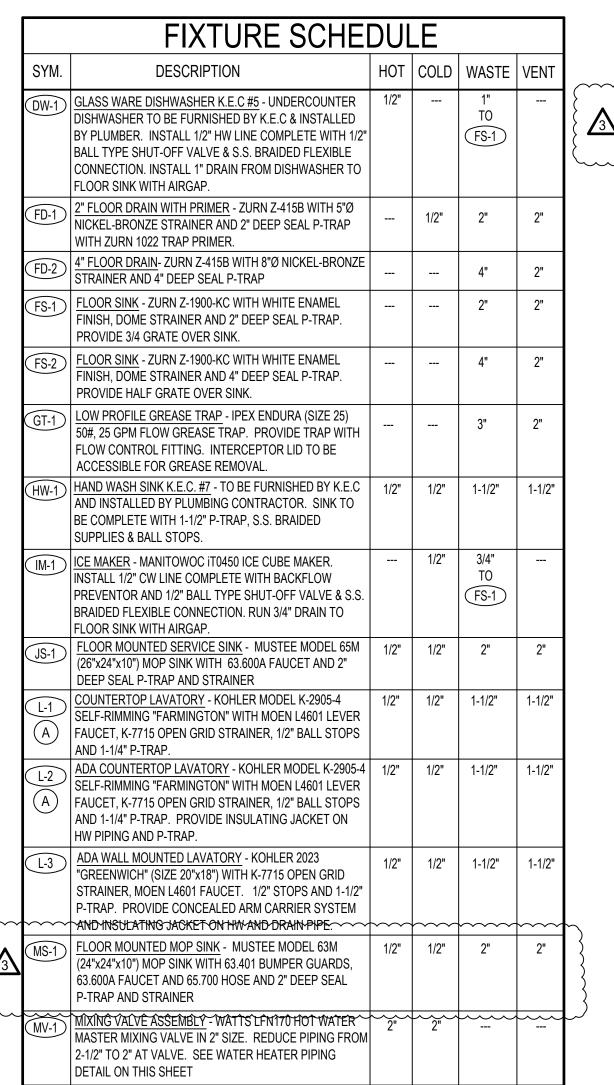

PLUMBING CONTRACTOR TO INSTALL P-TRAP FOR ALL GUEST ROOM LAVATORIES IN WALL IN ACCESS PANEL. P-TRAP TO BE INSTALLED PARALLEL WITH WALL TO BE FULLY CONCEALED.

2-1/2" COLD WATER ——

SHUT OFF VALVE-

2" TOP MOUNT

MULTI-RESIN


(3) 1" DRAIN LINES TO

NEAREST FLOOR DRAIN OR FLOOR SINK -

CONTROL VALVE —

SOFTENER SYSTEM-

MINERAL TANK —

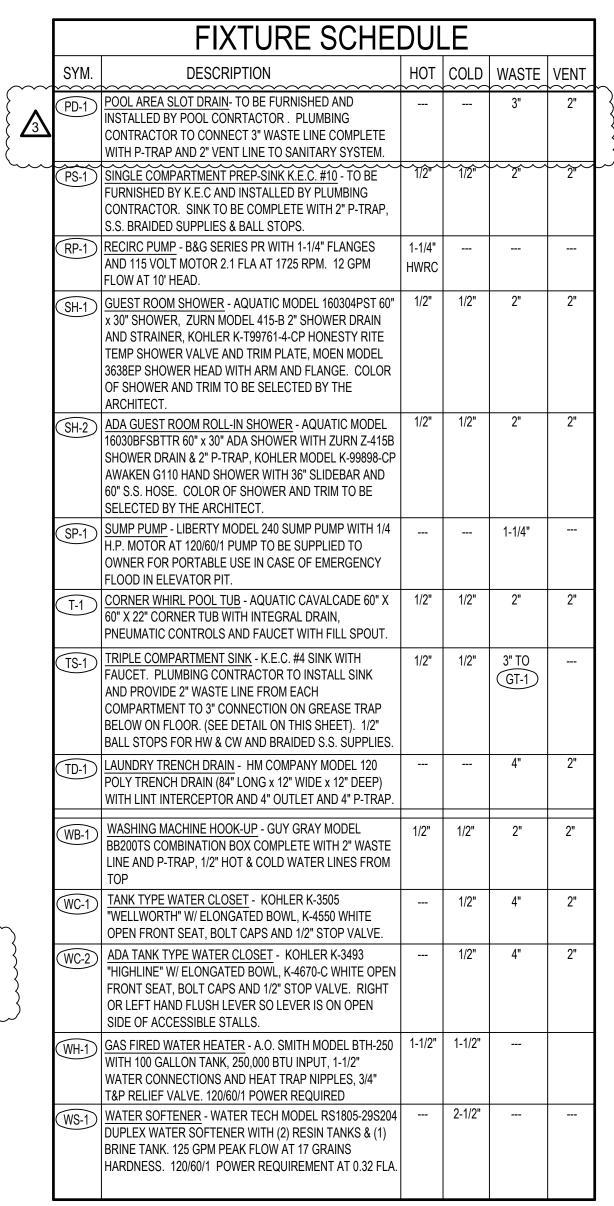


05.06.22


& SCHEDULES

ANE

Architecture

aughlin

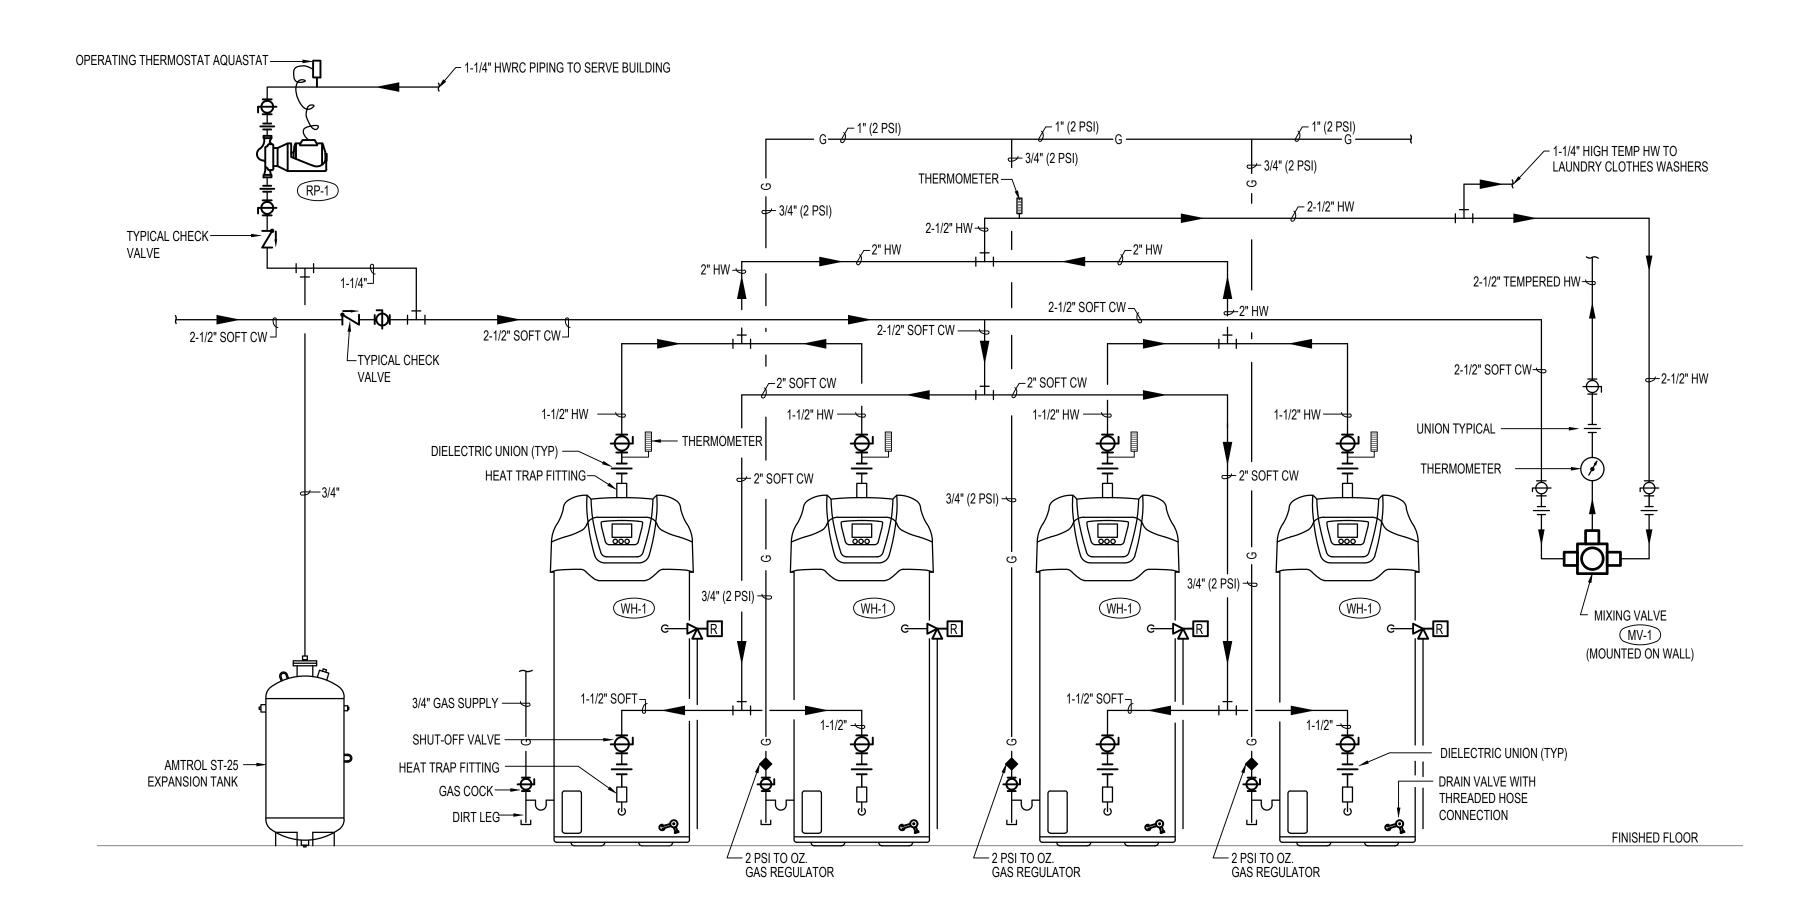

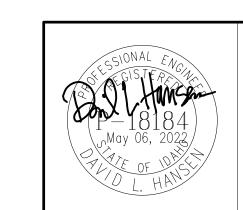

→ 2-1/2" SOFT WATER

BYPASS VALVE

SHUT OFF VALVE

METER CONTROL

- 1/2" BRINE LINE


── BRINE TANK

/ FLOOR

(TYPICAL)


(WS-1)


WATER SOFTENER PIPING DIAGRAM

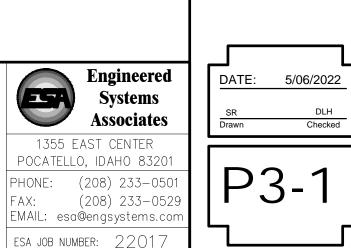



WATER HEATER PIPING DIAGRAM

NO SCALE

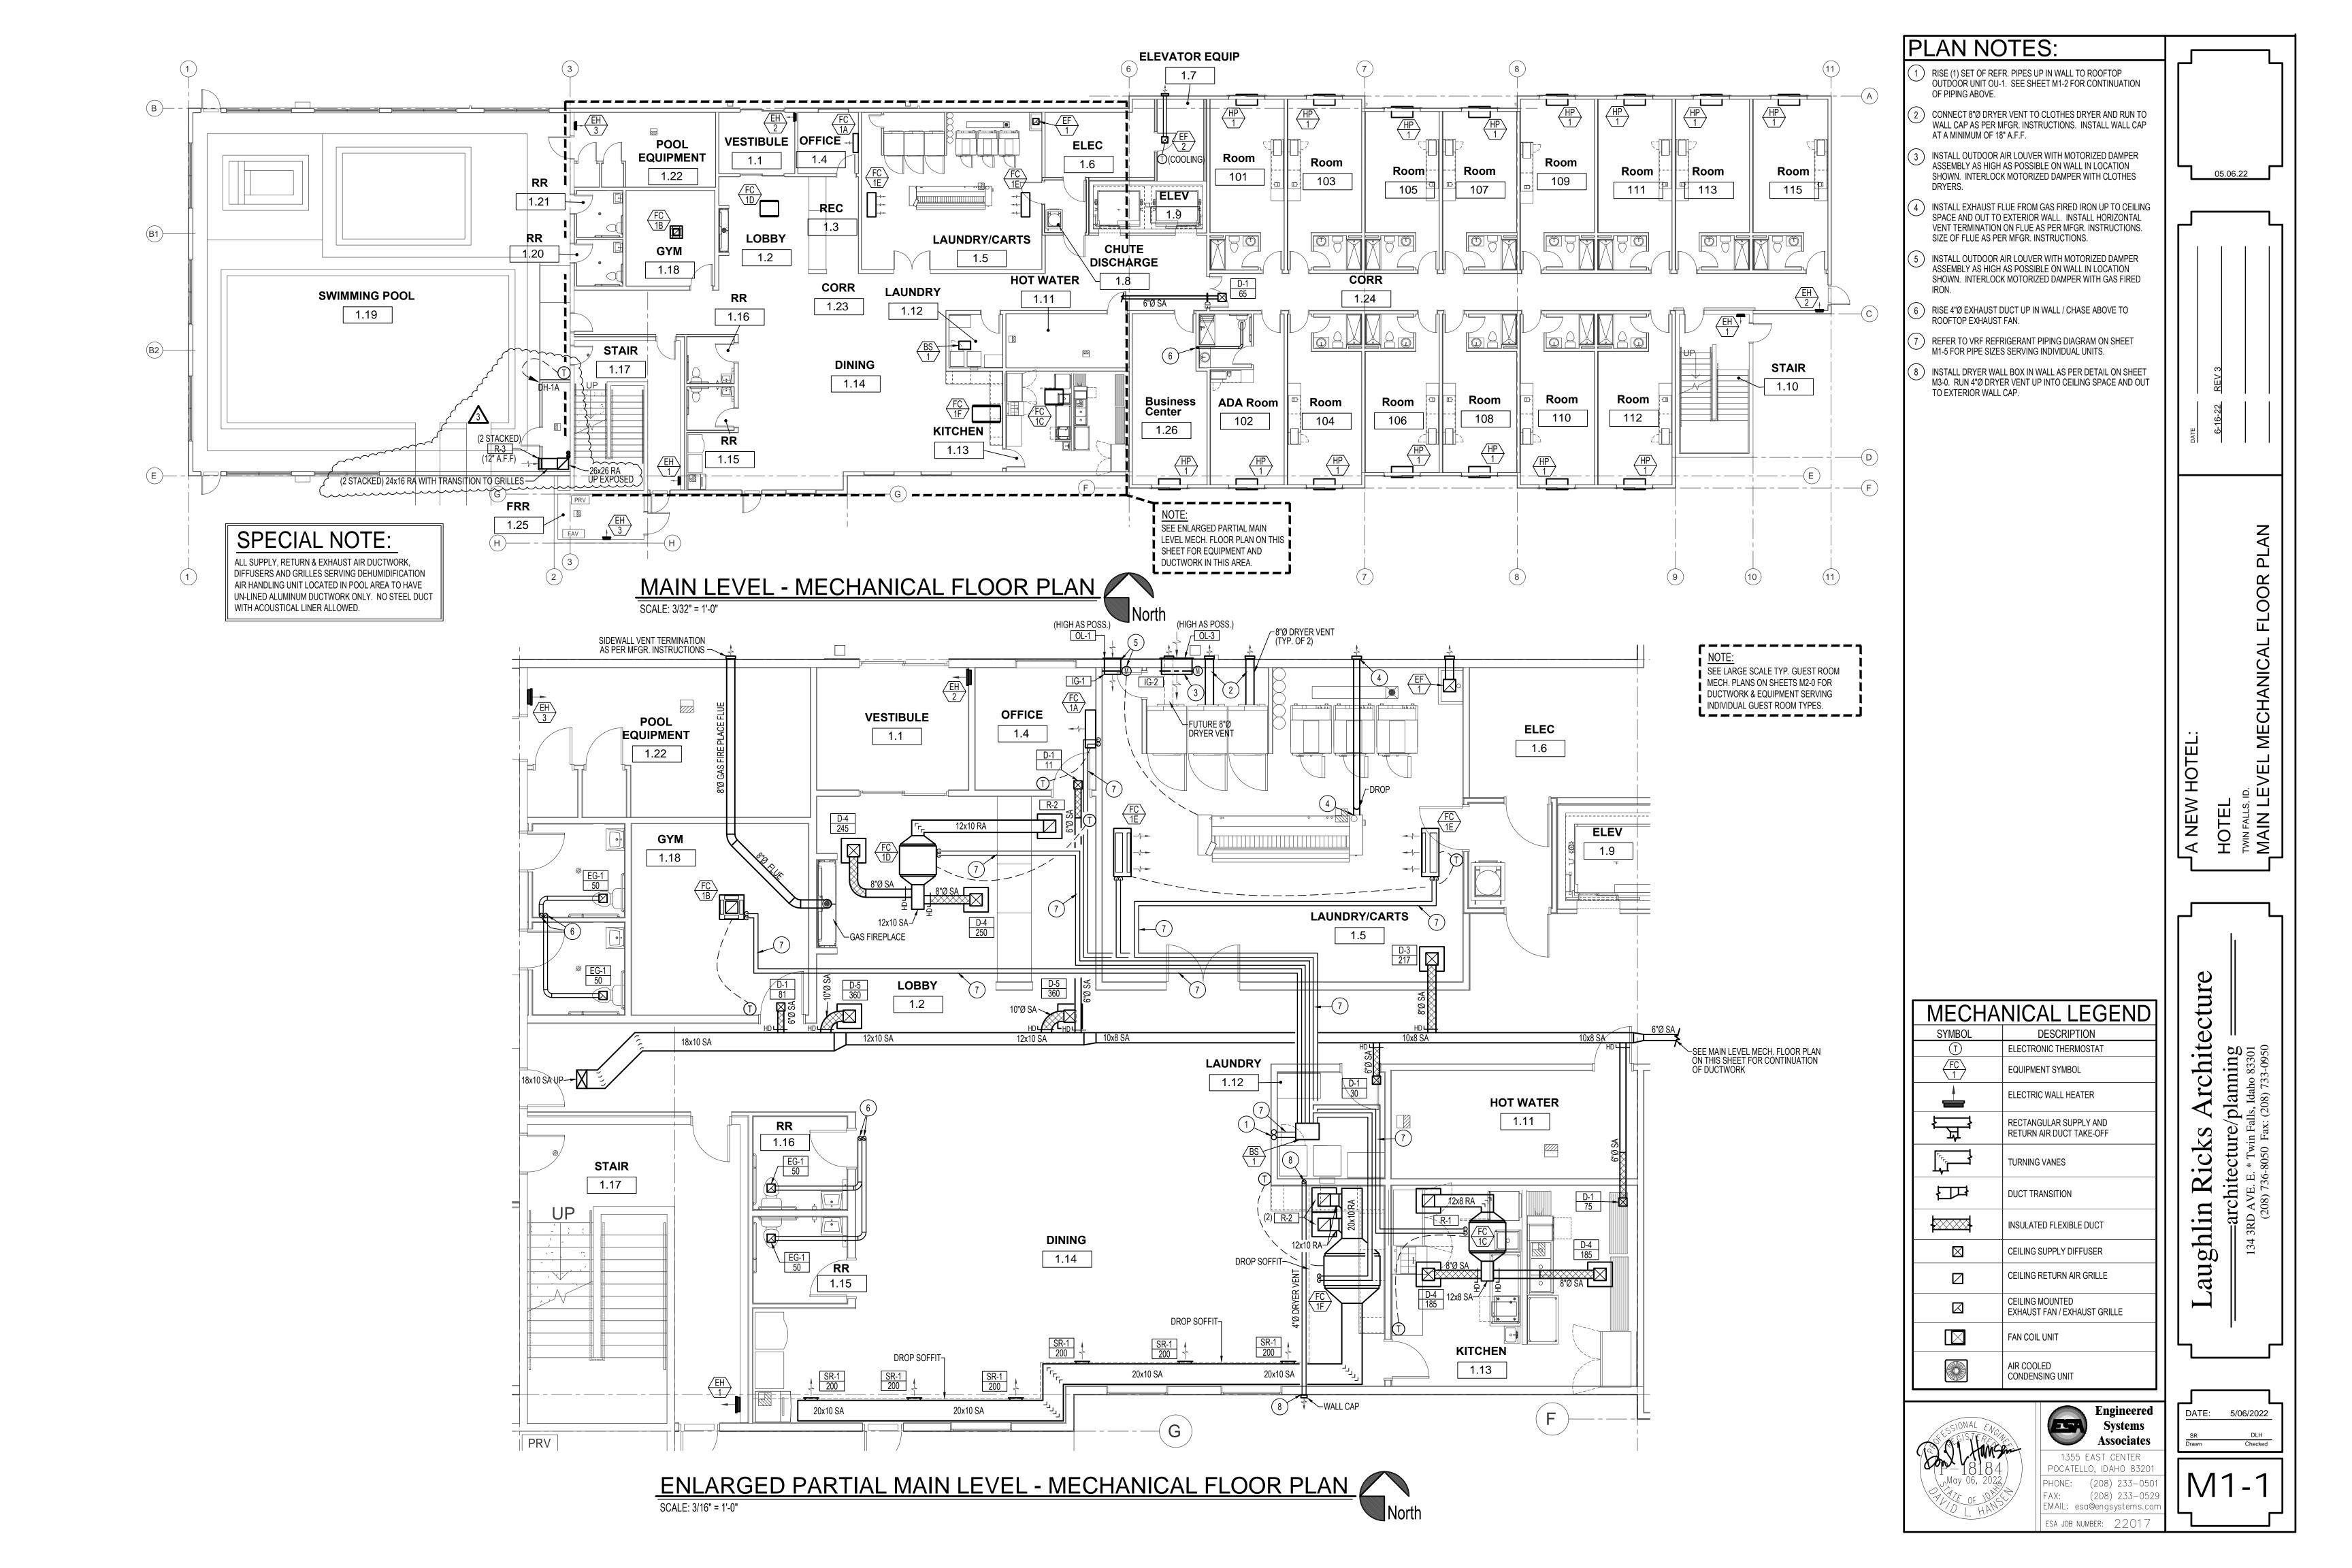

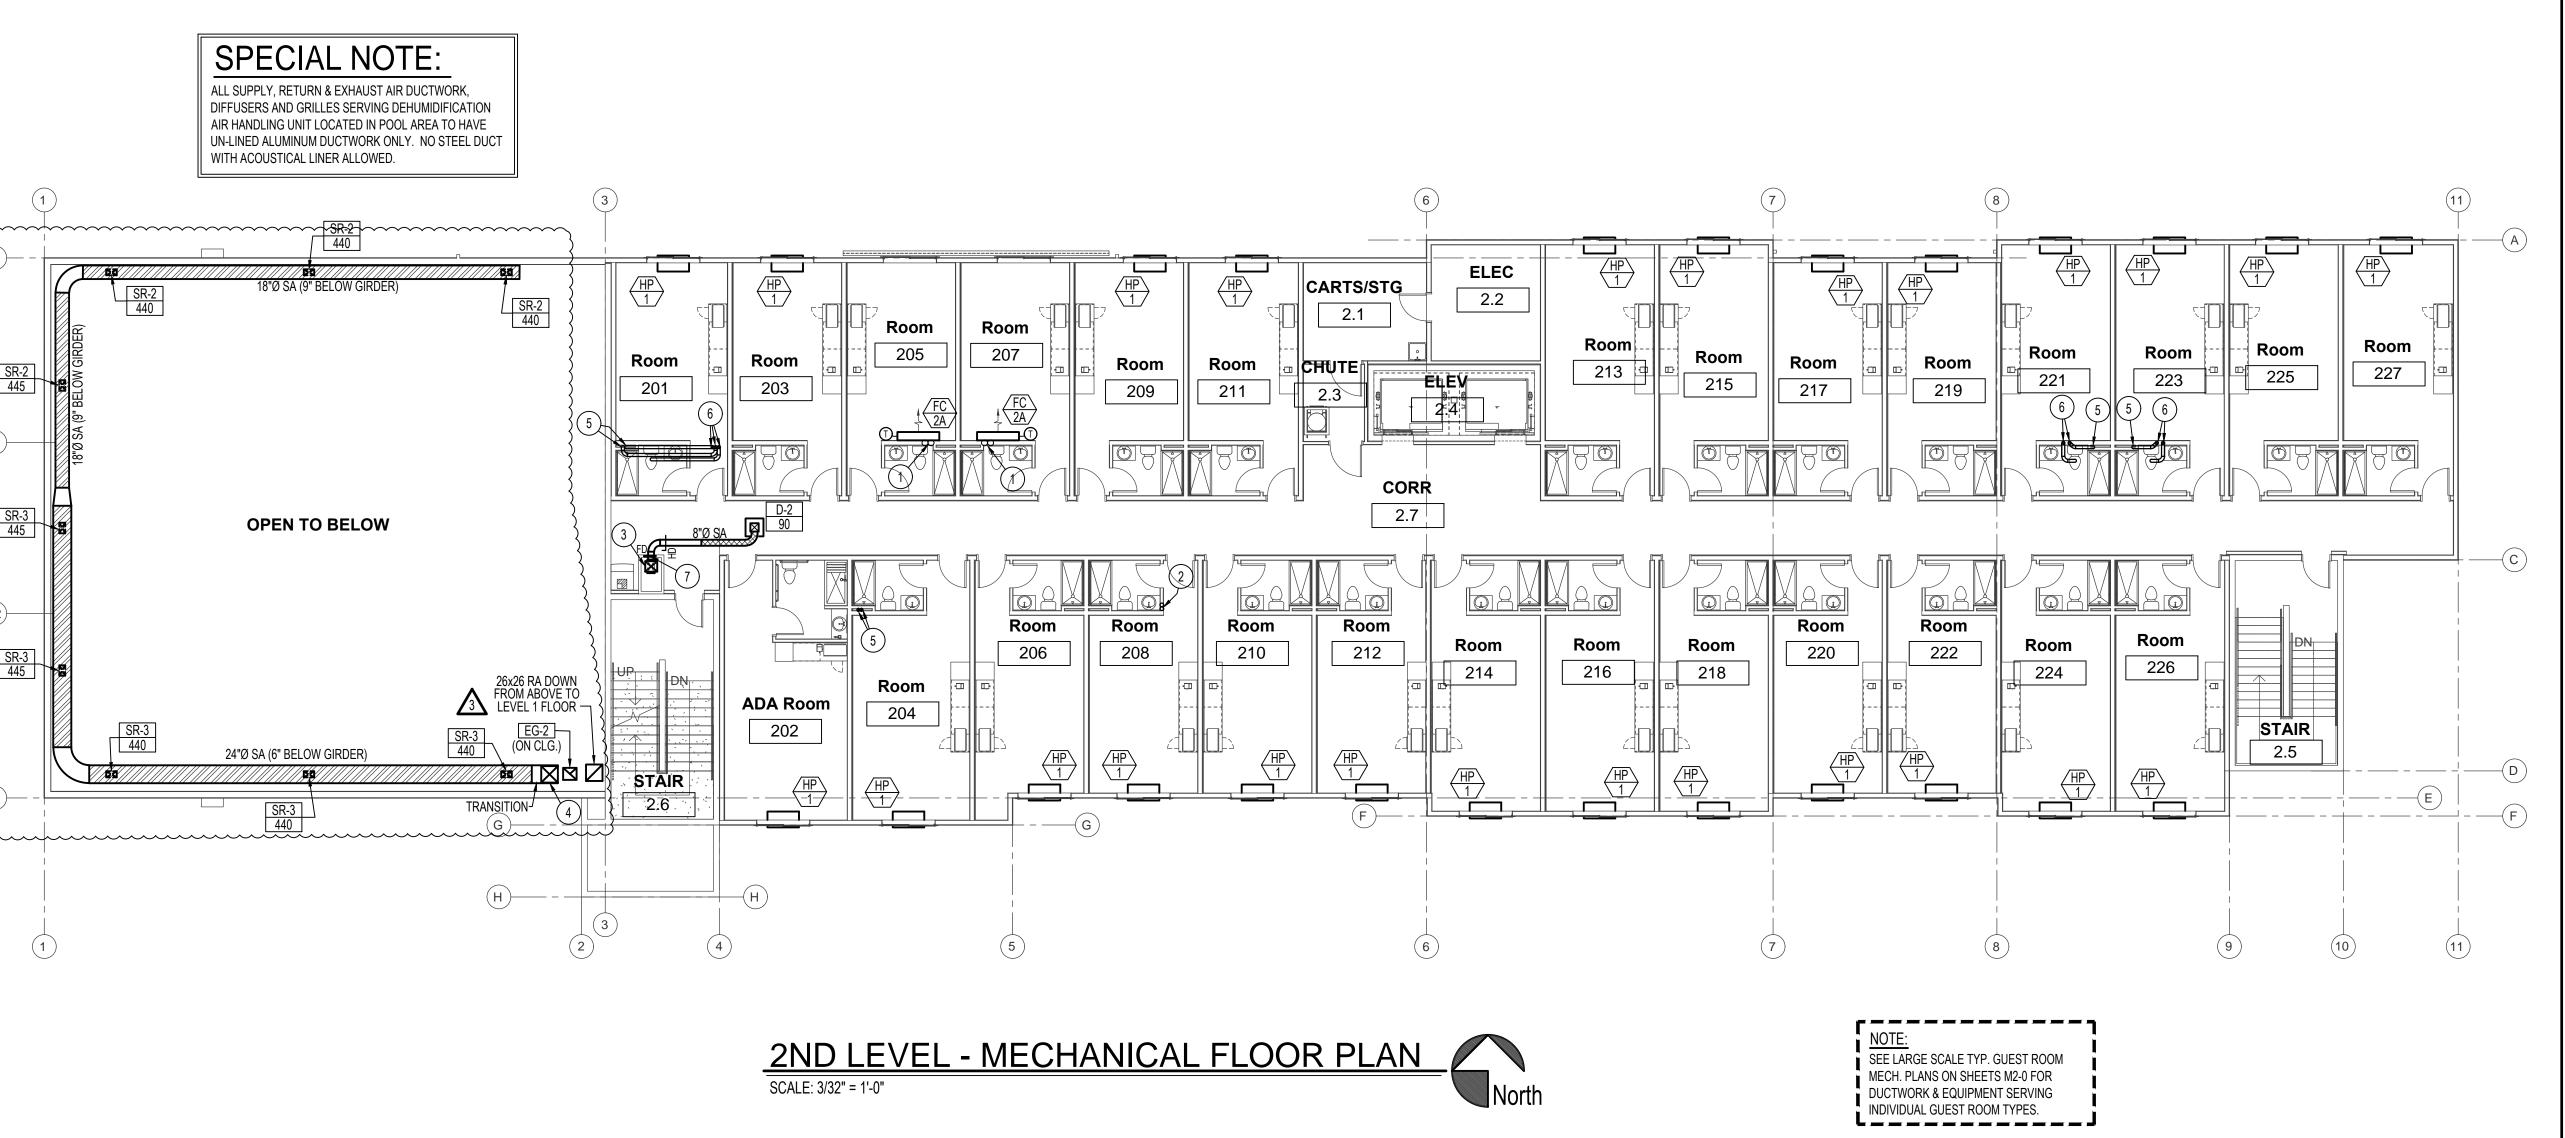

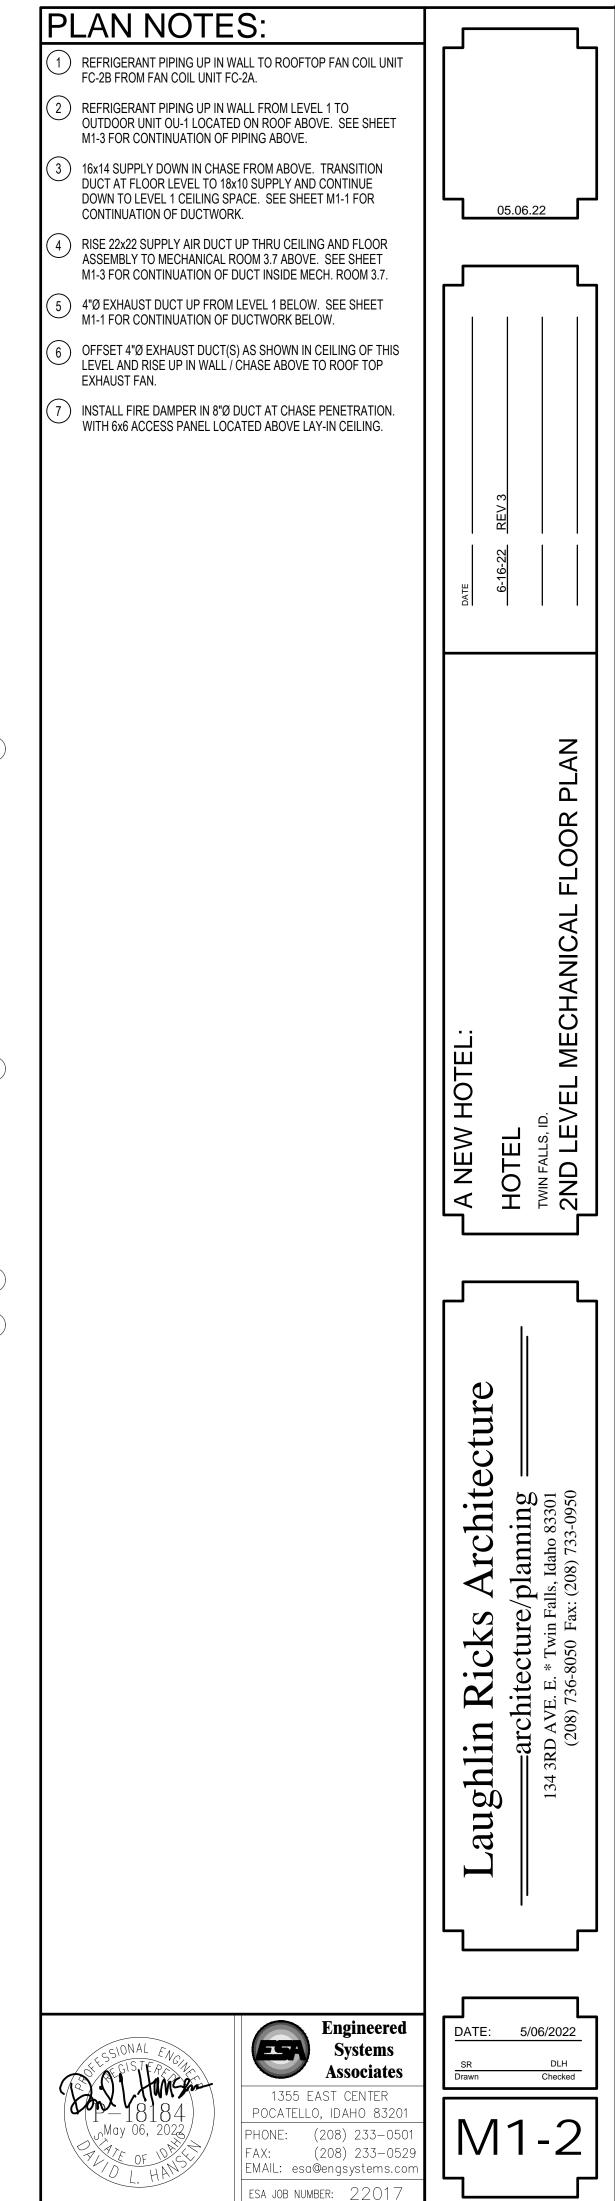

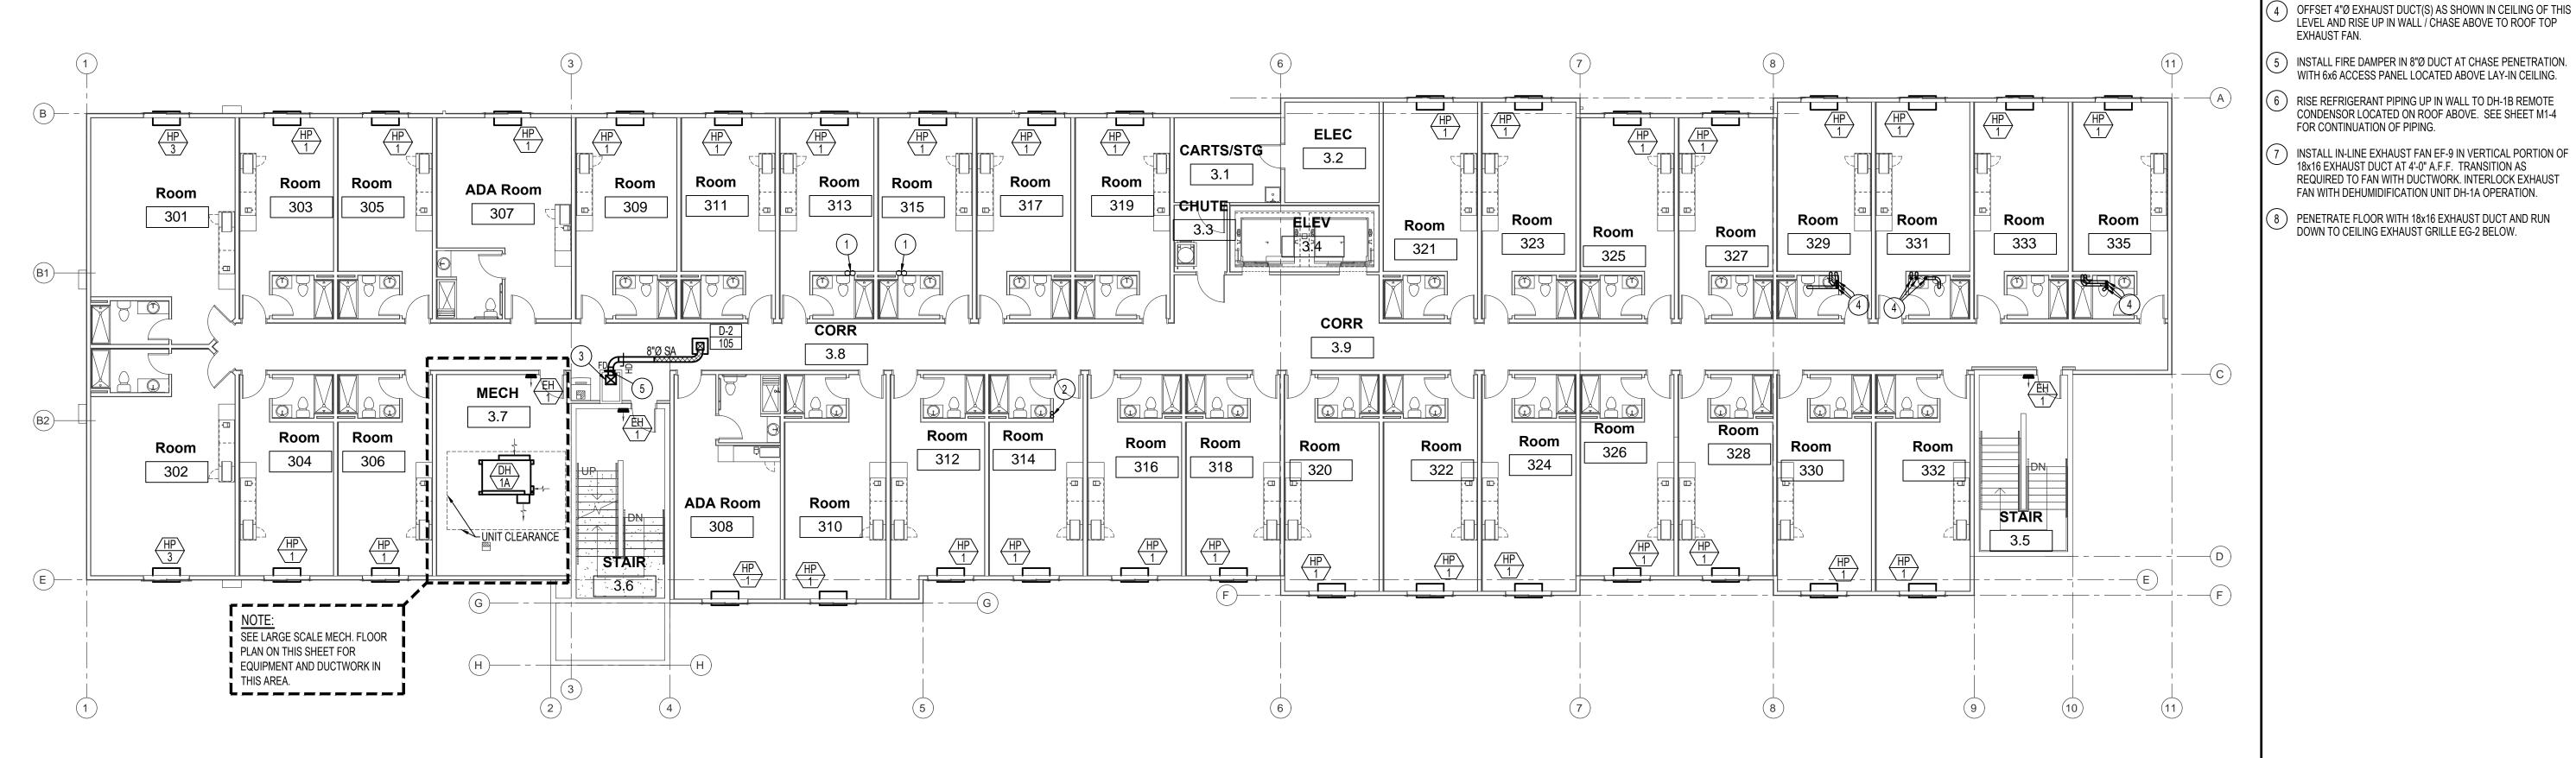


3RD LEVEL - MECHANICAL FLOOR PLAN


SCALE: 3/32" = 1'-0"

Nort

SEE LARGE SCALE TYP. GUEST ROOM MECH. PLANS ON SHEETS M2-0 FOR DUCTWORK & EQUIPMENT SERVING INDIVIDUAL GUEST ROOM TYPES.

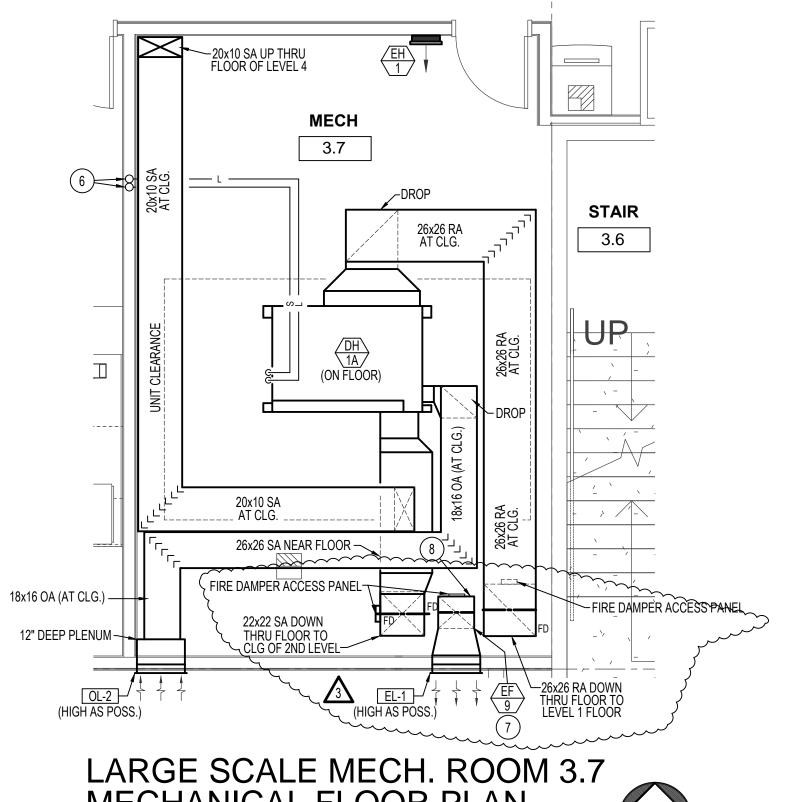

LARGE SCALE MECH. ROOM 3.7 MECHANICAL FLOOR PLAN SCALE: 1/4" = 1'-0"

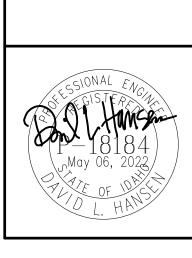

PLAN NOTES:

CONTINUATION OF PIPING ABOVE.

FOR CONTINUATION OF PIPING.

EXHAUST FAN.

REFRIGERANT PIPING DOWN IN WALL FROM ROOFTOP FAN COIL UNIT FC-2B DOWN TO LEVEL 2 FAN COIL UNIT FC-2A.

REFRIGERANT PIPING UP IN WALL TO OUTDOOR UNIT OU-1 LOCATED ON ROOF ABOVE. SEE SHEET M1-4 FOR

3) 16x14 SUPPLY AIR DUCT DOWN IN CHASE FROM ABOVE.

SHEET M1-2 FOR CONTINUATION OF DUCTWORK.

CONTINUE WITH 16x14 SUPPLY DUCT DOWN TO LEVEL 2. SEE

LEVEL AND RISE UP IN WALL / CHASE ABOVE TO ROOF TOP

WITH 6x6 ACCESS PANEL LOCATED ABOVE LAY-IN CEILING.

CONDENSOR LOCATED ON ROOF ABOVE. SEE SHEET M1-4

INSTALL IN-LINE EXHAUST FAN EF-9 IN VERTICAL PORTION OF

REQUIRED TO FAN WITH DUCTWORK. INTERLOCK EXHAUST

18x16 EXHAUST DUCT AT 4'-0" A.F.F. TRANSITION AS

FAN WITH DEHUMIDIFICATION UNIT DH-1A OPERATION.

DOWN TO CEILING EXHAUST GRILLE EG-2 BELOW.

05.06.22

LEVEL MECHANICAL FLOOR PLAN


HOTE
TWIN FALL


JA NE

Architecture




aughlin Ricks DATE: 5/06/2022

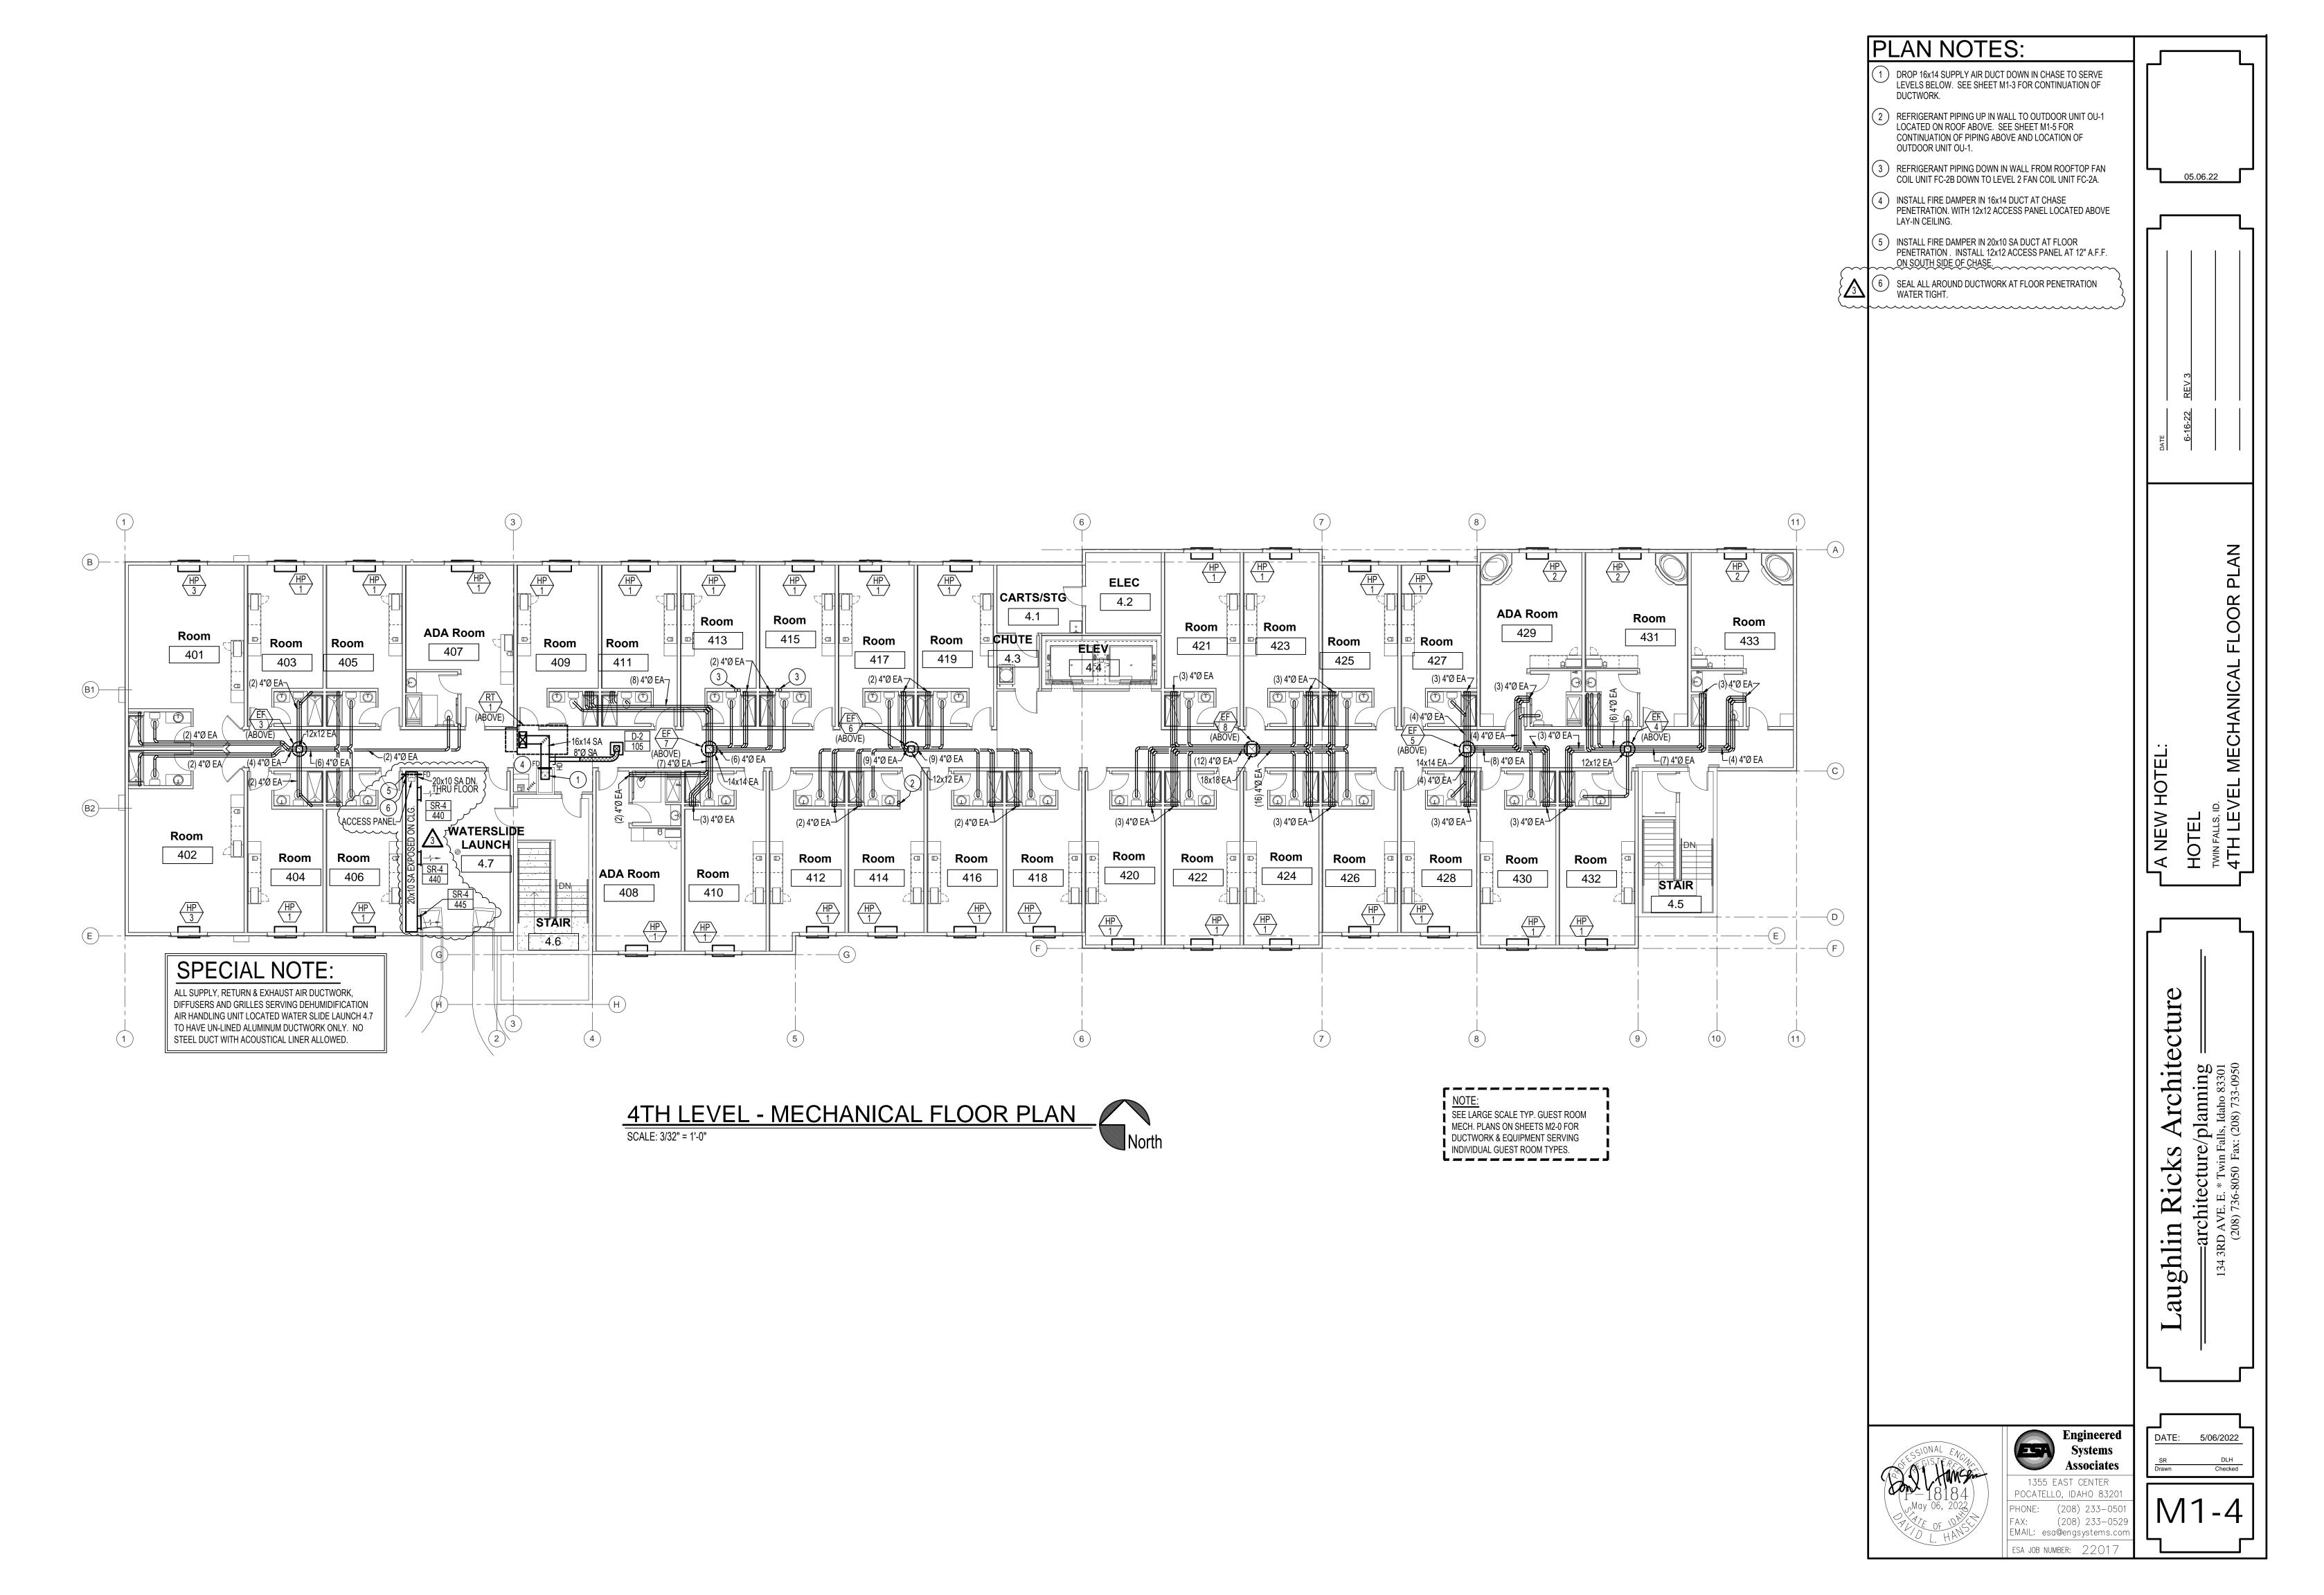


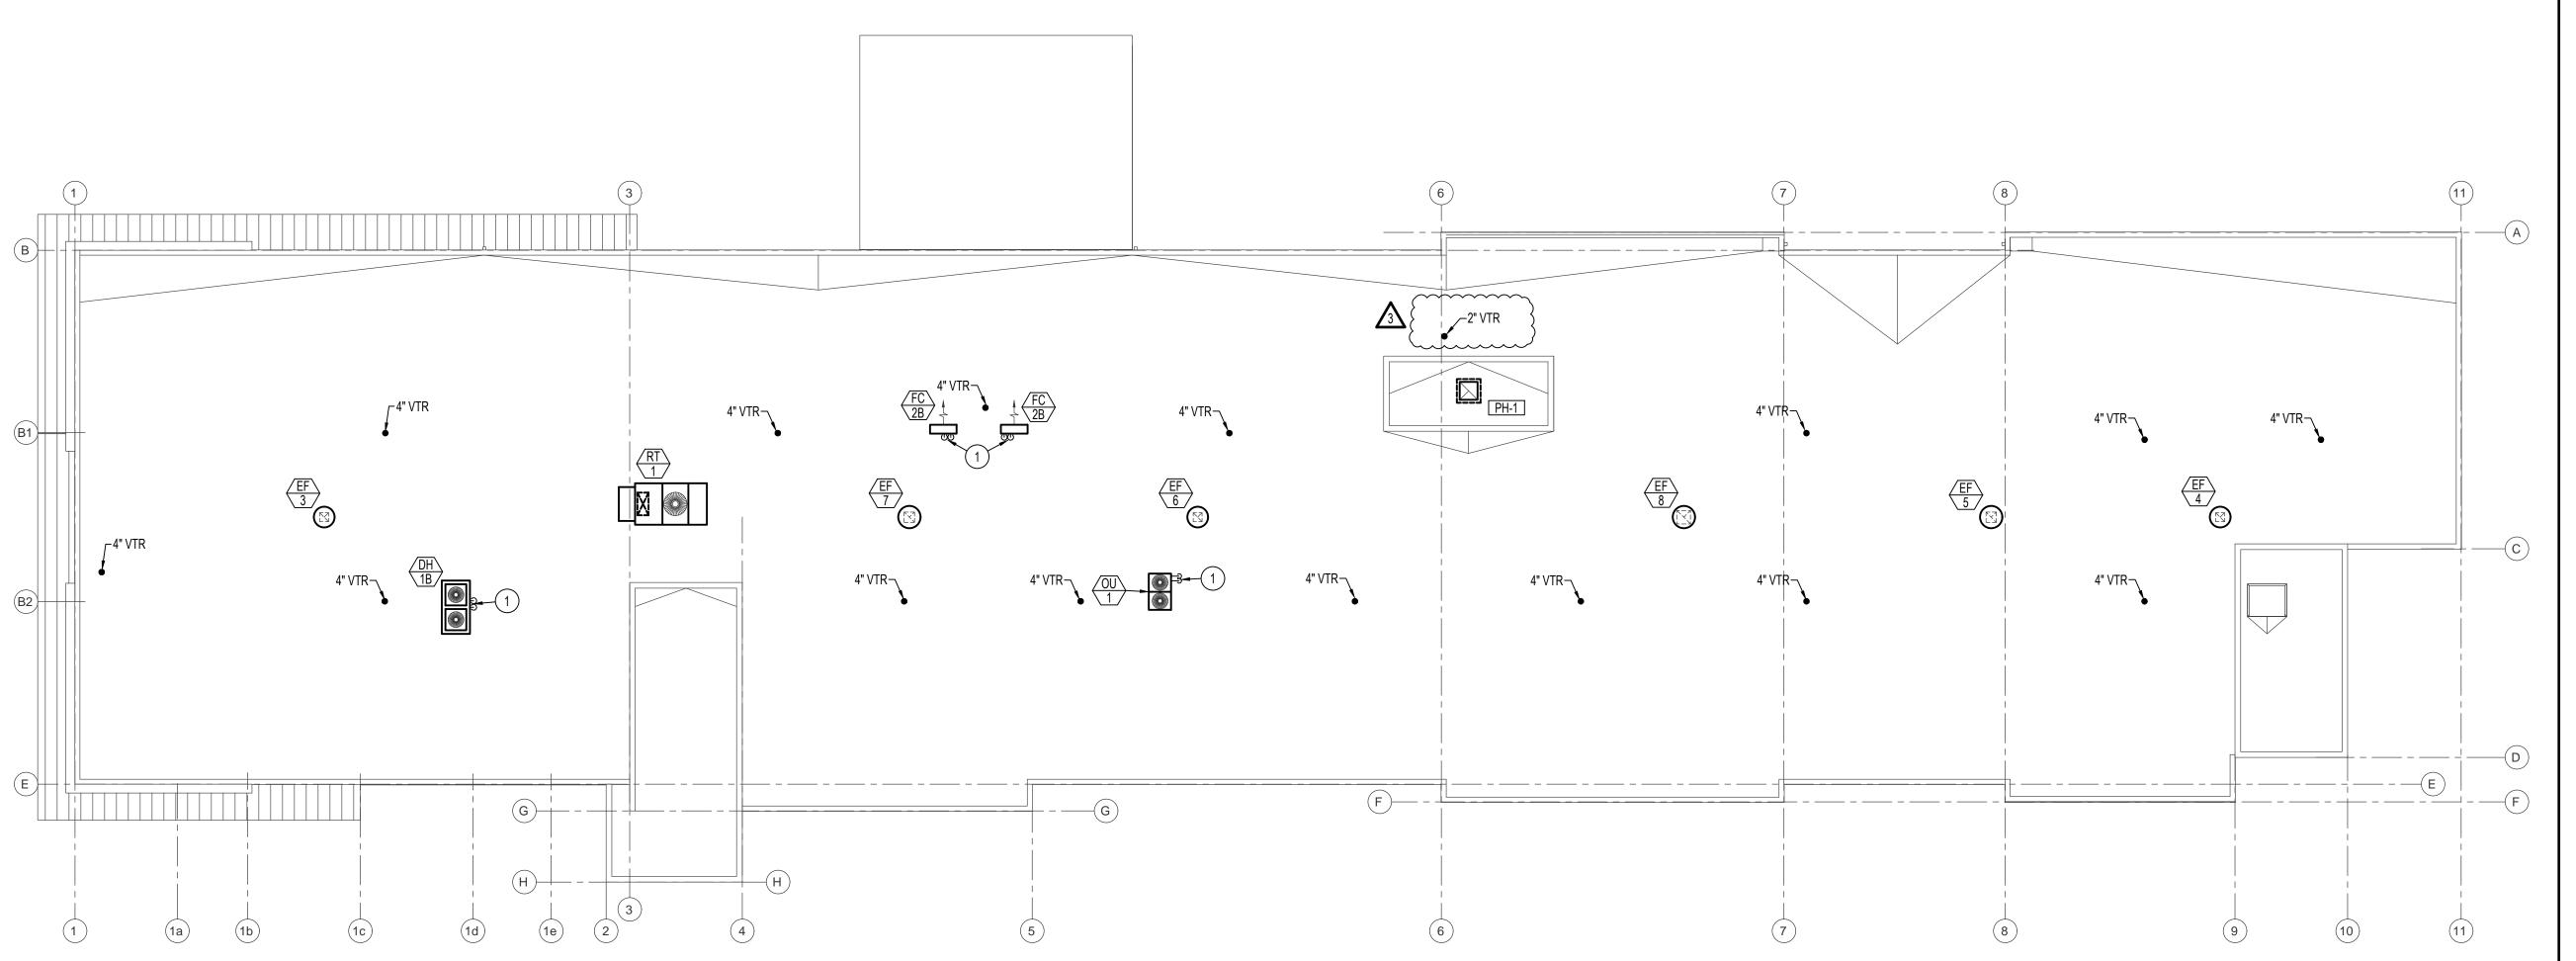


ROOF LEVEL - MECHANICAL FLOOR PLAN

SCALE: 3/32" = 1'-0"

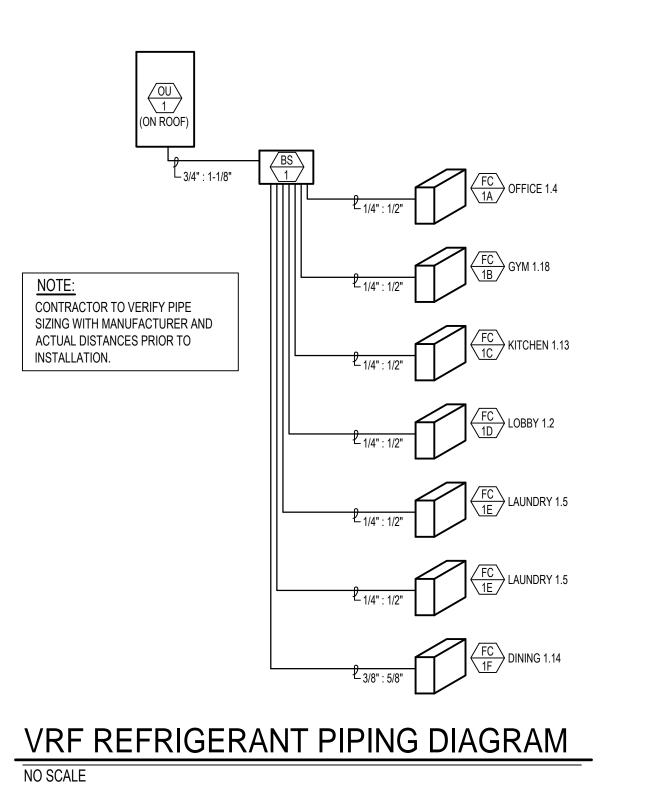

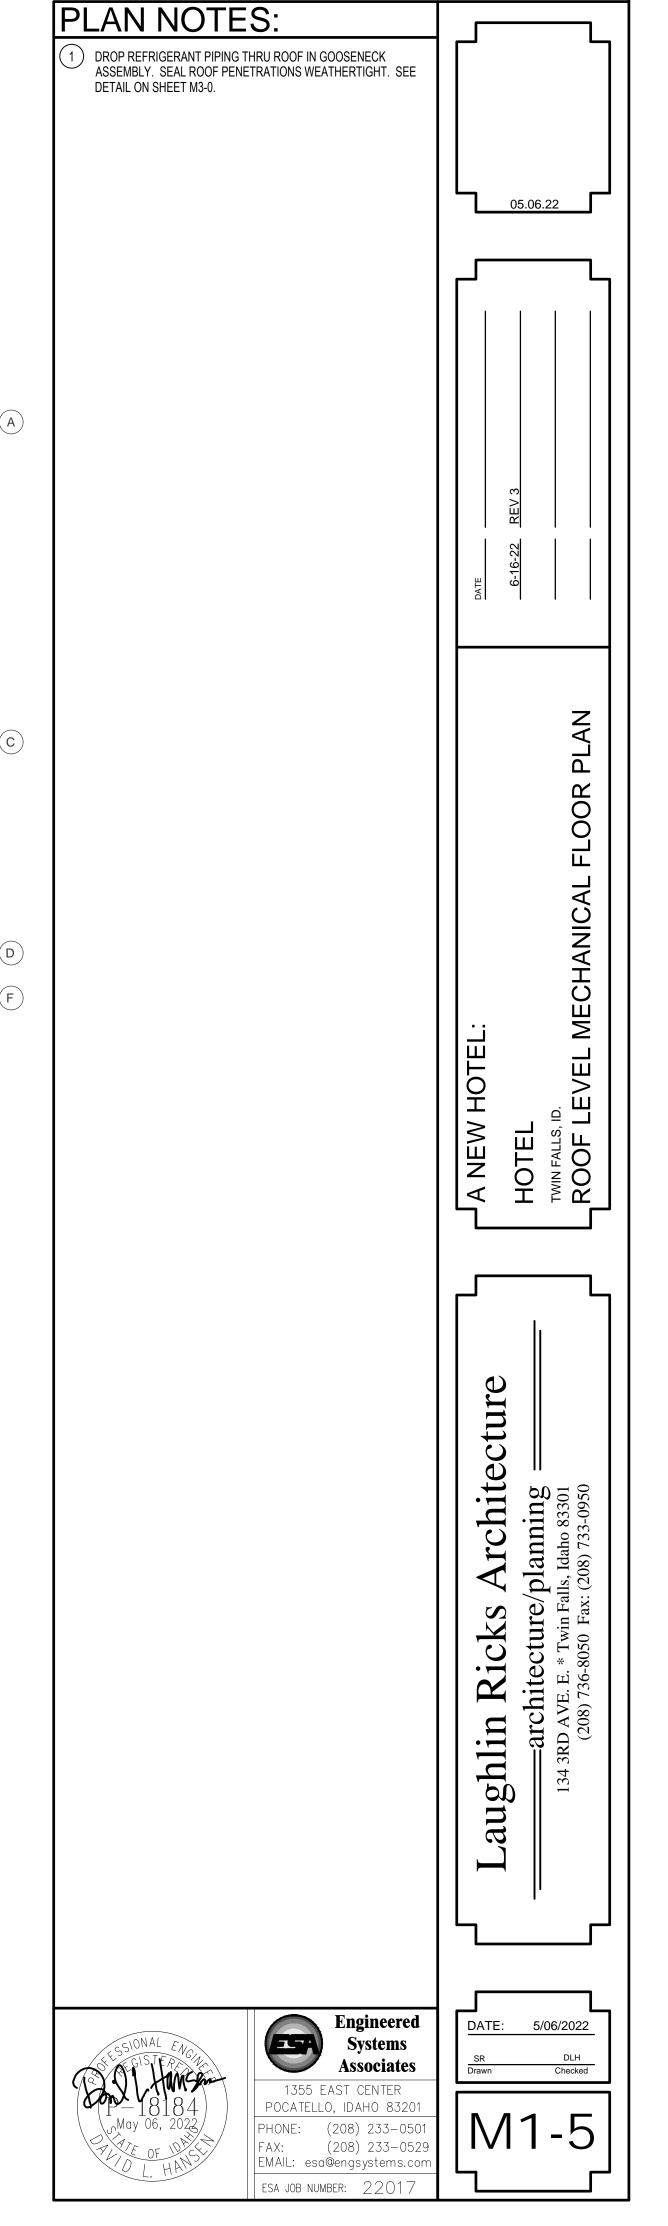

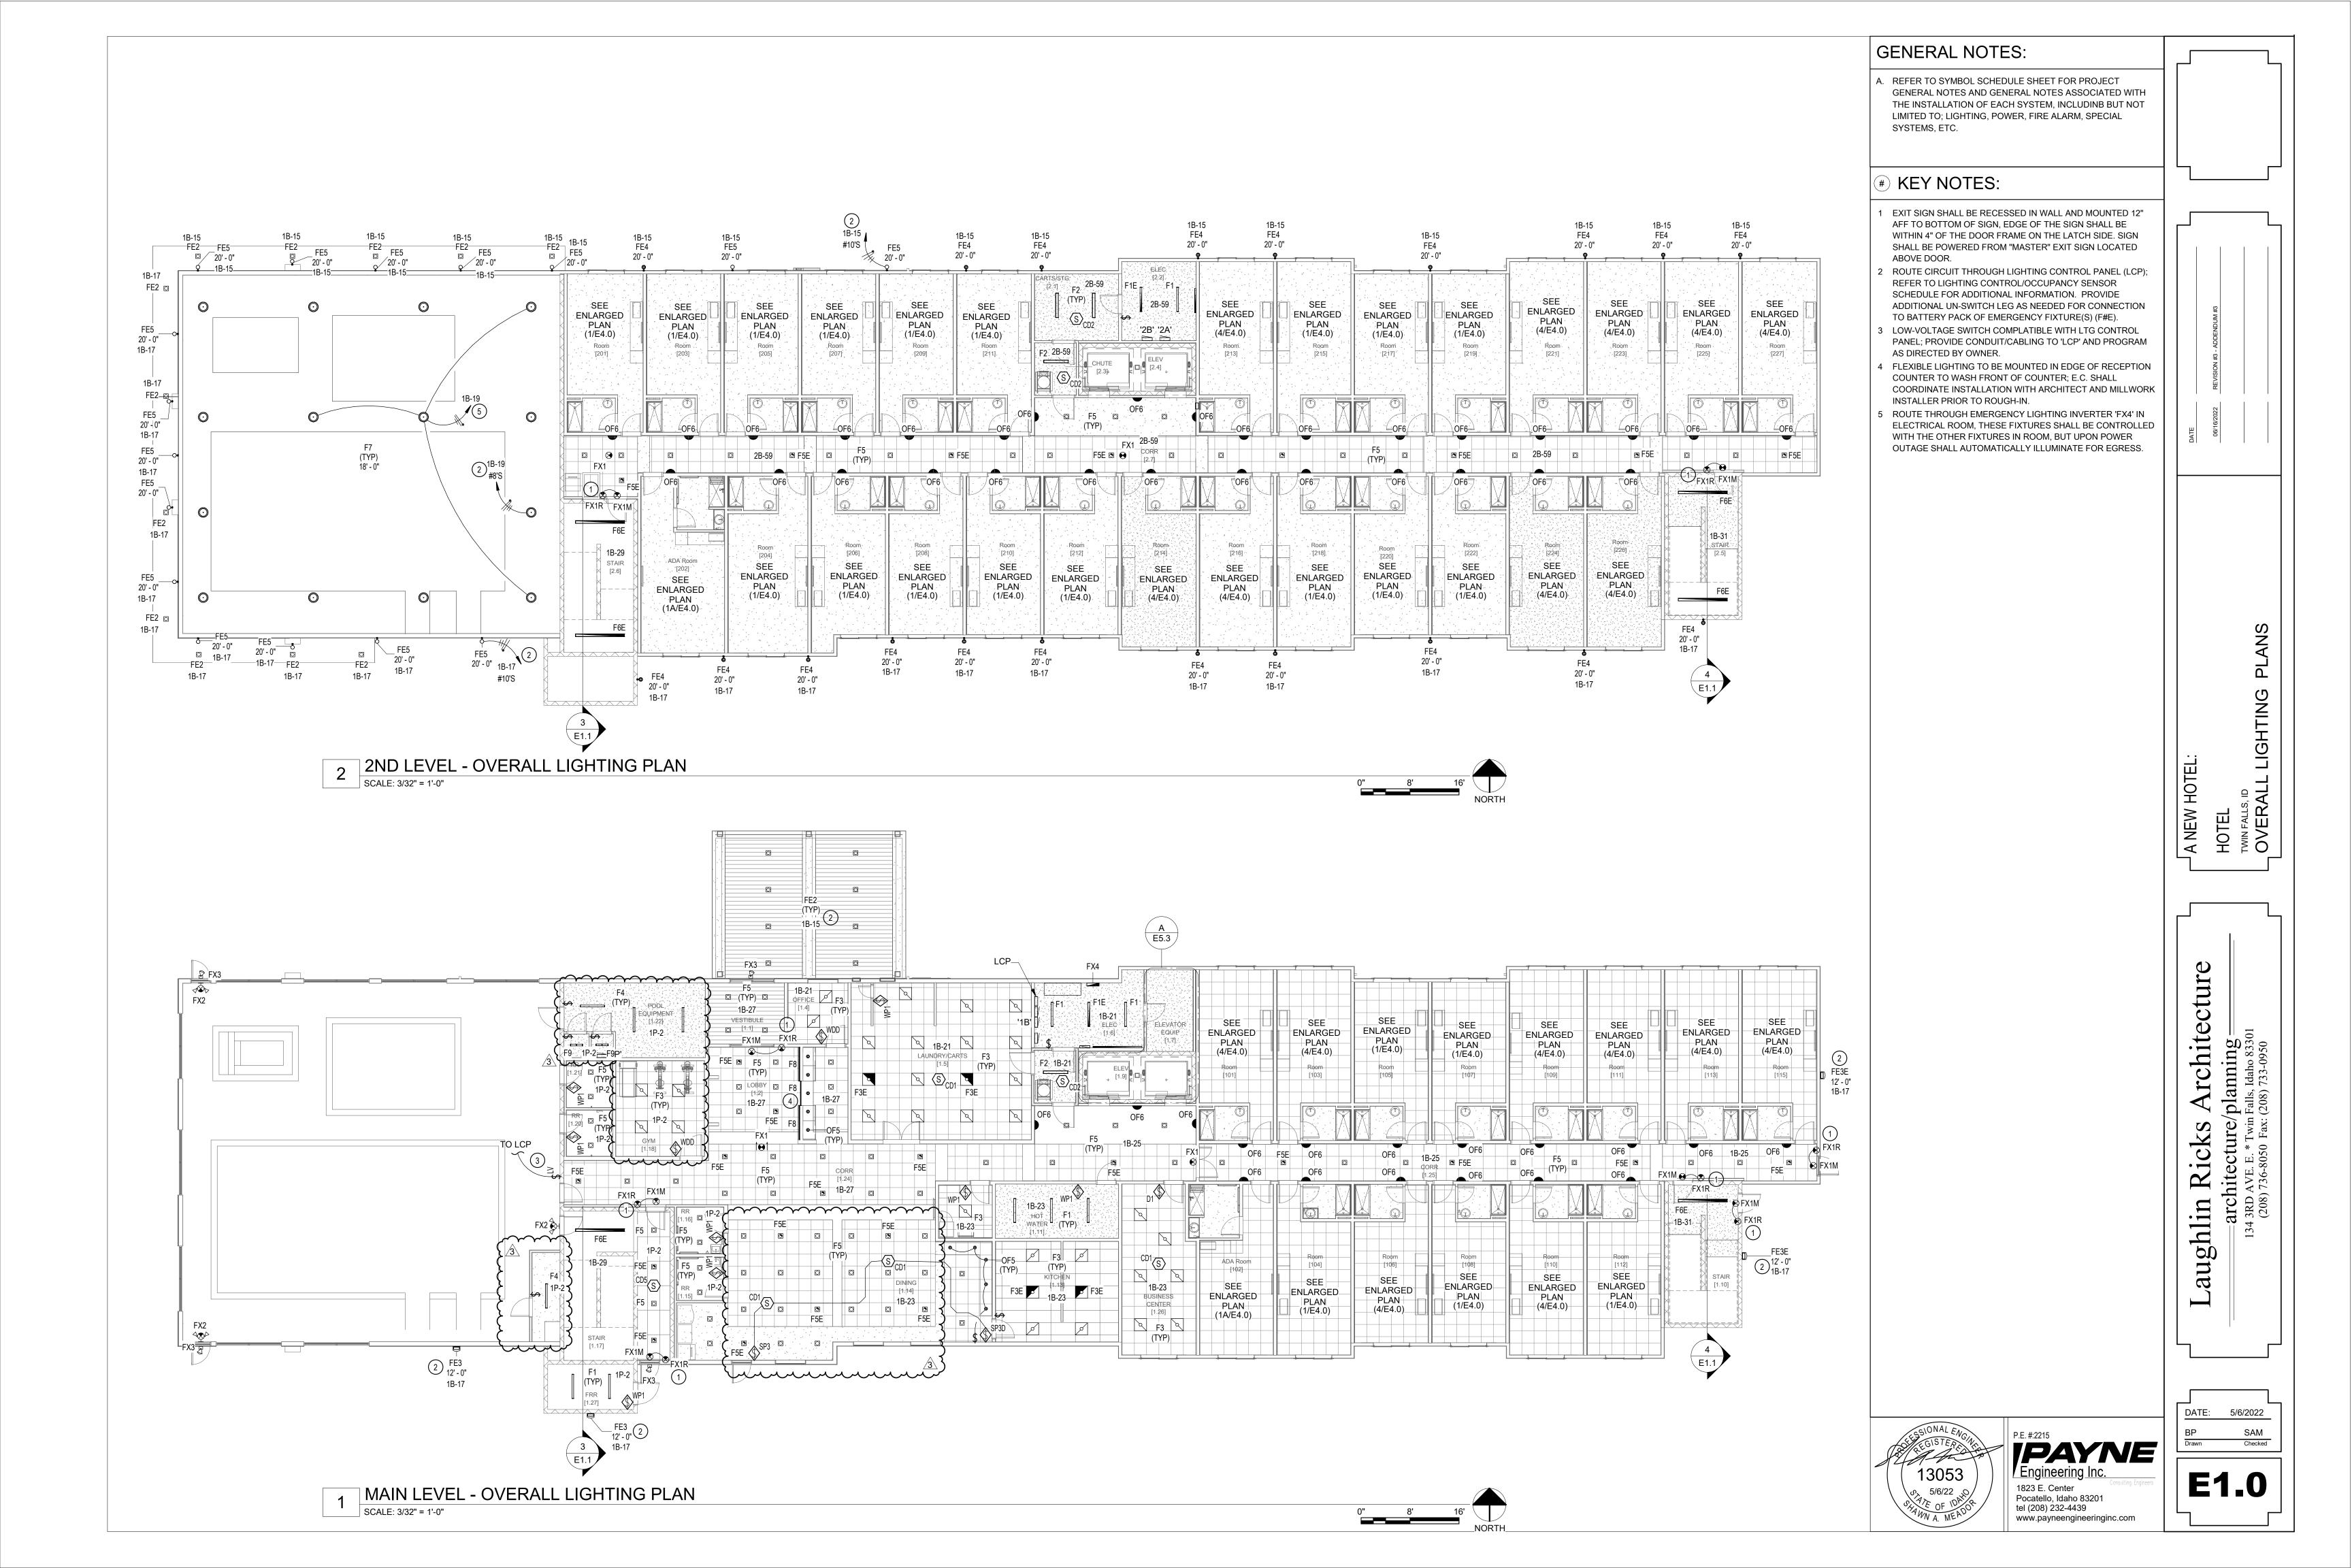

MECHANICAL -ELECTRIC HEATER SCHEDULE													
EQUIP. ID	VOLTS	PH.	WATTS	CIRCUIT	FEEDER	NOTES							
EH-1	120 V	1	2 kW	<varies>-<varies></varies></varies>	#10'S								
EH-2	120 V	1	2 kW	<varies>-<varies></varies></varies>	#10'S								
EH-3 208 V 1 2 kW 1P- <varies> #12'S</varies>													

M	ECH/	INA	CAL	- VRF	FAN COIL	UNIT SCHEDU	JLE
EQUIP. ID	VOLTS	PH.	MCA	MOCP	CIRCUIT	FEEDER	NOTES
FC-1A	208 V	V 1 0.24 A 1			1B-66,68	#12'S	2
FC-1B	208 V	8 V 1 0.29 A		15 A	1P-16,18	#12'S	2
FC-1C	208 V	1	2.13 A	15 A	<varies>-<varies></varies></varies>	#12'S	2
FC-1E	208 V	8 V 1 0.33 A		15 A	1B-66,68	#12'S	2
FC-1F	208 V 1 4.25		4.25 A	15 A	1B-62,64	#12'S	2

	MEC	HAN	11C	AL -	DEH	HUMIDIF	ICATION L	JNIT SCHED	ULE
	EQUIP. ID	VOLTS	PH.	MCA	MOCP	CIRCUIT	FEEDER	DISCONNECT	NOTES
	DH-1A	208 V	3	168 A	175 A	3M-19,21,23	2"C.,3#2/0+1#6G	200 A NON-FUSED/1	3
	DH-1B	208 V	3	14 A	20 A	4C-50,52,54	#10'S	30 A NON-FUSED/3R	3

		MEC	AHC	IICAL -	EXHAUST F	AN SCH	EDULE							
EQUIP. II	VOLTS	PH.	HP	WATTS	CONTROL	CIRCUIT	FEEDER	NOTES						
EF-1	120 V	1B-14	#12'S											
EF-2 120 V 1 100 W COOLING STAT 1B-4 #12'S														
EF-3 120 V 1 1/4 CONTINUOUS 4C-33 3/4"C.,2#12+1#12G 2 EF-4 120 V 1 1/4 CONTINUOUS 4C-37 3/4"C.,2#12+1#12G 2														
EF-4 120 V 1 1/4 CONTINUOUS 4C-37 3/4"C.,2#12+1#12G														
EF-5	120 V	1	1/4		CONTINUOUS	4C-37	3/4"C.,2#12+1#12G	2						
EF-6	120 V	1	1/4		CONTINUOUS	4C-35	3/4"C.,2#12+1#12G	2						
EF-7	120 V	1	1/4		CONTINUOUS	4C-33	3/4"C.,2#12+1#12G	2						
EF-8	120 V	1	1/4		CONTINUOUS	4C-35	3/4"C.,2#12+1#12G	2						
EF-9	EF-9 120 V 1 1/3 INTERLOCK W/ DH-1A 3C-40 3/4"C.,2#12+1#12G 2													
MECH	ANICAL S	CHED	ULE N	OTES:										

- CIRCUIT AND CONTROL EXHAUST FAN WITH ROOM LIGHTING CIRCUIT.
- 2. E.C. SHALL PROVIDE LOCAL DISCONNECT RATED, THERMAL-OVERLOAD SWITCH FOR EQUIPMENT; SWITCH RATING

SPA TIMER &

E-STOP PER POOL EQUIP.

INSTALLER

- SHALL NOT BE LESS THEN CIRCUIT BREAKER SUPPLYING EQUIPMENT.

 3. E.C. SHALL PROVIDE LOCAL DISCONNECT SWITCH FOR EQUIPMENT; SIZE AND TYPE AS INDICATED IN SCHEDULE.
- E.C. SHALL PROVIDE LOCAL DISCONNECT SWITCH FOR EQUIPMENT; SIZE AND TYPE AS INDICATED IN SCHEDULE IF FUSED DISCONNECT IS SPECIFIED FOR EQUIPMENT, FUSE PER EQUIPMENT NAMEPLATE RATING.
- 4. EQUIPMENT IS FACTORY SUPPLYED WITH DISCONNECT AND CONVIENENCE OUTLET; E.C. SHALL PROVIDE ALL NECESSARY CONNECTIONS.

E.C. SHALL PROVIDE AN EQUIPOTENTIAL GROUND SYSTEM FOR POOL, KIDDIE POOL AND HOTTUB IN ACCORDANCE TO NEC ARTICLE 680.

BOND ALL METAL COMPONENTS, RAILINGS.

SLIDES AND ETC. REFER TO SPECIAL NOTES FOR ADDITIONAL INFORMATION.

POOL [1.19]

5. INDOOR UNIT IS POWERED FROM OUTDOOR UNIT; COORDINATE EXACT NUMBER OF CONDUCTORS BETWEEN UNITS WITH M.C. PRIOR TO ROUGH-IN.

ELECTRICAL AV/TV BOX SCHEDULE

→ 1B-36

VESTIBULE

PLACE 1B-38

[1.2]

		_		
ID	DESCRIPTION	MFGR.	PART #'s	NOTES
V2	2-GANG RECESSED FPTV ENCLOSURE W/ STEEL COVER, 120V RECEPTACLE & DATA PER DWG'S	HUBBELL	NSAV62M/NSAV6C/NSOKPTR	1,2,3

AV AND TV BOX SCHEDULE NOTES:

1P-24,26

RM 1.22 & 1.19P

EMERGENCY -SHUT-OFF

[1.27]

<u>EH-3</u>

POOL EQUIPMENT

- MOUNT TV BOX AT 5'-0"AFF, FIELD VERIFY MOUNTING HEIGHT WITH TV AND OWNER PRIOR TO ROUGH-IN PROVIDE LV CONDUIT(S) AS INDICATED ON DRAWINGS TO ACCESSIBLE CEILING SPACE AND/OR FLOORBOX FOR ROUTING
- OF DATA AND/OR LOW VOLTAGE CABLING.
 PROVIDE REQUIRED MUDRINGS, TERMINATIONS, COVERPLATES, INSERTS AND ETC FOR COMPLETE INSTALLATION.
- 3. PROVIDE REQUIRED MUDRINGS, TERMINATIONS, COVERPLATES, INSERTS AND ETC FOR COMPLETE INSTALLATIO 4. PROVIDE 120V/20A DUPLEX RECEPTACLE, DATA INSERT AND BRUSH PASSTHROUGH INSERT, REFER TO DETAIL.

KITCHEN EQUIPMENT SCHEDULE

ITEM#	EQUIPMENT DESCRIPTION	VOLTS/PH	AMPS	CIRCUIT	WIRE SIZE	CONNECTION	MTG	NOTES
K2	REACH-IN REFRIGERATOR	120 V/1	3 A	1B-52	#12'S	NEMA 5-20R	42" AFF	3
K5	GLASSWASHER, UNDERCOUNTER	208 V/1	30 A	1B-58,60	#8'S	DIRECT	VERIFY	1
K9	ELECTRIC CONVECTION OVEN	120 V/1	12 A	1B-54	#12'S	NEMA 5-20R	ABOVE	3
							COUNTER	
K11	REACH-IN FREEZER	120 V/1	4 A	1B-52	#12'S	NEMA 5-20R	42" AFF	3
K13	SANDWICH PREP. REFRIGERATOR	120 V/1	4 A	1B-56	#12'S	NEMA 5-20R	42" AFF	3
K14	REACH-IN REFRIGERATOR	120 V/1	3 A	1B-56	#12'S	NEMA 5-20R	42" AFF	3

KITCHEN EQUIPMENT SCHEDULE NOTES:

- 1. E.C. SHALL COORDINATE MTG HEIGHT AND ROUGH-IN REQUIREMENTS WITH EQUIPMENT SUPPLIER PRIOR TO ROUGH-IN.
- PROVIDE WITH LOCK-OUT TYPE BREAKER IN PANEL.
 UTILIZE GFCI TYPE CIRCUIT BREAKER FOR EQUIPMENT.
- 4. E.C. SHALL PROVIDE AND INSTALL FUSED DISC. AT UNIT; FUSE PER EQUIPMENT NAMEPLATE.

GENERAL KITCHEN EQUIPMENT NOTES:

- REFER TO KITCHEN CONSULTANT DRAWINGS FOR ADDITIONAL INFORMATION AND ELECTRICAL REQUIREMENTS.
- REFER TO KITCHEN HOOD SHOP DRAWINGS FOR ADDITIONAL INFROMATION AND ALL REQUIRED ELECTRICAL CONNECTIONS.

POOL EQUIPMENT SCHEDULE

									
ITEM#	EQUIPMENT DESCRIPTION	VOLTS/PH	HP	AMPS	CIRCUIT	WIRE SIZE	DISCONNECT	STARTER SIZE	NOTES
P1	GAS POOL HEATER	120 V/1	-	5 A	1P-15	#12'S	30 A NON-FUSED/4X	NONE	2
P1	GAS POOL HEATER	120 V/1	-	5 A	1P-13	#12'S	30 A NON-FUSED/4X	NONE	2
P1	GAS POOL HEATER	120 V/1	-	5 A	1P-17	#12'S	30 A NON-FUSED/4X	NONE	2
P2	POOL CIRCULATION PUMP	208 V/1	3	16 A	1P-31,33	#10'S	60 A FUSED/4X	SIZE 1	2,4
P3	SPA CIRCULATION PUMP	208 V/1	3	16 A	1P-32,34	#10'S	60 A FUSED/4X	SIZE 1	2,4
P4	SPA JET PUMP	208 V/1	3	16 A	1P-36,38	#10'S	60 A FUSED/4X	SIZE 1	2,4
P4	SPA JET PUMP	208 V/1	3	16 A	1P-28,30	#10'S	60 A FUSED/4X	SIZE 1	2,4
P5	WATER SLIDE PUMP	208 V/1	10	40 A	1P-35,37	#4'S	100 A FUSED/4X	SIZE 2	2,4
P5	WATER SLIDE PUMP	208 V/1	10	40 A	1P-39,41	#4'S	100 A FUSED/4X	SIZE 2	2,4
P6	WADING POOL CIRCULATION	208 V/1	3	16 A	1P-27,29	#10'S	60 A FUSED/4X	SIZE 1	2,4

POOL EQUIPMENT SCHEDULE NOTES:

PUMP

#10's

1B-66,68

DRYER DRYER DRYER

∐IRONER∭

1B-57.59_ #10's

- 1. E.C. SHALL COORDINATE MTG HEIGHT AND ROUGH-IN REQUIREMENTS WITH EQUIPMENT SUPPLIER PRIOR TO ROUGH-IN.
- 2. E.C. SHALL PROVIDE GFCI PROTECTION FOR EQUIPMENT PER NEC 680.21(C), COORDINATE WITH POOL CONTRACTOR.
- 3. E.C. SHALL PROVIDE AND INSTALL LOCAL DISCONNECT AS INDICATED IN SCHEDULE; FUSE PER EQUIPMENT NAMEPLATE.
- 4. E.C. SHALL PROVIDE AND INSTALL COMBINATION MOTOR STARTER/DISCONNECT FOR CONTROL OF PUMP; PROVIDE WITH (2) SETS OF NO/NC CONTACTS, CONTROL XFMR AND ETC. COORDINATE CONTROL AND CONNECTIONS WITH POOL EQUIPMENT CONTRACTOR. FUSE PER EQUIPMENT NAMEPLATE

GENERAL POOL EQUIPMENT NOTES:

PRIOR TO ANY ROUGH-IN OR INSTALLATION E.C. SHALL COORDINATE ALL ELECTRICAL REQUIREMENTS FOR POOL EQUIPMENT WITH POOL CONTRACTOR AND SHOP DRAWINGS, INCLUDING BUT NOT LIMITED TO; MOTOR CIRCUIT REQUIREMENTS, POOL LIGHTING, PUMP CONTROLS, E-STOP CONNECTIONS AND ETC.

E5.3

CARA CARB

LTG LTG

CENTER [1.26]

EQUIP [1.7]

GENERAL NOTES:

A. REFER TO SYMBOL SCHEDULE SHEET FOR PROJECT
GENERAL NOTES AND GENERAL NOTES ASSOCIATED WITH
THE INSTALLATION OF EACH SYSTEM, INCLUDINB BUT NOT
LIMITED TO; LIGHTING, POWER, FIRE ALARM, SPECIAL
SYSTEMS, ETC.

SPECIAL NOTES:

- ALL WIRING METHODS AND INSTALLATION OF ALL POOL RELATED EQUIPMENT SHALL BE PERFORMED IN ACCORDANCE WITH NEC ARTICLE 680.
- E.C. SHALL PROVIDE AN EQUIPOTENTIAL GROUND GRID IN POOL DECK AND POOL EQUIPMENT ROOM SLAB PER NEC 680
- E.C. SHALL PROVIDE ALL BONDING OF POOL EQUIPMENT, LADDERS, PIPING, MOTORS AND ETC. TO THE EQUIPOTENTIAL GROUNDING GRID UTILIZING #6 Cu GROUND.
- E.C. SHALL REFER TO POOL CONSULTANT DRAWINGS FOR ADDITIONAL WORK AND REQUIREMENTS.

| KEY NOTES:

- E.C. SHALL PROVIDE AND INSTALL EMERGENCY TWO-WAY COMMUNICATION SYSTEM IN ACCORDANCE WITH IBC 1009.8. SYSTEM SHALL BE CORNELL 4200 SERIES OR EQUAL, REFER TO DETAILS AND SPECIFICATIONS FOR ADDITIONAL INFORMATION. PROVIDE ALL REQUIRED COMPONENTS FOR COMPLETE INSTALLATION, INCLUDING BUT NOT LIMITED TO; MASTER STATION, CALL STATIONS, AUTO DIALER, BACKBOXES, WIRING AND ETC. PROVIDE REQUIRED PHONE LINE/FACP INTERFACE FOR 911 CONNECTION. COORDINATE LOCATION OF MASTER STATION WITH LOCAL AHJ PRIOR TO ROUGH-IN.
- 2 CONNECTION TO AUTOMATIC DOORS; FIELD VERIFY CONNECTION LOCATION AND REQUIREMENTS WITH EQUIPMENT INSTALLERS. PROVIDE ALL REQUIRED ROUGH-IN AND CONNECTIONS.
- 3 RECEPTACLE(S) AND DATA OUTLETS INSTALLED IN MILLWORK, COORDINATE EXACT LOCATION WITH MILLWORK INSTALLER SO THAT DEVICE ARE NOT INSTALLED BEHIND CABINETRY.
- 4 CONNECTION TO LAUNDRY EQUIPMENT, E.C. SHALL PROVIDE AND INSTALL LOCAL DISCONNECT SWITCH FOR EACH PIECE OF EQUIPMENT.
- 5 CONNECTION TO POOL/SPA LIGHT AS REQUIRED BY POOL CONTRACTOR, COORDINATE ROUGH-IN AND CONNECTIONS WITH POOL CONTRACTOR AND SHOP DRAWINGS PRIOR TO ROUGH-IN.
- 6 ALL ELECTRICAL EQUIPMENT, RACEWAY AND ETC. INSTALLED IN THIS ROOM SHALL BE SUITABLE FOR CORROSIVE, WET LOCATION PER NEC SECTION 680. ALL METAL PIPING, PUMPS AND ETC. SHALL BE BONDED TOGETHER AND CONNECTED TO POOL EQUIPOTENTIAL GROUNDING SYSTEM.
- 7 MOTORIZED DAMPER TO BE INTERLOCKED WITH HEATED-ROLL IRON PER MECH. CONTRACTOR. COORDINATE WITH M.C. PRIOR TO ROUGH-IN.
- WITH M.C. PRIOR TO ROUGH-IN.

 8 MOTORIZED DAMPER TO BE INTERLOCKED WITH GAS DRYERS PER MECH. CONTRACTOR. COORDINATE WITH M.C. PRIOR TO ROUGH-IN.
 - RECEPTACLE FOR GAS FIRED WATER HEATER, COORDINATE EXACT LOCATION WITH MECHANICAL CONTRACTOR PRIOR TO ROUGH-IN
- 10 E.C. SHALL PROVIDE AND INSTALL EMERGENCY SHUT-OFF PUSH BUTTON AS DIRECTED BY POOL EQUIPMENT INSTALLER. E-STOP SHALL SHUT OFF ALL POOL EQUIPMENT AND PUMPS. REFER TO POOL EQUIPMENT SHOP DRAWINGS FOR ADDITIONAL INFORMATION.

REVISION #3 - ADDENDU

ANS

HOTEL
TWIN FALLS, ID
ENLARGED POW

ks Architecture ure/planning ______

aughlin Ricks Archanilar architecture/plannil

DATE: 5/6/2022
BP SAM
Drawn Checked

P.E. #:2215


Engineering Inc.

1823 E. Center
Pocatello, Idaho 83201
tel (208) 232-4439
www.payneengineeringinc.com

13053
P.E.#:2215
Engineerin
1823 E. Center
Pocatello, Idaho
tel (208) 232-44
www.payneengi

1 MAIN LEVEL - ENLARGED POWER/DATA PLAN

SCALE: 1/8" = 1'-0"

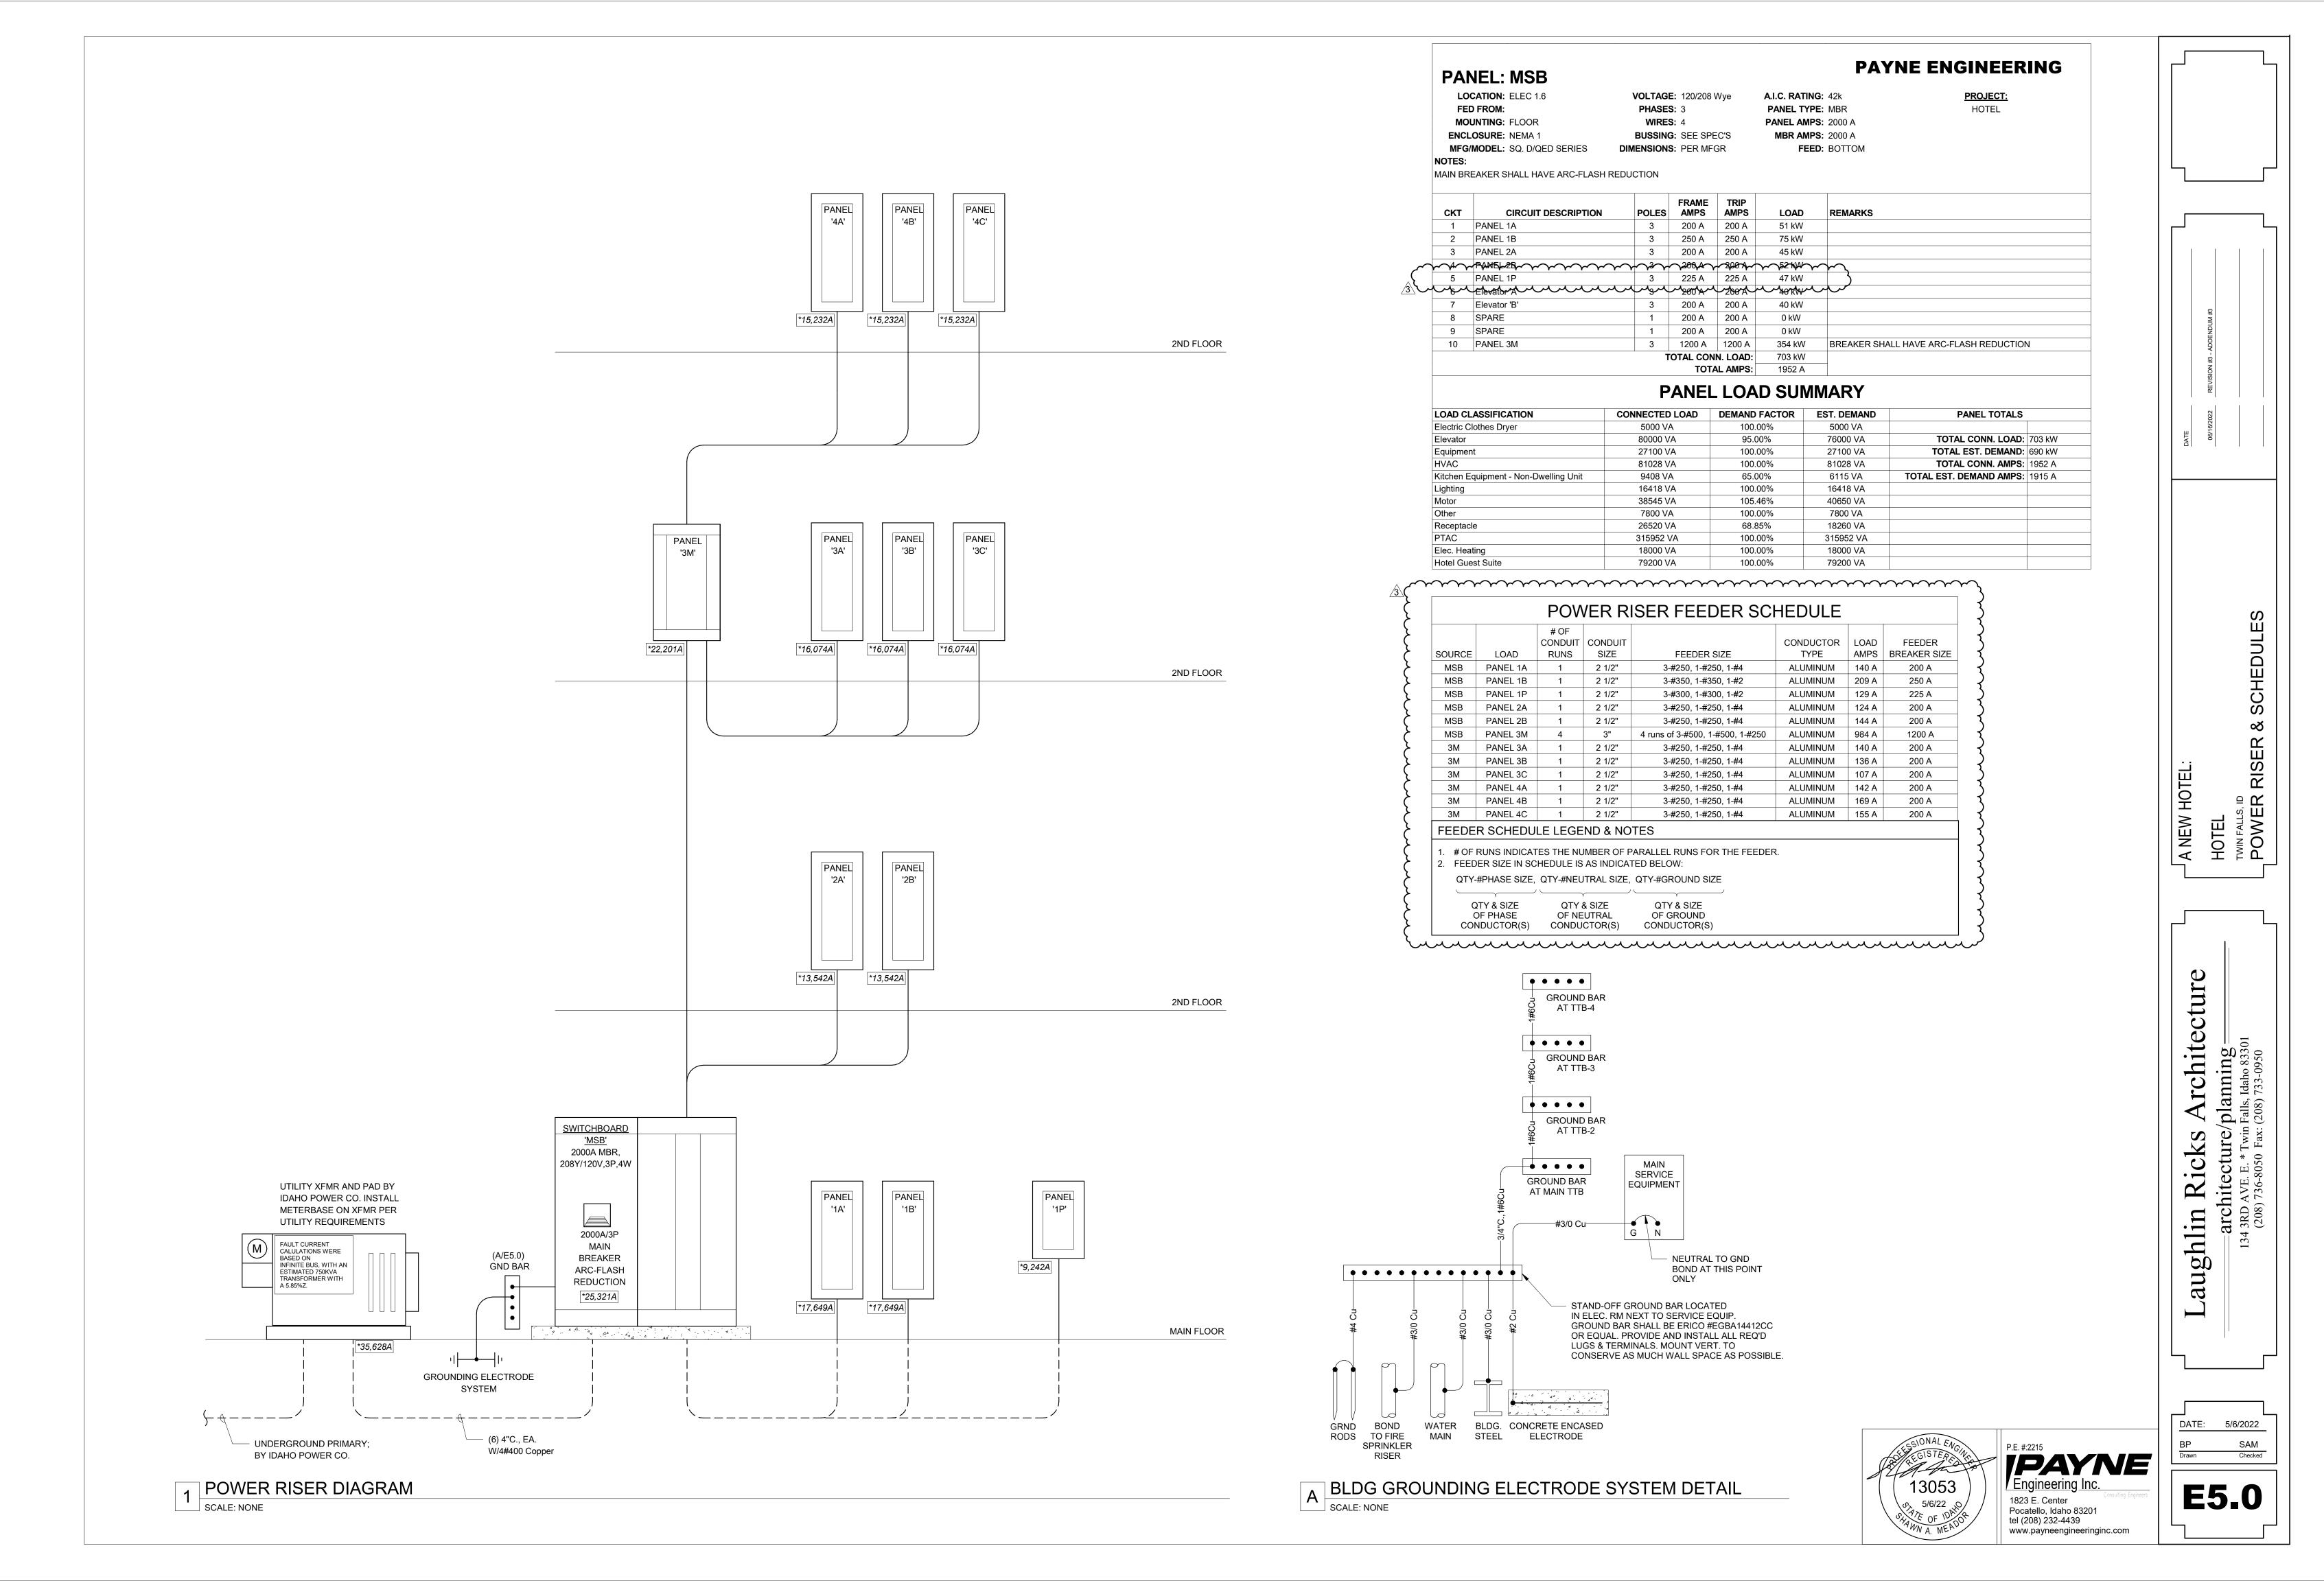

	MF NOTE	FED FROM: MSB MOUNTING: SURFACE NCLOSURE: NEMA 1 G & MODEL: SQ. D/NQ SERIES SS: VIDE WITH INTEGRAL SURGE PR		BU DIMEN		S: 4 G: See	E SPEC W x 5.8'			PANEL PANEL MBR	AMPS	6: 40 6: N/	0 A		HOTEL	<u>^3</u>		E	FED FROM: MSB MOUNTING: SURFACE NCLOSURE: NEMA 1 G & MODEL: SQ. D/NQ SES:
ζ'	\sim	\cdots	$\overline{}$	$ \uparrow $		$\overbrace{}$	~~	~~	\sim	\sim	~~	~	~~~	$\overline{}$		\\\\\\\\\\\\\\\\\\\\\\\\\\\\\\\\\\\\\\	7		
ζ	СКТ	CIRCUIT DESCRIPTION	NOTE	AMPS	P		A	ı	В	С		Р	AMPS	NOTE	CIRCUIT DESCRIPTION	СКТ	{	СКТ	CIRCUIT DESCRIPT
7	1	Lighting - Site	LCP	20 A	1	600	400					1	20 A		Elevator Pit	2] {	1	SPARE
کم	3	Sign Lighting	LCP	20 A	1			1200	293			1	20 A		Elevator Equip. Room	4	_ } {	3	SPARE
ځ	5	Receptacle - Landscape	LCP	20 A	1					360	500	1	20 A		Elev. A - Car Ltg	6	.	5	Hotel Guest Suite 104
\	7	Receptacle - Landscape	LCP	20 A	1	360	500				-	1	20 A		Elev. B - Car Ltg	8		7	Hotel Guest Suite 104
(9	Building Signage	LCP	20 A	1			1200	500			1	20 A		FACP	10	\ \	9	Hotel Guest Suite 106
(11	Building Signage	LCP	20 A	1	4000	044			1200	900	1	20 A		Receptacle - TTB	12	 	11	Hotel Guest Suite 106
ζ	13	Building Signage	LCP	20 A	1	1200	811	1100	E40			1	20 A		Receptacle	14	ኝ	13	Hotel Guest Suite 108
۲	15 17	Lighting - Exterior Lighting - Exterior	LCP LCP	20 A 20 A	1			1180	540	1220	2000	1	20 A 25 A		Receptacle Elec. Heating	16	∤	15 17	Hotel Guest Suite 108 Hotel Guest Suite 110
کم	19	Lighting - Pool	LCP	20 A	1	15/10	2000			1220	2000	1	25 A		Elec. Heating	20	∤ {	19	Hotel Guest Suite 110
\	21	Lighting	LOF	20 A	1	1340	2000	810	1080	1		1	20 A		Receptacle	22	∤	21	Hotel Guest Suite 112
}	23	Lighting		20 A	1			010	1000	1335	720	1	20 A		Receptacle	24	>	23	Hotel Guest Suite 112
(25	Lighting		20 A	1	790	900			.000		1	20 A		Receptacle	26	∤	25	Hotel Guest Suite 114
\langle	27	Lighting		20 A	1			777	360			1	20 A		Receptacle	28	13	27	Hotel Guest Suite 114
(29	Lighting - Stairwell		20 A	1					595	360	1	20 A		Receptacle	30	{	29	Hotel Guest Suite 101
کم	31	Lighting - Stairwell		20 A	1	625	360	-				1	20 A		Receptacle	32	↑	31	Hotel Guest Suite 101
کے	33	SPARE		20 A	1			0	1080			1	20 A		Receptacle	34	1 /	33	Hotel Guest Suite 103
}	35	SPARE		20 A	1					0	720	1	20 A		Receptacle	36	1)	35	Hotel Guest Suite 103
(37	SPARE		20 A	1	0	560					1	20 A		Receptacle	38	13	37	Hotel Guest Suite 105
\langle	39	SPARE		20 A	1		·	0	720			1	20 A		Receptacle	40] }	39	Hotel Guest Suite 105
(41	SPARE		20 A	1					0	720	1	20 A		Receptacle	42] {	41	Hotel Guest Suite 107
کم	43	SPARE		20 A	1	0	180					1	20 A		Receptacle - Vending Mach.	44		43	Hotel Guest Suite 107
کے	45	SPARE		20 A	1			0	180			1	20 A		Receptacle - Vending Mach.	46	.		Hotel Guest Suite 109
\	47	SPARE		20 A	1					0	180	1	20 A		Receptacle - Ice Mach.	48	↓		Hotel Guest Suite 109
(49	Automatic Doors		20 A	1	1000	720					1	20 A	G	Receptacle - Kitchen	50	\		Hotel Guest Suite 111
(51	Receptacle		20 A	1			585	888	540	4440	1	20 A	G	Kitchen Equipment	52	 		Hotel Guest Suite 111
(53	Receptacle		20 A	1	100	0.40			540	1440	1	20 A	G	Kitchen Equipment	54	₹		Hotel Guest Suite 113
ځ	55	Washer	G	20 A	1	180	840	0500	0400	_	i	1	20 A	G	Kitchen Equipment	56	∤	55	Hotel Guest Suite 113
کے	57	Electric Clothes Dryer	G	30 A	2			2500	3120	2500	2420	2	40 A		Kitchen Equipment	58	∤		Hotel Guest Suite 115 Hotel Guest Suite 115
ζ	59 - 1 61-1			- L	٠,	~\tr∩a	L697 /		<i>ــ</i> ـــ	2500	3120	~ .	<u> </u>	<u> </u>		60	رہا		SPARE
	63	Gas Dryer		20 A	2	100	C 000 C	700	697		Ĭ	2	15 A		HVAC FAN COILS	64	1		SPARE
	65							700	001	700	75					66			SPARE
	67	Gas Dryer		20 A	2	700	75					2	15 A		HVAC FAN COILS	68	-		SPARE
	69							700	700			_	 -			70			SPARE
	71	Gas Dryer		20 A	2					700	700	2	20 A		Heated Roll Ironer	72			SPARE
	73					2167	2167									74			
	75	Washer		30 A	3			2167	2167			3	30 A		Washer	76			
	77									2167	2167					78	1		TOTAL E
	79					2167	0									80			NOTES:
	81	Washer		30 A	3			2167	0			3	20 A		Surge Protection Device	82			RC-FAULT BREAKER
	83									2167	0					84		5 = 51	HUNT-TRIP BREAKER
				OTAL L) kVA		kVA	26.9 l									
		TOTAL FOTIMA		OTAL A			34 A		5 A	230	Α								
	BPK	TOTAL ESTIMA NOTES:	I ED DEN	VIAND A	WP5:			19	5 A								-		
~~	A = A	RC-FAULT BREAKER GP	= GFEPI = GFCI BI	REAKE	R	~~	~~			TO BE F	LOCK-	OUT			CONTROL PANEL	~~	~~	P	ANEL: 2A LOCATION: ELEC 2.2 FED FROM: MSB
	P	ANEL: 1P LOCATION: ELEC 1.22E	•	VOI	_TAG	E : 120	/208 Wy		<u> </u>	A.I.C. R	ATING	P	PAY		ENGINEERING PROJECT:	•		E	MOUNTING: SURFACE INCLOSURE: NEMA 1 G & MODEL: SQ. D/NQ SEES:
		FED FROM: MSB			HASE					PANEL					HOTEL		3		
-		MOUNTING: SURFACE			WIRE					PANEL							3	0:5-	OIDOLUE DECCE
-		NCLOSURE: NEMA 1 G & MODEL: SO D/NO SERIES		BU			SPEC			MBR	AMPS		A OTTOM				{	CKT 1	CIRCUIT DESCRIPT Hotel Guest Suite 201
	IVI	G & MODEL: SO DINO SERIES		DIMPN	OILIN'	っこ ノロ"\	/v x י \	1) X ""H				, H() () \/I				1	1 1	i iotor Guest Guite ZU I

VOLTAGE: 120/208 Wye

PHASES: 3

PANEL: 1B

LOCATION: ELEC 1.6

FED FROM: MSB

PAYNE ENGINEERING

PROJECT:

HOTEL

A.I.C. RATING: 22k

PANEL TYPE: MLO

E	MOUNTING: SURFACE NCLOSURE: NEMA 1 G & MODEL: SQ. D/NQ SERIES SS:	ī			: SEE	SPEC'S				L AMPS R AMPS FEED	3: N/A				
СКТ	CIRCUIT DESCRIPTION	NOTE	AMPS	Р	Į.	4	E	3		3	Р	AMPS	NOTE	CIRCUIT DESCRIPTION	СКТ
1	Receptacle		20 A	1	720	720					1	20 A		Lighting	2
3	Receptacle		20 A	1			900	0			1	20 A	-	SPARE	4
5	Receptacle		20 A	1		ļ			1080	0	1	20 A		SPARE	6
7	Receptacle		20 A	1	360	0					1	20 A		SPARE	8
9	SPARE		20 A	1			0	0			1	20 A		SPARE	10
11	SPARE		20 A	1		ļ			0	2000	1	25 A		Elec. Heating	12
13	Gas Pool Htr	G	20 A	1	600	2000				I	1	25 A		Elec. Heating	14
15	Gas Pool Htr	G	20 A	1			600	201				45.0		LD (4.0 EAN COIL C	16
17	Gas Pool Htr	G	20 A	1		ļ			600	201	2	15 A		HVAC FAN COILS	18
19	SPARE		20 A	1	0	1000						00.4		E	20
21	SPARE		20 A	1			0	1000	1		2	20 A		Elec. Heating	22
23	SPARE		20 A	1		ļ			0	1000				_, ,, ,,	24
25	SPARE		20 A	1	0	1000				ı	2	20 A		Elec. Heating	26
27 29	Wading Pool Circ Pump	G	50 A	2			1664	1664	1664	1664	2	50 A	G	Spa Jet Pump	28 30
31 33	Pool Circ. Pump	G	50 A	2	1664	1664	1664	1664		1	2	50 A	G	Spa Circ. Pump	32 34
35 37	Slide Pump	G	100 A	2	4160	1664		1	4160	1664	2	50 A	G	Spa Jet Pump	36 38
39	Oli de Deserve		400.4				4160	0	1		1	20 A	-	SPARE	40
41	Slide Pump	G	100 A	2				1	4160	0	1	20 A	-	SPARE	42
-	TOTAL ESTIMA	TO	TAL LO	MPS:	15.3 129		13.4 112 13!	2 A	17.9 15	kVA 2 A					
BRK N	NOTES:														
A = AF	RC-FAULT BREAKER GF) = GFEPD = GFCI BR					LCP = R = RE						HLTG (CONTROL PANEL	

minimum minimu

	LOCATION: ELEC 1.6			VOI	ΤΔΩΡ	• 120·	208 Wy	/e		ΔΙΩ	RATING	· 221	k		PROJECT:	
	FED FROM: MSB				ASES		200 vv y	C			L TYPE				HOTEL	
	MOUNTING: SURFACE				VIRES						L AMPS				HOTEL	
F	NCLOSURE: NEMA 1						SPEC'	S			R AMPS					
	G & MODEL: SQ. D/NQ SERIES	s	ı	DIMENS					ł				TTOM			
NOTE		_							-							
	^	-														
	<u>/3\</u>		~~	~~~	\sim	3										
CKT	CIRCUIT DESCRIPTION	ζ	NOTE	AMPS	Р.	\langle	^		В		С	Р	AMPS	NOTE	CIRCUIT DESCRIPTION	СК
1	SPARE SPARE	\leftarrow	NOTE	20 A	1	5 0	A		Ь			1	20 A		SPARE SPARE	2
3	SPARE	\leftarrow		20 A	1	₹		0	0	+	-	1	20 A		SPARE	4
5	Hotel Guest Suite 104	}	A	20 A	1.	}				350	1456		207		OF AIRE	6
7	Hotel Guest Suite 104	}	A	20 A	1 •	350	1456			330	1430	2	20 A		PTAC 104	8
9	Hotel Guest Suite 106	\leftarrow	A	20 A	1 .) 330	1700	350	1456	+	-					10
11	Hotel Guest Suite 106	\leftarrow	A	20 A	1	}		300	1,400	350	1456	2	20 A		PTAC 106	12
13	Hotel Guest Suite 108	۲	A	20 A	1	350	1456	1		330	1700					14
15	Hotel Guest Suite 108	}	A	20 A	1.		1730	350	1456	+		2	20 A		PTAC 108	16
17	Hotel Guest Suite 110	}	A	20 A	1 •	₽		330	1730	350	1456					18
19	Hotel Guest Suite 110	{	A	20 A	1.	350	1456			300	1 700	2	20 A		PTAC 110	20
21	Hotel Guest Suite 112	\leftarrow	A	20 A	1	}	1400	350	1456							22
23	Hotel Guest Suite 112	<u> </u>	A	20 A	1	Ĭ.				350	1456	2	20 A		PTAC 112	24
25	Hotel Guest Suite 114	7	A	20 A	1	350	1456				1 100					26
27	Hotel Guest Suite 114	>	Α	20 A	1	}	1	350	1456			2	20 A		PTAC 114	28
29	Hotel Guest Suite 101	7	Α	20 A	1 .)				350	1456					30
31	Hotel Guest Suite 101	$\langle -$	Α	20 A	1	350	1456					2	20 A		PTAC 101	32
33	Hotel Guest Suite 103	$\overline{\ }$	Α	20 A	1	}		350	1456							34
35	Hotel Guest Suite 103	\leftarrow	Α	20 A	1	\langle				350	1456	2	20 A		PTAC 103	36
37	Hotel Guest Suite 105	>	Α	20 A	1 .	350	1456								DT. 0.405	38
39	Hotel Guest Suite 105	>	Α	20 A	1 -	\rangle		350	1456			2	20 A		PTAC 105	40
41	Hotel Guest Suite 107	1	Α	20 A	1.)				350	1456	_			DT. 0.407	42
43	Hotel Guest Suite 107	$\langle -$	Α	20 A	1	350	1456	-				2	20 A		PTAC 107	44
45	Hotel Guest Suite 109	(Α	20 A	1	\	1	350	1456	1		^	00.4		DTAC 400	46
47	Hotel Guest Suite 109	7	Α	20 A	1 .	K				350	1456	2	20 A		PTAC 109	48
49	Hotel Guest Suite 111	7	Α	20 A	1 -	350	1456				'		20.4		DTAC 444	50
51	Hotel Guest Suite 111	>	Α	20 A	1.	\rangle	•	350	1456			2	20 A		PTAC 111	52
53	Hotel Guest Suite 113	{	Α	20 A	1)				350	1456	2	20.4		DTAC 112	54
55	Hotel Guest Suite 113	$\overline{\zeta}$	Α	20 A	1	350	1456				•	2	20 A		PTAC 113	56
57	Hotel Guest Suite 115	7	Α	20 A	1 .	(350	1456			2	20.4		DTAC 115	58
59	Hotel Guest Suite 115	۲	Α	20 A	1 •	_				350	1456	2	20 A		PTAC 115	60
61	SPARE	7	، بتريير	20 A	ىر1	0	0					1	20 A		SPARE	62
63	SPARE			20 A	1			0	0			1	20 A		SPARE	64
65	SPARE			20 A	1					0	0	1	20 A		SPARE	66
67	SPARE		-	20 A	1	0	0					1	20 A		SPARE	68
69	SPARE			20 A	1			0	0			1	20 A		SPARE	70
71	SPARE			20 A	1					0	0	1	20 A		SPARE	72
				OTAL LO			3 kVA		3 kVA		l kVA					
		_		OTAL AI		13	85 A		85 A	15	51 A					
	TOTAL ESTIN	ITAN	ED DEM	IAND A	MPS:			14	0 A							

GP = GFEPD BREAKER

G = GFCI BREAKER

BRK NOTES:

A = ARC-FAULT BREAKER

S = SHUNT-TRIP BREAKER

GP = GFEPD BREAKER

G = GFCI BREAKER

LCP = CRKT TO BE ROUTED THROUGH LTG CONTROL PANEL

LCP = CRKT TO BE ROUTED THROUGH LTG CONTROL PANEL

R = RED HANDLED, LOCK-OUT TYPE

PAYNE ENGINEERING

PANEL: 3M

LOCATION: ELEC 3.2

MOUNTING: SURFACE

FED FROM: MSB

R = RED HANDLED, LOCK-OUT TYPE

PAYNE ENGINEERING

E	^			PH V BUS IMENS	IASES VIRES SSING SIONS	8: 3 8: 4 8: See	/208 Wy E SPEC'S W x 5.8"	S		PANE PANE	RATING L TYPE L AMPS R AMPS FEED	E: ML S: 229 S: N/A	O 5 A		PROJECT: HOTEL	
	(3)	د	\\\\\\\\\\\\\\\\\\\\\\\\\\\\\\\\\\\\\\	~~		}										
СКТ	CIRCUIT DESCRIPTION	ر	NOTE A	AMPS	Р	3	Α	I	В	(С	Р	AMPS	NOTE	CIRCUIT DESCRIPTION	СКТ
1	Hotel Guest Suite 201		Α	20 A	1	350	1456					2	20 A		PTAC 201	2
3	Hotel Guest Suite 201	_	Α	20 A	1	3		350	1456				2071		1710 201	4
5	Hotel Guest Suite 203	_	Α	20 A	1	ζ	_			350	1456	2	20 A		PTAC 202	6
7	Hotel Guest Suite 203	١.	Α	20 A	1 .	$\frac{1}{3}$ 350	1456			-		_				8
9	Hotel Guest Suite 205	۷.	Α	20 A	1	\geqslant		350	0			2	20 A		SPARE	10
11	Hotel Guest Suite 205			20 A	1	5				350	0					12
13	Hotel Guest Suite 207	-		20 A	1	350	0					2	20 A		SPARE	14
15	Hotel Guest Suite 207	_		20 A	1	ζ		350	0							16
17	Hotel Guest Suite 209	-		20 A	1 .	₹				350	1456	2	20 A		PTAC 209	18
19	Hotel Guest Suite 209	٤		20 A	1	350	1456		1	_						20
21	Hotel Guest Suite 211			20 A	1			350	1456			2	20 A		PTAC 211	22
23	Hotel Guest Suite 211			20 A	1	3	1			350	1456					24
25	Hotel Guest Suite 213	•		20 A	1	350	1456	0.50	4.450			2	20 A		PTAC 213	26
27	Hotel Guest Suite 213	_		20 A	1 .	\langle		350	1456	0.50	4.450					28
29	Hotel Guest Suite 215			20 A	1	\ \	4.450			350	1456	2	20 A		PTAC 215	30
31	Hotel Guest Suite 215	<u> </u>		20 A	1	350	1456	250	4.450							32
33	Hotel Guest Suite 217			20 A	1	5		350	1456	0.50	4.450	2	20 A		PTAC 217	34
35	Hotel Guest Suite 217	_		20 A	1	3	4.450			350	1456					36
37	Hotel Guest Suite 219	_		20 A	1 .	350	1456	050	4.450			2	20 A		PTAC 219	38
39	Hotel Guest Suite 219	<u> </u>		20 A	1	₹		350	1456	0.50	4.450					40
41	Hotel Guest Suite 221	<u> </u>		20 A	1)	4.450			350	1456	2	20 A		PTAC 221	42
43	Hotel Guest Suite 221			20 A	1	350	1456	250	4.450							44
45	Hotel Guest Suite 223			20 A	1	3		350	1456	250	1156	2	20 A		PTAC 223	46
47	Hotel Guest Suite 223	<u>-</u>		20 A	1	350	1456			350	1456					48
49	Hotel Guest Suite 225	-		20 A	1	350	1430	350	1456			2	20 A		PTAC 225	50 52
51	Hotel Guest Suite 225 Hotel Guest Suite 227	<u> </u>		20 A 20 A	1	$\{$		350	1400	350	1456					54
55	Hotel Guest Suite 227 Hotel Guest Suite 227			20 A 20 A	1	350	1456			350	1430	2	20 A		PTAC 227	56
57	SPARE			20 A 20 A	1	5330	1730	0	0			1	20 A		SPARE	58
59	SPARE	V		20 A	1					0	0	1	20 A		SPARE	60
61	SPARE			20 A	1	0	0					1	20 A		SPARE	62
63	SPARE			20 A	1			0	0	-		1	20 A		SPARE	64
65	SPARE			20 A	1					0	0	1	20 A		SPARE	66
67	SPARE			20 A	1	0	0					1	20 A		SPARE	68
69	SPARE			20 A	1			0	0			1	20 A		SPARE	70
71	SPARE			20 A	1					0	0	1	20 A		SPARE	72
' '					Α	16.6	6 kVA	13.3	3 kVA		kVA	'		<u> </u>		12
					A		10 A		1 A		5 A					
					Α				4 A							

PAYNE ENGINEERING PANFI · 2R

I AILL. 2D			
LOCATION: ELEC 2.2	VOLTAGE : 120/208 Wye	A.I.C. RATING: 22k	PROJECT:
FED FROM: MSB	PHASES: 3	PANEL TYPE: MLO	HOTEL
MOUNTING: SURFACE	WIRES: 4	PANEL AMPS: 225 A	
ENCLOSURE: NEMA 1	BUSSING: SEE SPEC'S	MBR AMPS: N/A	
MFG & MODEL: SQ. D/NQ SERIES	DIMENSIONS: 20"W x 5.8"D x *"H	FEED: BOTTOM	
NOTES:			
^			

01/2		}				{	_		_			_	41470			01/7
CKT	CIRCUIT DESCRIPTION	} _		AMPS	Р	←	A 450	l	В	C	;	Р	AMPS	NOTE	CIRCUIT DESCRIPTION	CKT
1	Hotel Guest Suite 202	}	A	20 A	1	350	1456	0.50	4.450			2	20 A		PTAC 202	2
3	Hotel Guest Suite 202	<u>(</u>	A	20 A	1	}		350	1456	0.50	4.450					4
	Hotel Guest Suite 204	\leftarrow	Α	20 A	1	ξ				350	1456	2	20 A		PTAC 204	6
7	Hotel Guest Suite 204	خ	Α	20 A	1	350	1456				-					8
9	Hotel Guest Suite 206	} _	Α	20 A	1	γ		350	1456			2	20 A		PTAC 206	10
11	Hotel Guest Suite 206	{	Α	20 A	1)				350	1456					12
13	Hotel Guest Suite 208	\subset	Α	20 A	1	350	1456		I			2	20 A		PTAC 208	14
15	Hotel Guest Suite 208	\leftarrow	Α	20 A	1	₹		350	1456							16
17	Hotel Guest Suite 210	ح	Α	20 A	1	₹	T			350	1456	2	20 A		PTAC 210	18
19	Hotel Guest Suite 210	}	Α	20 A	1	350	1456									20
21	Hotel Guest Suite 212	{	Α	20 A	1	5		350	1456			2	20 A		PTAC 212	22
23	Hotel Guest Suite 212	Ç	Α	20 A	1	}				350	1456					24
25	Hotel Guest Suite 214	_	Α	20 A	1	3 50	1456					2	20 A		PTAC 214	26
27	Hotel Guest Suite 214		Α	20 A	1.	{		350	1456							28
29	Hotel Guest Suite 216	<u>}</u>	Α	20 A	1)				350	1456	2	20 A		PTAC 216	30
31	Hotel Guest Suite 216	{	Α	20 A	1	350	1456									32
33	Hotel Guest Suite 218	Ç	Α	20 A	1	}		350	1456			2	20 A		PTAC 218	34
35	Hotel Guest Suite 218	\succeq	Α	20 A	1	ζ				350	1456					36
37	Hotel Guest Suite 220	<u>}</u>	Α	20 A	1 .	350	1456					2	20 A		PTAC 220	38
39	Hotel Guest Suite 220	<u> </u>	Α	20 A	1	\langle		350	1456							40
41	Hotel Guest Suite 222	<u>{</u>	Α	20 A	1	<u> </u>				350	1456	2	20 A		PTAC 222	42
43	Hotel Guest Suite 222	Ç	Α	20 A	1	350	1456									44
45	Hotel Guest Suite 224	کے	Α	20 A	1	₹		350	1456			2	20 A		PTAC 224	46
47	Hotel Guest Suite 224	}_	Α	20 A	1	}				350	1456					48
49	Hotel Guest Suite 226	\	Α	20 A	1	350	1456					2	20 A		PTAC 226	50
51	Hotel Guest Suite 226	(Α	20 A	1	}		350	1456							52
53	Receptacle	<u>\</u>	w	~20A	ىرىد					720	900	1	20 A		Receptacle	54
55	Receptacle			20 A	1	540	720					1	20 A		Receptacle - Ice Mach.	56
57	NAC			20 A	1			500	0	L.,		1	20 A		SPARE	58
	Lighting			20 A	1					1455	0	1	20 A		SPARE	60
61	SPARE			20 A	1	0	0					1	20 A		SPARE	62
63	SPARE			20 A	1			0	0			1	20 A		SPARE	64
65	SPARE			20 A	1					0	0	1	20 A		SPARE	66
67	SPARE			20 A	1	0	0					1	20 A		SPARE	68
	SPARE			20 A	1			0	0			1	20 A		SPARE	70
71	SPARE			20 A	1					0	0	1	20 A		SPARE	72
				OTAL LO			kVA		kVA	17.5						
				OTAL AI	+	14	7 A		0 A	147	7 A					
	TOTAL ESTIN	IATE	D DEM	iand ai	MPS:			14	4 A							

BRK NOTES:		
A = ARC-FAULT BREAKER	GP = GFEPD BREAKER	LCP = CRKT TO BE ROUTED THROUGH LTG CONTROL PANEL
S = SHUNT-TRIP BREAKER	G = GFCI BREAKER	R = RED HANDLED, LOCK-OUT TYPE

VOLTAGE: 120/208 Wye

PHASES: 3

WIRES: 4

	ICLOSURE: NEMA 1 FG/ MODEL: SQ. D/I-LINE ES:	D			5: SEE SPEC'S 5: 44"W x 11.5		MBR AMPS: FEED:					
СКТ	CIRCUIT DESCRIPTION	NOTE	AMPS	P	A	В	С	P	AMPS	NOTE	CIRCUIT DESCRIPTION	СКТ
1					18060 17694							2
3	PANEL 3A		200 A	3	·	16254 17694		3	200 A		PANEL 4A	4
5						·	16254 15888					6
7					16383 20562		'					8
9	PANEL 3B		200 A	3	'	17233 21332		3	200 A		PANEL 4B	10
11						·	15348 18927					12
13					13584 19181		,					14
15	PANEL 3C		200 A	3	·	12445 17895		3	200 A		PANEL 4C	16
17						·	12500 18843					18
19					16139 0		·					20
21	HVAC DH-1A		175 A	3		16139 0		3	100 A		SPARE	22
	1	1	1	1	1							

A.I.C. RATING: 42k

PANEL TYPE: MLO

PANEL AMPS: 1200 A

			_	-			1		-				
23							16139	0					24
		TO	TAL LO	AD : 1	21.6 kVA	119.0 kVA	113.9	kVA					
		TO	TAL AN	IPS:	1020 A	998 A	949) A					
						OAD S							
LOAD C	LASSIFICATION	CON	NECTE	D LOA	D DEMA	AND FACTOR	EST	. DEM	AND		PANEL TOTAL	S	
HVAC			79081	VA		100.00%	79	9081 V	/A				
Lighting			3800	VA		100.00%	3	800 V	A	1	OTAL CONN. LOAD:	354415 VA	
Motor			5040	VA	1	104.29%	5	256 V	A	TO	OTAL EST. DEMAND:	354631 VA	
Other			1000	VA		100.00%	1	000 V	A	T	OTAL CONN. AMPS.:	984 A	
Recepta	cle		7200	VA	•	100.00%	7	'200 V	A	TOTAL E	ST. DEMAND AMPS:	984 A	
PTAC			202384	l VA		100.00%	20	2384 \	VA				
Elec. He	ating		6000	VA	•	100.00%	6	000 V	A				
							1					1	

Hotel Guest Suite	50500 VA	100.00%	50500 VA		
BRK NOTES:	33333	10010011			
A = ARC-FAULT BREAKER	GP = GFEPD BREAKER	LCP = CRKT TO BE	ROUTED THROUGH	LTG CONTROL PANEL	
S = SHUNT-TRIP BREAKER	G = GFCI BREAKER	R = RED HANDLED	, LOCK-OUT TYPE		



PAYNE ENGINEERING

PROJECT:

HOTEL

DATE: 5/6/2022 SAM

JANEW HOTEL:
HOTEL
TWIN FALLS, ID
ELECTRICAL (


shlin Ricks Architecture

== architecture/planning

134 3RD AVE. E. * Twin Falls, Idaho 83301
(208) 736-8050 Fax: (208) 733-0950

Laughlin Ricks

E5.1

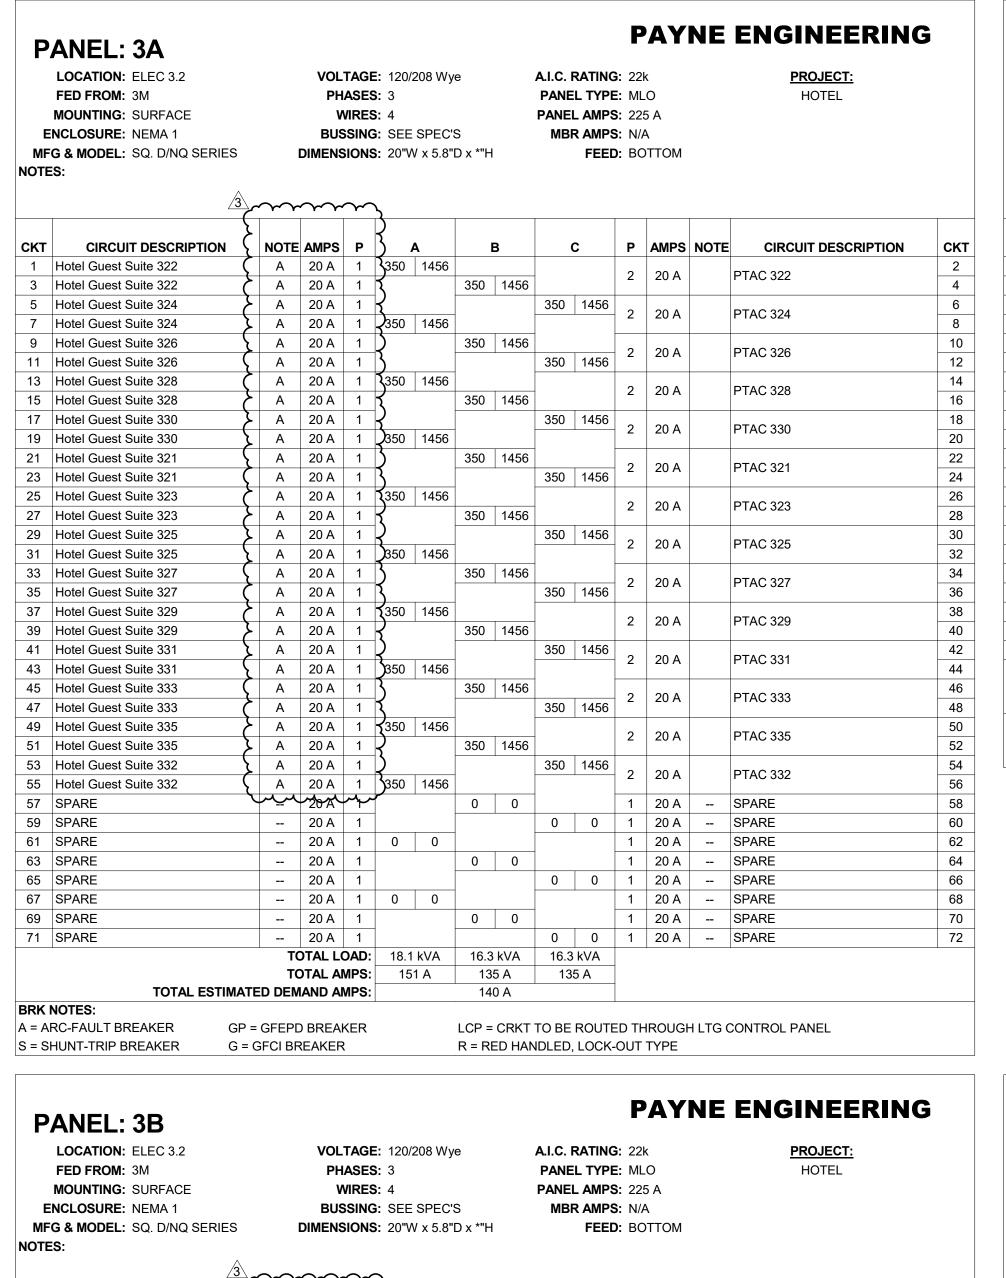

P	ANEL: 3C											r	AT		ENGINEERING	į
	LOCATION: ELEC 3.2			VOL	.TAGI	E: 120/	/208 Wy	⁄e		A.I.C.	RATING	: 221	k		PROJECT:	
	FED FROM: 3M			PH	IASE	S : 3				PANE	L TYPE	: ML	.0		HOTEL	
	MOUNTING: SURFACE			٧	VIRE:	S : 4				PANE	L AMPS	: 22	5 A			
E	NCLOSURE: NEMA 1			BUS	SSING	G: SEE	SPEC'	S		MB	R AMPS	: N/A	4			
	G & MODEL: SQ. D/NQ SERIES	3		DIMENS	SIONS	S : 20"V	V x 5.8"	'D x *"H	l		FEED	: BC	MOTT			
NOTE	ES:															
	<u>/</u> 3	<u>3</u> ~~	~~	\sim	~	``										
СКТ	CIRCUIT DESCRIPTION	}	NOTE	AMPS	Р	3	A		В		С	Р	AMPS	NOTE	CIRCUIT DESCRIPTION	Cł
1	Hotel Guest Suite 309	<u> </u>	A	20 A	1	350	1456	'								2
3	Hotel Guest Suite 309	7	A	20 A	1	1		350	1456	1		2	20 A		PTAC 309	4
5	Hotel Guest Suite 307	>	Α	20 A	1	{				550	1456	_				6
7	Hotel Guest Suite 307	>	Α	20 A	1	3 550	1456					2	20 A		PTAC 307	8
9	Hotel Guest Suite 305	7	А	20 A	1	\rightarrow		350	1456	1			00.4		DT4 0 005	10
11	Hotel Guest Suite 305	{	Α	20 A	1	3				350	1456	2	20 A		PTAC 305	12
13	Hotel Guest Suite 303	$\langle \ \ \rangle$	А	20 A	1	350	1456					2	20.4		PTAC 303	14
15	Hotel Guest Suite 303	$\overline{}$	А	20 A	1	3		350	1456	1		2	20 A		PTAC 303	16
17	Hotel Guest Suite 301	7	А	20 A	1	 {				550	1976	2	30 A		PTAC 301	18
19	Hotel Guest Suite 301	7	Α	20 A	1	₹550	1976					2	30 A		F1AC 301	20
21	Hotel Guest Suite 302	7	Α	20 A	1	\langle		550	1976			2	30 A		PTAC 302	22
23	Hotel Guest Suite 302	}	Α	20 A	1)				550	1976		30 A		1 1/10 302	24
25	Hotel Guest Suite 304	{	Α	20 A	1	350	1456					2	20 A		PTAC 304	26
27	Hotel Guest Suite 304	ζ	Α	20 A	1	3		350	1456				207		1 1/10 304	28
29	Hotel Guest Suite 306	\subset	Α	20 A	1	ζ				350	1456	2	20 A		PTAC 306	30
31	Hotel Guest Suite 306	ځ	Α	20 A	1	₹350	1456									32
33	SPARE	٢	ستىر	20A	لىر	رر		0	2000			1	25 A		Elec. Heating	34
35	SPARE			20 A	1					0	2000	1	25 A		Elec. Heating	36
	SPARE			20 A	1	0	2000					1	25 A		Elec. Heating	38
	SPARE			20 A	1			0	864			1	20 A		EF-9	40
41	SPARE		<u> </u>	20 A	1	ļ				0	0	1	20 A		SPARE	42
				OTAL L			6 kVA		kVA		kVA					
	TOTAL ESTIN	IATI					3 A		4 A 8 A	10	4 A					
BRK	NOTES:	iA I I		IAIND A	IVIP 3.			10	-							
		3P =	: GFEPI) BREA	KER			LCP =	CRKT	TO BF	ROUTE	D TH	IROUGI	HLTG (CONTROL PANEL	
				REAKER							, LOCK-			• •		

E MF	FED FROM: 3M MOUNTING: SURFACE INCLOSURE: NEMA 1 IG & MODEL: SQ. D/NQ SERIES		ı	V BUS		6: 4 6: See	SPEC' V x 5.8"		I		AMPS	6: 22: 6: N//	5 A		HOTEL	
NOTE	:S: 	\														
	<u>/3</u>	<u>3</u> }~	\sim	~~	~~)										
СКТ	CIRCUIT DESCRIPTION	7	NOTE	AMPS	P		A		В		,	Р	AMPS	NOTE	CIRCUIT DESCRIPTION	
1	Hotel Guest Suite 411	7	A	20 A	1	350	1456		ט	,	,	Г.	AIVIFS	NOIL	CIRCUIT DESCRIPTION	
3	Hotel Guest Suite 411	7	Α	20 A	1 1	{	1100	350	1456	_		2	20 A		PTAC 411	
5	Hotel Guest Suite 413	>	Α	20 A	1 -	}			1	350	1456					
7	Hotel Guest Suite 413	>	Α	20 A	1 -	350	1456	1				2	20 A		PTAC 413	
9	Hotel Guest Suite 415	\leftarrow	Α	20 A	1 _	}	1	350	1456	-						
11	Hotel Guest Suite 415	$ \mathcal{C} $	Α	20 A	1	}			1	350	1456	2	20 A		PTAC 415	
13	Hotel Guest Suite 417	7	Α	20 A	1	350	1456	1			-		60:		DTA 0.447	
15	Hotel Guest Suite 417	7	Α	20 A	1 7	<	1	350	1456	-		2	20 A		PTAC 417	
17	Hotel Guest Suite 419	7	Α	20 A	1 -	1				350	1456		00.4		DTA C 440	
19	Hotel Guest Suite 419	>	Α	20 A	1 -	350	1456	1				2	20 A		PTAC 419	
21	Hotel Guest Suite 408	7	Α	20 A	1)		350	1456		-		20.4		DTA C 400	
23	Hotel Guest Suite 408	(Α	20 A	1	}				350	1456	2	20 A		PTAC 408	
25	Hotel Guest Suite 410	\	Α	20 A	1	350	1456	1					20.4		DTAC 440	
27	Hotel Guest Suite 410	7	Α	20 A	1 7	{		350	1456			2	20 A		PTAC 410	
29	Hotel Guest Suite 412	7	Α	20 A	1 -	{				350	1456	2	20 A		PTAC 412	
31	Hotel Guest Suite 412	7	Α	20 A	1.	350	1456						20 A		F 1AC 412	
33	Hotel Guest Suite 414	7	Α	20 A	1)		350	1456			2	20 A		PTAC 414	
35	Hotel Guest Suite 414	{	Α	20 A	1	}				350	1456		207		1 1/0 414	
37	Hotel Guest Suite 416	ζ	Α	20 A	1	350	1456					2	20 A		PTAC 416	
39	Hotel Guest Suite 416	_	Α	20 A	1 7	{		350	1456				2071		1 1710 110	
41	Hotel Guest Suite 418	٦	Α	20 A	1 -	₹				350	1456	2	20 A		PTAC 418	
43	Hotel Guest Suite 418	}	Α	20 A	1 -	350	1456									
45	Hotel Guest Suite 420	>	Α	20 A	1)		350	1456			2	20 A		PTAC 420	
47	Hotel Guest Suite 420	{	Α .	20 A	1)	T	-		350	1456					
49	Lighting	_	سسر	2012		955	500			-		1	20 A		NAC	
51	Lighting			20 A	1	-		965	1260		F 40	1	20 A		Receptacle	
53	SPARE			20 A	1		700	-		0	540	1	20 A		Receptacle	
55	SPARE			20 A	1	0	720		700			1	20 A		Receptacle les Mach	
57	SPARE			20 A	1	1		0	720			1	20 A		Receptacle - Ice Mach.	
59	SPARE			20 A	1		0	-		0	0	1	20 A		SPARE	_
61 63	SPARE SPARE			20 A 20 A	1	0	0	0	0		-	1	20 A 20 A		SPARE SPARE	
65	SPARE			20 A	1	+		0	U	0	0	1	20 A		SPARE	
67	SPARE			20 A	1	0	3939	+			U	- 1	20 A		OFARE	
69	SPARE			20 A	1	0	J938	0	3939			3	60 A		HVAC OU-1	
71	SPARE			20 A	1	+			<u> </u>	0	3939	J	00 A		1114/10/00-1	
	S. 7 II IL			OTAL LO	OAD:	20.6	6 kVA	21.3	3 kVA	18.9						
				OTAL A			'3 A		80 A		B A					
	TOTAL ESTIM	ATE							9 A							
BRK	NOTES:					•										

PANEL: 4B

PAYNE ENGINEERING

E	FED FROM: 3M MOUNTING: SURFACE NCLOSURE: NEMA 1 G & MODEL: SQ. D/NQ SERIES S:			V		6: 4 6: SEE			I	PANE	L TYPE L AMPS R AMPS FEED	6: 22: 6: N/A	5 A		HOTEL	
СКТ	CIRCUIT DESCRIPTION	}		AMPS	~ P	} ,	<u> </u>		В		c	P	AMPS	NOTE	CIRCUIT DESCRIPTION	CK
	Hotel Guest Suite 311	7	A	20 A	1	350	1456			`	,	•	AMI O			2
	Hotel Guest Suite 311	7	A	20 A	1	355		350	1456	1		2	20 A		PTAC 311	4
-	Hotel Guest Suite 313	】	Α	20 A	1	}			1	350	1456					6
-	Hotel Guest Suite 313	7	A	20 A	1	₹50	1456				1 100	2	20 A		PTAC 313	8
	Hotel Guest Suite 315	\leftarrow	A	20 A	1)	1.00	350	1456	-						10
-	Hotel Guest Suite 315	<u> </u>	A	20 A	1	{				350	1456	2	20 A		PTAC 315	12
	Hotel Guest Suite 317	\	A	20 A	1	350	1456									14
-	Hotel Guest Suite 317	>	A	20 A	1	7		350	1456	1		2	20 A		PTAC 317	16
_	Hotel Guest Suite 319	>	Α	20 A	1				1	350	1456					18
	Hotel Guest Suite 319	{	Α	20 A	1	3 50	1456					2	20 A		PTAC 319	20
21	Hotel Guest Suite 308	\leftarrow	Α	20 A	1	3		350	1456	1						22
23	Hotel Guest Suite 308	7	Α	20 A	1	1				350	1456	2	20 A		PTAC 308	24
25	Hotel Guest Suite 310	7	Α	20 A	1	3 50	1456									26
27	Hotel Guest Suite 310	>	Α	20 A	1	3		350	1456	1		2	20 A		PTAC 310	28
29	Hotel Guest Suite 312	>	Α	20 A	1)				350	1456					30
31	Hotel Guest Suite 312	\langle	Α	20 A	1	350	1456					2	20 A		PTAC 312	32
33	Hotel Guest Suite 314	$\overline{\zeta}$	Α	20 A	1	3		350	1456							34
35	Hotel Guest Suite 314	\	Α	20 A	1	1				350	1456	2	20 A		PTAC 314	36
37	Hotel Guest Suite 316	>	Α	20 A	1	\$ 50	1456									38
39	Hotel Guest Suite 316	>	Α	20 A	1	7		350	1456	1		2	20 A		PTAC 316	40
41	Hotel Guest Suite 318	7	Α	20 A	1)				350	1456					42
43	Hotel Guest Suite 318	$\langle \cdot \rangle$	Α	20 A	1	3 50	1456					2	20 A		PTAC 318	44
45	Hotel Guest Suite 320	(Α	20 A	1	3		350	1456	1			00.4		DTA 0 000	46
47	Hotel Guest Suite 320	7	Α	20 A	1	1				350	1456	2	20 A		PTAC 320	48
49	Lighting	Z	m	2000	_ائر	895	500					1	20 A		NAC	50
51	Lighting			20 A	1			985	1080	1		1	20 A		Receptacle	52
53	SPARE			20 A	1					0	900	1	20 A		Receptacle	54
55	SPARE			20 A	1	0	540					1	20 A		Receptacle	56
57	SPARE			20 A	1			0	720	<u></u>		1	20 A		Receptacle - Ice Mach.	58
59	SPARE			20 A	1					0	0	1	20 A		SPARE	60
61	SPARE			20 A	1	0	0					1	20 A		SPARE	62
63	SPARE			20 A	1			0	0			1	20 A		SPARE	64
65	SPARE			20 A	1					0	0	1	20 A		SPARE	66
67	SPARE			20 A	1	0	0					1	20 A		SPARE	68
69	SPARE			20 A	1			0	0			1	20 A		SPARE	70
71	SPARE			20 A	1					0	0	1	20 A		SPARE	72
				OTAL LO		16.4			kVA		kVA					
	TOTAL ESTIM			OTAL AN		138	8 A	14 13	5 A	12	8 A					

LCP = CRKT TO BE ROUTED THROUGH LTG CONTROL PANEL

R = RED HANDLED, LOCK-OUT TYPE

A = ARC-FAULT BREAKER

S = SHUNT-TRIP BREAKER

GP = GFEPD BREAKER

G = GFCI BREAKER

	LOCATION: ELEC 4.2			VOL	TAGI	= : 120/	208 Wy	е	A.I.C.	RATING	i: 22ŀ	<		PROJECT:		
FED FROM: 3M			PHASES: 3							PANEL TYPE: MLO				HOTEL		
	MOUNTING: SURFACE		WIRES: 4						PANE	L AMPS	: 225	5 A				
Е	NCLOSURE: NEMA 1			BUS	SINC	S: SEE	SPEC'	S	МВ	R AMPS	: N/A	4				
MF	G & MODEL: SQ. D/NQ SERIES	S	I	DIMENS	SIONS	S : 20"V	V x 5.8"	D x *"H		FEED): BO	MOTT				
NOTE	:S:															
		3				_										
			~~	· ~ ~	~ ~~	<u> </u>		Г				T				
СКТ	CIRCUIT DESCRIPTION	4	NOTE	AMPS	Р	3	A	В		С	Р	AMPS	NOTE	CIRCUIT DESCRIPTION	СКТ	
1	Hotel Guest Suite 422	(Α	20 A	1	350	1456					00.4		DTA 0. 400	2	
3	Hotel Guest Suite 422	\	Α	20 A	1	1		350 1456	;		2	20 A		PTAC 422	4	
5	Hotel Guest Suite 424	7	Α	20 A	1	{			350	1456	2	20.4		DTAC 424	6	
7	Hotel Guest Suite 424	_{	Α	20 A	1	₹350	1456				2	20 A		PTAC 424	8	
9	Hotel Guest Suite 426	}	Α	20 A	1	\rfloor		350 1456	3		2	20 A		PTAC 426	10	
11	Hotel Guest Suite 426	1	Α	20 A	1)			350	1456		20 A		F 1AC 420	12	
13	Hotel Guest Suite 428	_{	Α	20 A	1	\$50	1456				2	20 A		PTAC 428	14	
15	Hotel Guest Suite 428	<u> </u>	Α	20 A	1	\$		350 1456	i			2071		1 1/10 420	16	
17	Hotel Guest Suite 430		Α	20 A	1	1			350	1456	2	20 A		PTAC 430	18	
19	Hotel Guest Suite 430	ۓ	Α	20 A	1	\$50	1456					2071		1 17.0 100	20	
21	Hotel Guest Suite 432		Α	20 A	1	}		350 1456	5		2	20 A		PTAC 432	22	
23	Hotel Guest Suite 432		Α	20 A	1	<u> </u>			350	1456		2071			24	
25	Hotel Guest Suite 421	_{	Α	20 A	1	350	1456				2	20 A		PTAC 421	26	
27	Hotel Guest Suite 421	Ç	Α	20 A	1	3		350 1456							28	
29	Hotel Guest Suite 423		Α	20 A	1	Ιζ	T		350	1456	2	20 A		PTAC 423	30	
31	Hotel Guest Suite 423	_خ_	Α	20 A	1	₹350	1456								32	
33	Hotel Guest Suite 425	<u> </u>	A	20 A	1	}		350 1456		1.150	2	20 A		PTAC 425	34	
35	Hotel Guest Suite 425		A	20 A	1	2	1.150		350	1456					36	
37	Hotel Guest Suite 427	-	A	20 A	1	350	1456	050 4450			2	20 A		PTAC 427	38	
39	Hotel Guest Suite 427	\leftarrow	A	20 A	1	∤}		350 1456		1070					40	
41	Hotel Guest Suite 429 Hotel Guest Suite 429	\leftarrow	A	20 A	1	X E0	1076		550	1976	2	30 A		PTAC 429	42	
43 45	Hotel Guest Suite 429 Hotel Guest Suite 431		A	20 A 20 A	1	\$50	1976	550 1976							44	
47	Hotel Guest Suite 431	}	A	20 A	1	∤		330 1876	550	1976	2	30 A		PTAC 431	48	
49	Hotel Guest Suite 433	}	A	20 A	1	3 550	1976		330	1370					50	
51	Hotel Guest Suite 433	}	A	20 A	1	250	1370	550 1976	<u></u>		2	30 A		PTAC 433	52	
53	SPARE	\leftarrow		20 A	1	}		1070	0	0	1	20 A		SPARE	54	
	J. 7 11 12	~		بتر کئر TAL L	DAD:	سر 17.7	7 kVA	17.7 kVA		kVA	•	207		○1 / II \L	04	
				OTAL A			60 A	150 A		2 A						
	TOTAL ESTIN	//ATE						142 A	1							
3RK	NOTES:					1										
\ = A	RC-FAULT BREAKER (GP =	GFEPE	BREA	KER			LCP = CRK	г то ве	ROUTE	D TH	IROUG	HLTG C	CONTROL PANEL		

LOCATION: ELEC 4.2 FED FROM: 3M MOUNTING: SURFACE ENCLOSURE: NEMA 1 MFG & MODEL: SQ. D/NQ SERIES NOTES:			VOLTAGE: 120/208 Wye PHASES: 3 WIRES: 4 BUSSING: SEE SPEC'S DIMENSIONS: 20"W x 5.8"D					S	A.I.C. RATING: 22k PANEL TYPE: MLO PANEL AMPS: 225 A MBR AMPS: N/A FEED: BOTTOM			.O 5 A A	<u>PROJECT:</u> HOTEL			
СКТ	CIRCUIT DESCRIPTION	3\		AMPS	P 3		A		В	(· · · · · ·	P	AMPS	NOTE	CIRCUIT DESCRIPTION	CK ⁻
1	Hotel Guest Suite 409	7	Α	20 A	1 7	350	1456				-					2
3	Hotel Guest Suite 409	\succ	Α	20 A	1 5			350	1456			2	20 A		PTAC 409	4
5	Hotel Guest Suite 407	>	Α	20 A	1 -)			1	550	1456		00.4		DTA 0 407	6
7	Hotel Guest Suite 407	1	Α	20 A	1	550	1456	1				2	20 A		PTAC 407	8
9	Hotel Guest Suite 405	(Α	20 A	1	}		350	1456				00.4		PTAC 405	
11	Hotel Guest Suite 405	\	Α	20 A	1	{				350	1456	2	20 A			
13	Hotel Guest Suite 403	7	Α	20 A	1 7	350	1456					2	20.4		PTAC 403	14
15	Hotel Guest Suite 403	7	Α	20 A	1 -	7		350	1456				20 A		F 1AC 403	16
17	Hotel Guest Suite 401	}	Α	20 A	1					550	1976	2	30 A		PTAC 401	18
19	Hotel Guest Suite 401	{	Α	20 A	1 '	550	1976						30 A		F 1AC 401	20
21	Hotel Guest Suite 402	Ç	Α	20 A	1 7	}		550	1976			2	30 A		PTAC 402	22
23	Hotel Guest Suite 402	۲	Α	20 A	1 7					550	1976		30 A		F 1AC 402	24
25	Hotel Guest Suite 404	ځ	Α	20 A	1 -	350	1456					2	20 A		PTAC 404	26
27	Hotel Guest Suite 404	<u>\</u>	Α	20 A	1 -	?		350	1456				2071		1 1710 404	28
29	Hotel Guest Suite 406	1	Α	20 A	1					350	1456	2	20 A		PTAC 406	30
31	Hotel Guest Suite 406	<u> </u>	Α	20 A	1 7	350	1456					_	2071			32
33	Roof EF	7	m	20\D^	ىرل			1392	0			1	20 A		SPARE	34
35	Roof EF			20 A	1					1392	0	1	20 A		SPARE	36
37	Roof EF			20 A	1	1392	0					1	20 A		SPARE	38
	Receptacle - Rooftop			20 A	1			720	0			1	20 A		SPARE	40
41	HVAC RM 205			15 A	2					749	0	1	20 A		SPARE	42
43						749	0					1	20 A		SPARE	44
45	HVAC RM 207			15 A	2			749	0			1	20 A		SPARE	46
47						0000	40.1-			749	0	1	20 A	-	SPARE	48
49	LIVA O DT. 4			FO. 4	•	3939	1345	0000	40.45				00.4		11)/40 DIL 4D	50
51	HVAC RT-1			50 A	3			3939	1345	2022	40.45	3	20 A		HVAC DH-1B	52
53				TAL L) A D:	40.0	1.7.7.4	47.0	1.1.7.4	3939						54
				TAL LO		19.2	KVA 1 A		kVA 9 A	18.8	KVA B A					
	TOTAL ESTIN	ΔTF				10	ı A		9 A 6 A	100) A					
3RK I	NOTES:	.~.1 L	ULI41	, use Al	5.			13	√ /\							



PAYNE ENGINEERING

Laughlin Ricks Architecture

= architecture/planning

134 3RD AVE. E. * Twin Falls, Idaho 83301

(208) 736-8050 Fax: (208) 733-0950

SCHEDULES

HOTEL
TWIN FALLS, ID
ELECTRICAL S

JA NEW HOTEL:

 DATE:
 5/6/2022

 BP
 SAM

 Drawn
 Checked

E5.2

			LIGI	HTING	G FIXTUR	E SCHEE	DULE		
TYPE	DESCRIPTION	MOUNTING	VOLTS	WATTS	LUMENS	COLOR TEMP.(K)	MFGR.	CATALOG#	NOTE
EXTERIO	₹	•					•		
FE1	AREA POLE LIGHT, SINGLE-HEAD, TYPE 3 DIST.	POLE (SEE DETAIL)	MULTI-TAP	120 W	17,000	4000	LITHONIA	RSX2 LED - P2	
FE2	6" ROUND RECESSED LED CAN, 0-10V DIMMING	RECESSED	120-277	40 W	2000	4000	LITHONIA	LDN6-40/20-LO6AR-LSS-MVOLT-EZ10	
FE3	EXTERIOR LED WALL PACK	WALL	120-277	30 W	4000	4000	LITHONIA	ARC2 LED-P4-40K-MVOLT-FAO-SCBO	3
FE3E	EXTERIOR LED WALL PACK, EMERG. BATTERY PACK	WALL	120-277	30 W	4000	4000	LITHONIA	ARC2 LED-P4-40K-MVOLT-E8WC-FAO-SCBO	3
FE4	EXTERIOR LED WALL CYLINDER 30 DEG. UP/DOWN DIST. IP66 RATED	WALL	120	50 W	5087	4000	LUMINIS LTG	SY602-L2L25-R30-120-SCBA	3
FE5	EXTERIOR LED WALL CYLINDER,30 DEG. UP ONLY DIST. IP66 RATED	WALL	120	30 W	2543	4000	LUMINIS LTG	SY600-L1L25-R30-120-SCBA	3
NTERIOR									
F1	4FT LED STRIP, 0-10V DIMMING	SURFACE	120-277	30 W	4000	4000	LITHONIA	CLX-L48-4000LM-SEF-RDL-MVOLT-GZ10-40K-80CRI	
F1E	4FT LED STRIP, 0-10V DIMMING	SURFACE	120-277	30 W	4000	4000	LITHONIA	CLX-L48-4000LM-SEF-RDL-MVOLT-GZ10-40K-80CRI-PS1050	
F2	4FT LED WRAPAROUND	SURFACE	120	40 W	4000	4000	LITHONIA	BLWP4-40L-ADSM-EZ1-LP840	1
F3	2X2 LAY-IN LED, 0-10V DIMMING	RECESSED	120-277	40 W	HIGH	4000	LITHONIA	CPX 2X2-AL07-SWW7-M4	1
F3E	2X2 LAY-IN LED,0-10V DIMMING, EMERG. BATTERY PACK	RECESSED	120-277	40 W	HIGH	4000	LITHONIA	CPX 2X2-AL07-SWW7-IE10WCP	1
F4	4FT LED VAPOR-TIGHT WET LOCATION STRIP	SURFACE	120-277	40 W	4000	4000	LITHONIA	CSVT-L48-AL03-MVOLT-SWW3-80CRI	
F4E	4FT LED VAPOR-TIGHT WET LOCATION STRIP, EMERG. BATTERY PACK	SURFACE	120-277	40 W	4000	4000	LITHONIA	CSVT-L48-AL03-MVOLT-SWW3-80CRI-IE7WCP	
F5	4" ROUND RECESSED LED CAN, 0-10V DIMMING, FIELD SELECTABLE LUMENS/CCT	RECESSED	120-277	25 W	1500	PER OWNER	LITHONIA	LDN4-ALO2-SWW1-LO4AR-LSS-MVOLT-UGZ	1
F5E	4" ROUND RECESSED LED CAN, 0-10V DIMMING, FIELD SELECTABLE LUMENS/CCT, EMERG. BATTERY PACK	RECESSED	120-277	25 W	1500	PER OWNER	LITHONIA	LDN4-ALO2-SWW1-LO4AR-LSS-MVOLT-UGZ-ELR	1
F6E	8FT LED WRAPAROUND, 0-10V DIMMING, W/ EMERG. BATTERY PACK	SURFACE	120-277	85 W	10,000	4000	LITHONIA	BLWP8-100L-ADSM-EZ1-LP840-EL14L	
F7	ROUND PENDANT LED, AIRCRAFT CABLE SUSPTENSION, IP66 RATED	PENDANT	120-277	110 W	13,000	4000	LITHONIA	VCVL LED-V4-P6-40K-80CRI-T5W-MVOLT-AC6-SCBA	3
F8	FLEXIBLE LINEAR LED LIGHT	RECPT. ∕6O\HT\£R `\	24VDC	1 W	55LM/FT	4000	QTRAN LED	FLQ-SW-S-40-VB-90-1.4-IM-**-**-IM-**-**-PER DWGS;	7
F9	2FT LED VAPOR-TIGHT WET LOCATION STRIP	SURFACE	120-277	20 W	3000	4000	LITHONIA	FEM-L24-3000LM-LPPCL-MD-MVOLT-GZ10-40K-80CRI	
	EXIT SIGN W/ 90MIN BATTERY,BRUSHED ALUMINUM, GREEN LED	WALL/CEILING	\sim	2 W	N/A	N/A	ISOLITE LTG	LPDC-EM-G-(PER DWGS)-BA-WH-MTEB-SD	mu
FX1M	EXIT SIGN W/ 90MIN BATTERY,BRUSHED ALUMINUM, GREEN LED (MASTER)	WALL/CEILING	120-277	2 W	N/A	N/A	ISOLITE LTG	LPDCMR-EM-G-(PER DWGS)-BA-WH-MTEB-SD	
FX1R	RECESSED REMOTE POWERED EXIT SIGN, VANDAL RESISTANT,BRUSHED ALUMINUM, GREEN LED, SINGLE FACE (REMOTE)	RECESSED 12" AFF	120-277	2 W	N/A	N/A	ISOLITE LTG	LPDCREM-G-1-BA-WH-MRW-VR	
FX2	WET LOCATION EXIT SIGN/EM LIGHT COMBO W/ 90MIN BATTERY,THERMOPLASTIC, GREEN LED	WALL OR CEILING	120-277	2 W	N/A	N/A	LITHONIA	WLTC-1-G-SD	
FX3	WALL MOUNTED EXTERIOR EMERGENCY EGRESS LIGHT, W/HEATER	WALL ABOVE DOOR	120-277	35 W	N/A	N/A	LITHONIA	AFF-OEL-SCBA-UVOLT-LTP-SDRT-WT-CW	3
FX4	550W INVERTER, 90 MIN. BATTERY	WALL/FLOOR	120	550 W	N/A	N/A	IOTA	IIS 550 I	
OWNER F	URNISHED								
OF1	ROUND SURFACE LIGHT	SURFACE	120	20 W	PER OWNER	PER OWNER	PER OWNER	OWNER FURNISHED / CONTRACTOR INSTALLED	
	ROUND SURFACE LIGHT	SURFACE	120	40 W	PER OWNER	PER OWNER	PER OWNER	OWNER FURNISHED / CONTRACTOR INSTALLED	
OF3	WALL MOUNTED READING LIGHT W/ INTEGRAL SWITCH	WALL	120	10 W	PER OWNER	PER OWNER	PER OWNER	OWNER FURNISHED / CONTRACTOR INSTALLED	
OF4	ILLUMINATED MIRROR	WALL	120	20 W	PER OWNER	PER OWNER	PER OWNER	OWNER FURNISHED / CONTRACTOR INSTALLED	
OF5	LED MONOPOINT PENDANT FIXTURE	PENDANT	120	20 W	PER OWNER	PER OWNER	PER OWNER	OWNER FURNISHED / CONTRACTOR INSTALLED	
OF6	ARCHITECTURAL SCONCE LIGHT	WALL	120-277	20 W	PER OWNER	PER OWNER	PER OWNER	OWNER FURNISHED / CONTRACTOR INSTALLED	
OF7	ROUND SURFACE SHOWER LIGHT, WET LOCATION RATED	SURFACE	120	20 W	PER OWNER	PER OWNER	PER OWNER	OWNER FURNISHED / CONTRACTOR INSTALLED	

LIGHT FIXTURE SCHEDULE NOTES

- REFER TO DRAWINGS FOR FIXTURES REQUIRED TO HAVE 0-10V OR STEP-LEVEL DIMMING CONTROL. PROVIDE FIXTURE(S) WITH LED DRIVER(S) AND REQUIRED DIMMING/SWITCH-LEG CONDUCTORS
- BETWEEN SWITCH(ES) AND FIXTURE(S) TO PROVIDE CONTROL AS INDICATED ON DRAWINGS.
- FIXTURE TO BE CONTINUOUS ROW MOUNTED, LENGTH AS INDICATED ON DRAWINGS. PROVIDE REQUIRED ACCESSORIES/CONNECTORS FOR CONTINUOUS ROW MOUNTING. SCBA - STANDARD COLOR BY ARCHITECT/OWNER (COORDINATE COLOR WITH ARCHITECT/OWNER PRIOR TO ORDERING.)
- FIELD ADJUST PENDANT LENGTH AS REQUIRED, VERIFY LENGTH WITH COUNTER AS DIRECTED BY ARCHITECT
- . REFER TO ARCHITECTURAL ELEVATION DRAWINGS FOR PLACEMENT AND MOUNTING HEIGHT OF FIXTURES.
- 6. PROVIDE AND INSTALL 120V FACTORY APPROVED DIMMER SWITCH FOR TRACK: ACUITY P/N: SYNERGY ISD 400 ELV 120.
- PROVIDE ALL COMPONENTS FOR COMPLETE INSTALLATION OF FIXTURE, INCLUDING BUT NOT LIMITED TO: END FEEDS, CONNECTORS, POWER SUPPLY AND ETC. PROVIDE CONNECTOR ORIENTATION AS NEEDED FOR INSTALLATION.

GENERAL LIGHTING SCHEDULE NOTES:

- LIGHTING FIXTURES INDICATED IN SCHEDULE ARE BASIS OF DESIGN, ALTERNATE MANUFACTURERS SHALL BE PRE-APPROVED BY ADDENDUM. ALTERNATE
- MANUCATURERS SHALL SUBMIT PER-APPROVALS TO ENGINEER A MINIMUM OF 10 DAYS PRIOR TO PROJECT BID DATE.

TYPE	DESCRIPTION	MFGR.	CATALOG #	NOTES	APPROVED EQUALS
	R SWITCHES - LINE VOLTAGE	5	o, <u></u> _ ,,		
D1	LINE VOLTAGE 0-10V DIMMER, ON/OFF/DIMMING PUSH-BUTTONS	SENSOR SWITCH	sPODMRA-D-**	2,3,4	
IGHTIN	IG CONTROL PANELS		<u>'</u>		
LCP	SURFACE MOUNTED, 16-RELAY DIGITAL RELAY PANEL, W/ASTRONOMICAL TIMECLOCK	ACUITY BRANDS	ARP INTENC16 NLT/16SPR/MVOLT/SC /SM/DTC	6	COOPER, WATTSTOPPER, LEVITON
OCC. SE	ENSORS - CEILING (LINE VOLTAGE)				
CD2	DUAL-TECHNOLOGY, LINE VOLTAGE, SMALL MOTION 800W MAX LOAD	SENSOR SWITCH	CMR PDT 9		COOPER, WATTSOPPER, HUBBELL
CC. SE	ENSORS - CEILING (LOW VOLTAGE)				
CD1	DUAL-TECHNOLOGY, SMALL MOTION 360 DEGREE COVERAGE, LOW VOLTAGE, W/ISOLATED RELAY	SENSOR SWITCH	CM PDT 9 R	1	COOPER, WATTSTOPPER, HUBBELL
CD5	DUAL-TECH HALLWAY SENSOR, LOW VOLTAGE, W/ISOLATED RELAY	SENSOR SWITCH	CM PDT 11 R	1	COOPER, WATTSTOPPER, HUBBELL
CC. SE	ENSORS - WALL MOUNTED				
WDD	DUAL-TECHNOLOGY, 0-10V DIMMING	SENSOR SWITCH	WSX-PDT-D	2,5	COOPER, WATTSTOPPER, HUBBELL
WP1	PASSIVE-INFRARED, 1-POLE, NEUTRAL REQUIRED	SENSOR SWITCH	WSX-**	2	COOPER, WATTSTOPPER, HUBBELL
WITCH	PODS - LOW VOLTAGE				
SP3	LOW VOLTAGE PUSH-BUTTON SWITCHPOD, 3-WAY CONTROL	SENSOR SWITCH	sPODM-3X-**	2,3,4	COOPER
SP3D	LOW VOLTAGE PUSH-BUTTON SWITCHPOD, 3-WAY CONTROL W/ 0-10V DIMMING	SENSOR SWITCH	sPODM-3X-D**	2,3,4	COOPER

PROVIDE ADDITIONAL POWER PACKS; SENSOR SWITCH PP20 AS NEED FOR QTY OF OCCUPANCY SENSORS/SWITCHES.

- DEVICE COLOR SHALL MATCH WIRING DEVICES; REFER TO SPECIFICATIONS.
- REFER TO MANUFACTURER DOCUMENTATION FOR QTY AND SIZE OF CONDUCTORS BETWEEN LOW VOLTAGE SWITCH, SENSOR(S) AND POWER/RELAY PACKS.
- PROVIDE SECONDARY RELAY PACK; SENSOR SWITCH SP20 AS NEEDED TO PROVIDE DUAL-LEVEL SWITCHING OF FIXTURES. . PROVIDE 0-10V DIMMING CONDUCTORS (GRAY & VIOLET) BETWEEN SWITCH AND LIGHT FIXTURES FOR DIMMING CONTROL.
- 6. PROGRAM ON/OFF TIMES OF RELAY'S AS DIRECTED BY OWNER. PROVIDE COMMISSIONING AS INDICATED IN GENERAL NOTES BELOW.
- . CUSTOM WALL STATION ENGRAVINGS IS REQUIRED FOR WALL STATION(S) AND SHALL BE SPECIFIED/COORDINATED WITH OWNER AFTER PROGRAMING OF SYSTEM.

GENERAL LIGHTING CONTROL NOTES:

- E.C. SHALL BE RESPONSIBLE FOR THE PROGRAMMING/COMMISSIONING OF THE LIGHTING CONTROL SYSTEMS TO FUNCTION AS INDICATED ON THE DRAWINGS AND SHALL INCLUDE ALL REQUIRED COST IN THE BASE BID. FOR AREAS WITH DAYLIGHTING CONTROL, THE DAYLIGHTING SET-POINTS SHALL BE COORDINATED WITH THE OWNER FOR EACH AREA PRIOR TO FINAL PROGRAMMING OF THE DAYLIGHTING SENSOR(S). ALL PROGRAMMING/COMMISSIONING SHALL BE DONE BY A FACTORY CERTIFIED OR TRAINED
- LIGHTING IS SPACES WITH WIRELESS CONTROLS SHALL BE FIELD TUNED TO FOOTCANDLE LEVELS THAT ARE SATISFACTORY TO THE OWNER DURING PROGRAMMING AND COMMISSIONING OF THE WIRELESS CONTROL SYSTEM.

ELEVATOR GENERAL NOTES:


- A. CONTRACTOR SHALL OBTAIN EXACT FUSE/CIRCUIT SIZE REQUIRED BY THE ELEVATOR EQUIPMENT SUPPLIER PRIOR TO ANY ROUGH-IN.
- B. PRIOR TO ROUGH-IN OR MOUNTING OF EQUIPMENT IN THE ELEVATOR EQUIPMENT ROOM, COORDINATE WITH THE ELEVATOR EQUIPMENT SUPPLIER FOR PLACEMENT OF ALL PANELS, ETC. TO INSURE PROPER WORKING CLEARANCES.
- C. ONLY EQUIPMENT ASSOCIATED TO THE ELEVATOR SHALL BE ALLOWED TO BE INSTALLED IN THE ELEV. EQUIP. ROOM WITH THE EXCEPTION OF ANY SPECIAL CODE REQUIRED SYSTEMS SUCH AS FIRE ALARM.
- D. ALL ELECTRICAL REQUIREMENTS FOR THE ELEVATOR SHALL COMPLY WITH NEC SECTION 620.


ELEVATOR NOTES:

- 1. BUSSMAN ELEVATOR POWER MODULE (SEE SCHEDULE). MOUNT ADJACENT TO ELEVATOR CONTROLLER EQUIPMENT.
- 2. 30A/2P FUSED, GENERAL-DUTY SAFETY SWITCH WITH LOCKOUT CAPABILITY. DISCONNECT IS FOR ELEVATOR CAR LIGHTS, CONTROLS, OUTLETS, VENT POWER AND
- 3. TELEPHONE OUTLET OR JUNCTION POINT IN EQUIPMENT RM, VERIFY LOCATION. 4. 3/4" CONDUIT TO MAIN TELEPHONE BOARD/CABINET IN BUILDING; SEE PLANS FOR

ETC. FOR ELEVATOR CAR. SEE NEC 620 FOR INFORMATION.


- LOCATION. PROVIDE PULL CORD OR CABLE AS SPECIFIED ON DRAWINGS. 5. 3/4" CONDUIT CONNECTION TO ELEVATOR CAR EMERGENCY PHONE. VERIFY
- CONNECTION POINT WITH EQUIPMENT.
- DEDICATED 120V CIRCUIT FOR ELEVATOR CAR LIGHTS. UTILIZE EMERG. POWER CIRCUIT WHEN AN EMERG. GENERATOR IS INSTALLED. SEE POWER PLAN FOR CIRCUIT NUMBER.
- 7. CONNECTION TO ELEVATOR CAR LIGHTS, VERIFY EXACT CONNECTION POINT WITH ELEVATOR EQUIPMENT.
- 8. PROVIDE A GFCI RECEPTACLE, LIGHT FIXTURES AND SWITCH IN ELEVATOR PIT. VERIFY EXACT PLACEMENT WITH ELEVATOR INSTALLER. LOCATE SWITCH AT PIT ACCESS SUCH THAT LIGHTS MAY BE SWITCHED WITHOUT ENTERING PIT. LIGHT FIXTURES SHALL BE LITHONIA# DMW2-L24-3000LM-PFL-WD-MVOLT-40K-80CRI. PROVIDE (4) FIXTURES ON
- OPPOSITE WALLS OF PIT. MINIMUM FC IN PIT TO BE NOT LESS THAN 10FC. 9. PROVIDE FIRE ALARM SYSTEM CONNECTION/MONITORING OF THE SHUNT TRIP VOLTAGE, ELEVATOR RECALL, FIREMANS HAT, AND ETC PER NFPA 72.
- 10. PROVIDE AND INSTALL (2) SURFACE/PENDANT LIGHT FIXTURES IN EQUIPMENT ROOM; LITHONIA# CLX-L48-5000LM-SEF-FDL-MVOLT-GZ10-40K-80CRI-WH-ZACVH OR EQUAL. CONNECT FIXTURE(S) TO EQUIPMENT ROOM CIRCUIT.

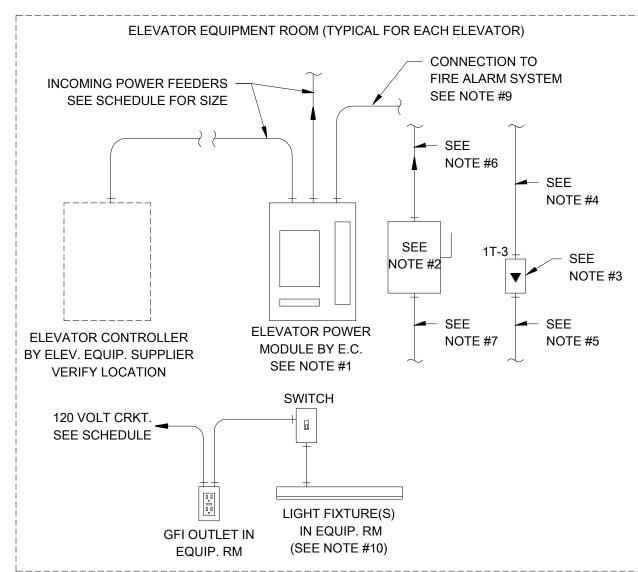

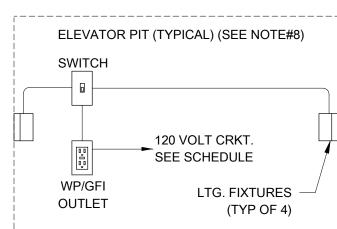


	ELEVATOR SCHEDULE									
ELEV. ID.	VOLTS/ PHASE	HP	FLA	BUSSMAN POWER MODULE #	PIT CIRCUIT	EQUIP. ROOM LTG/RECPT. CIRCUIT	CAR LIGHT CIRCUIT	ELEVATOR CIRCUIT	DUAL ELEMENT FUSE SIZE	ELEVATOR FEEDER SIZE
Α	208/3	40	125	PS-4-T20-R1-K-G-N4-B-F3	1B-2	1B-4	1B-6	MSB-6	175 AMP	2"C.,3#3/0 + 1#6G
В	208/3	40	125	PS-4-T20-R1-K-G-N4-B-F3	1B-2	1B-4	1B-8	MSB-7	175 AMP	2"C.,3#3/0 + 1#6G



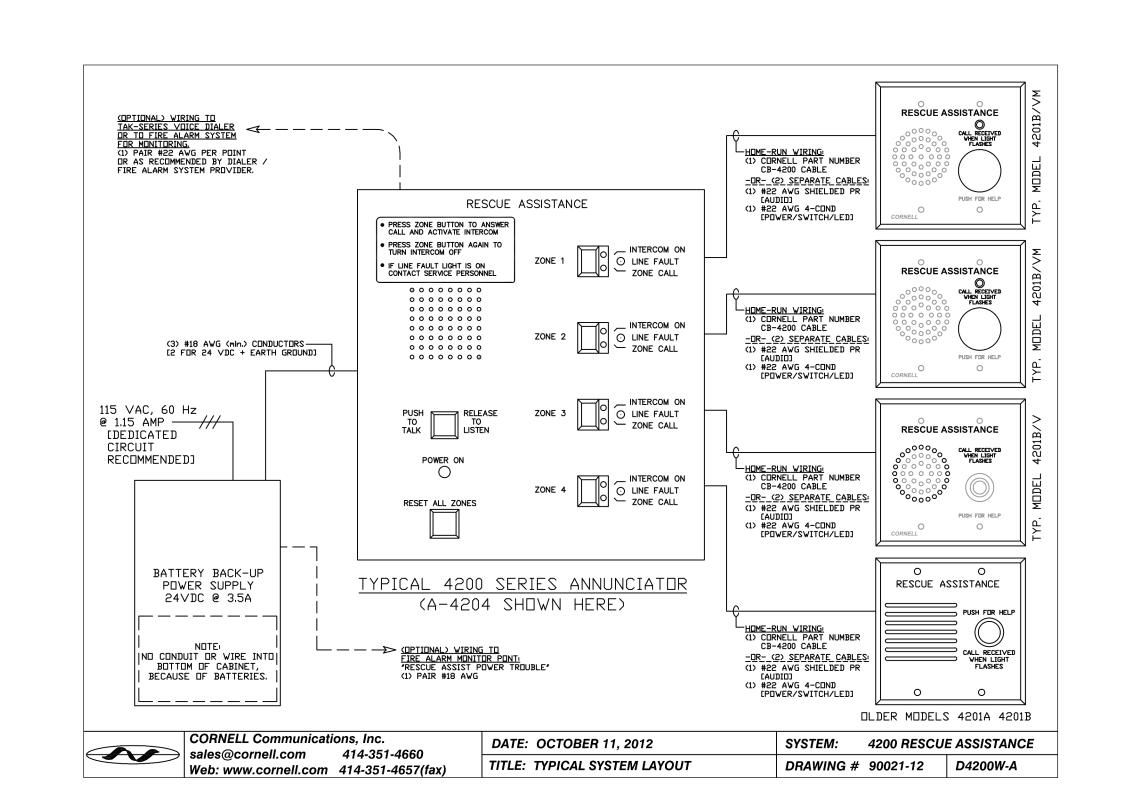

B TWO-WAY EMERGENCY COMMUNICATION TYP. SYSTEM LAYOUT SCALE: NONE

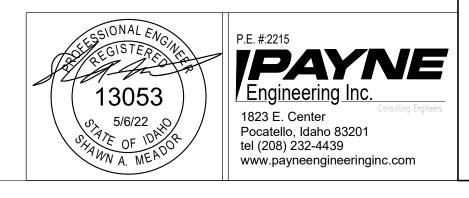

DATE: 5/6/2022 SAM Checked

HOTEI TWIN FAL

A NEV

Architectur

Ricks

aughlin

planning /

STRUCTURAL NOTES

TO. DIMENSIONS, SIZES, ETC).

A. GENERAL

- 1. THE STRUCTURAL NOTES ARE INTENDED TO COMPLEMENT THE PROJECT SPECIFICATIONS WHICH ARE PART OF THE CONSTRUCTION DOCUMENTS. SPECIFIC NOTES AND DETAILS ON THE DRAWINGS SHALL GOVERN OVER THE STRUCTURAL NOTES AND TYPICAL DETAILS.
- 2. THESE DRAWINGS (AND, WHERE APPLICABLE, ACCOMPANYING WRITTEN SPECIFICATIONS) ARE THE ONLY CONTRACT DOCUMENTS PROVIDED BY ARW ENGINEERS FOR THE PROJECT REPRESENTED HEREIN. NOTHING IN ANY DIGITAL MODEL OR DIGITAL FILE RELATED TO THIS PROJECT SHALL BE TAKEN TO SUPERSEDE ANY INFORMATION SHOWN IN THESE DRAWINGS (INCLUDING, BUT NOT LIMITED
- 3. THE ARCHITECTURAL DRAWINGS ARE THE PRIME CONTRACT DRAWINGS. THE STRUCTURAL DRAWINGS ARE SUPPLEMENTARY TO AND MUST BE USED IN CONJUNCTION WITH THE ARCHITECTURAL DRAWINGS AND OTHER CONSULTANTS DRAWINGS. ALL OMISSIONS OR CONFLICTS BETWEEN THE VARIOUS ELEMENTS OF THE WORKING DRAWINGS AND/OR SPECIFICATIONS SHALL BE BROUGHT TO THE ATTENTION OF THE ARCHITECT AND STRUCTURAL ENGINEER BEFORE PROCEEDING WITH ANY WORK INVOLVED. IN CASE OF CONFLICT, FOLLOW THE MOST STRINGENT REQUIREMENT AS DIRECTED BY THE ARCHITECT AT NO ADDITIONAL COST TO THE OWNER.
- 4. SEE SPECIFICATIONS FOR REQUIRED SUBMITTALS, SUBMITTALS SHALL BE MADE IN A TIMELY MANNER AS INDICATED IN SPECIFICATIONS. REVIEW OF SUBMITTALS BY ARW ENGINEERS IS FOR GENERAL COMPLIANCE ONLY AND IS NOT INTENDED AS APPROVAL. CONTRACTOR IS RESPONSIBLE FOR VERIFYING ALL SIZES, DIMENSIONS, AND ELEVATIONS ON SUBMITTALS AS RELATED TO DESIGN DOCUMENTS. PREPARATION OF SHOP DRAWINGS FOR STRUCTURAL ELEMENTS WILL REQUIRE INFORMATION (I.E. DIMENSIONS, ETC.) FOUND IN THE ARCHITECTURAL, STRUCTURAL, AND OTHER
- 5. THE CONTRACTOR SHALL VERIFY ALL CONDITIONS AND DIMENSIONS AT THE SITE. IF ACTUAL CONDITIONS DIFFER FROM THOSE SHOWN ON CONTRACT DOCUMENTS, CONTRACTOR SHALL NOTIFY ARCHITECT PRIOR TO FABRICATION OR CONSTRUCTION OF ANY AFFECTED ELEMENTS.
- 6. THE CONTRACTOR SHALL COORDINATE AND VERIFY ALL LOCATIONS AND SIZES OF MECHANICAL EQUIPMENT OR OTHER EQUIPMENT BEFORE FABRICATING AND ERECTING STRUCTURAL ELEMENTS. SIZES AND LOCATIONS THAT DIFFER FROM THOSE SHOWN ON THE CONTRACT DOCUMENTS SHALL BE REPORTED TO THE ARCHITECT.
- 7. THE CONTRACTOR SHALL SUBMIT A WRITTEN REQUEST TO THE ARCHITECT FOR ARCHITECT AND/OR ENGINEER APPROVAL BEFORE PROCEEDING WITH ANY CHANGES, MODIFICATIONS, OR
- 8. OBSERVATION VISITS TO THE SITE BY ARW ENGINEERS FIELD REPRESENTATIVES SHALL NEITHER BE CONSTRUED AS INSPECTION NOR APPROVAL OF CONSTRUCTION.
- 9. DURING AND AFTER CONSTRUCTION, BUILDER AND/OR OWNER SHALL KEEP LOADS ON STRUCTURE WITHIN THE LIMITS OF DESIGN LOADS AS NOTED IN THESE DOCUMENTS. 10. TYPICAL OR SIMILAR DETAILS AND SECTIONS SHALL APPLY WHERE SPECIFIC DETAILS ARE NOT
- SHOWN, TYPICAL OR SIMILAR DETAILS REFER TO THE CONDITION ADDRESSED AND ARE NOT NECESSARILY DETAILS LABELED "TYPICAL" OR "SIMILAR" IN THE PLANS AND DOCUMENTS.
- 11. DRAWINGS AND DETAILS HAVE BEEN PREPARED WITH THE INTENT TO VISUALLY REPRESENT INFORMATION PROVIDED IN SCALED FORM; HOWEVER CONTRACTOR/SUPPLIERS SHOULD NOT SCALE PLANS OR DETAILS FOR DIMENSIONAL INFORMATION.
- 12. THE CONTRACTOR SHALL PROVIDE ADEQUATE TEMPORARY SHORING AND BRACING FOR ALL STRUCTURAL ELEMENTS UNTIL THE ENTIRE STRUCTURAL SYSTEM IS COMPLETED. DESIGN OF ALL SHORING AND BRACING IS BY OTHERS AT NO ADDITIONAL COST TO THE OWNER.
- 13. ENGINEER SHALL NOT BE RESPONSIBLE FOR ACTIVITIES UNDER CONTROL OF THE CONTRACTOR SUCH AS CONSTRUCTION SITE SAFETY, MEANS, METHODS AND SEQUENCING OF CONSTRUCTION. ENGINEER SHALL NOT BE RESPONSIBLE FOR FABRICATION, ERECTION AND CONSTRUCTION REQUIREMENTS AS PRESCRIBED BY OSHA OR OTHER REGULATORY AGENCIES REGARDLESS OF INDICATIONS IN THESE DOCUMENTS
- 14. NOTICE OF COPYRIGHT: THESE STRUCTURAL DRAWINGS ARE HEREBY COPYRIGHTED BY ARW ENGINEERS, ALL RIGHTS RESERVED. THESE DOCUMENTS DEFINE A STRUCTURE AND ARE INSTRUMENTS OF SERVICE, FOR ONE USE ONLY. REPRODUCTION AND DISTRIBUTION OF THESE DRAWINGS IS ONLY ALLOWED AS REQUIRED FOR REGULATORY AGENCIES AND FOR CONVEYANCE OF INFORMATION TO PARTIES INVOLVED IN THE CONSTRUCTION OF THIS PROJECT. THESE DOCUMENTS SHALL NOT BE REPRODUCED OR COPIED, IN PART OR WHOLE BY ANY PARTY FOR USE IN PREPARATION OF SHOP DRAWINGS OR OTHER SUBMITTALS.
- 15. WHERE THE WORD "SHALL" OCCURS IN THESE DRAWINGS AND ANY ACCOMPANYING SPECIFICATIONS, IT IS CONSIDERED A MANDATORY OBLIGATION AND SYNONYMOUS WITH THE PHRASE "HAS DUTY TO".

B. STATEMENT OF SPECIAL INSPECTIONS AND SPECIAL INSPECTIONS

- 1. THE DESIGNATED SEISMIC/WIND SYSTEMS AND SEISMIC/WIND-FORCE-RESISTING SYSTEMS THAT ARE SUBJECT TO SPECIAL INSPECTIONS IN ACCORDANCE WITH IBC SECTION 1705.11 AND 1705.12 ARE IDENTIFIED ON THESE DOCUMENTS WITH A CIRCLE "L". ALL OTHER ITEMS REQUIRING SPECIAL INSPECTION ARE IDENTIFIED IN THE SPECIAL INSPECTION SCHEDULE ON SHEET S006 & S008.
- 2. SPECIAL INSPECTIONS AND TESTING ARE TO BE PROVIDED AS REQUIRED BY IBC SECTIONS 1704 THROUGH 1705 AND OTHER APPLICABLE SECTIONS OF THE IBC. THE TYPE AND FREQUENCY OF TESTING AND SPECIAL INSPECTIONS SHALL BE AS NOTED IN THE SPECIAL INSPECTION SCHEDULE, JOB SPECIFICATIONS, AND ACCORDANCE WITH IBC SECTION 110 AND CHAPTER 17. CONTRACTOR SHALL COORDINATE AND COOPERATE WITH REQUIRED INSPECTIONS.
- ALL TESTING AND SPECIAL INSPECTION SHALL BE PROVIDED BY A QUALIFIED INDEPENDENT SPECIAL INSPECTION AGENCY IN ACCORDANCE WITH IBC 1704 AND AS OUTLINED IN THE JOB SPECIFICATIONS. REPORTS OF FINDINGS OR DISCREPANCIES SHALL BE NOTED AND FORWARDED TO THE CONTRACTOR. ARCHITECT, ENGINEERS, AND BUILDING OFFICIAL IN A TIMELY MANNER.
- STRUCTURAL OBSERVATION VISITS SHALL BE PERFORMED BY A REPRESENTATIVE FROM ARW ENGINEERS IN ACCORDANCE WITH THE CONTRACT AS NEEDED TO OBSERVE THE CONSTRUCTION OF CRITICAL BUILDING ELEMENTS (I.E. FOOTINGS, BRACED FRAMES, MOMENT FRAMES, DRAG STRUTS AND THEIR CONNECTIONS, COLLECTORS, AND ROOF AND FLOOR DIAPHRAGMS). STRUCTURAL OBSERVATION REPORTS FOR EACH VISIT SHALL BE SENT DIRECTLY TO THE ARCHITECT FOR DISTRIBUTION TO THE CONTRACTOR AND BUILDING OFFICIAL. STRUCTURAL OBSERVATION VISITS SHALL NEITHER BE CONSTRUED AS SPECIAL INSPECTION NOR APPROVAL OF COMPLETED
- 5. IN ACCORDANCE WITH IBC 1704.4, THE CONTRACTOR SHALL SUBMIT A WRITTEN CONTRACTOR'S STATEMENT OF RESPONSIBILITY TO THE BUILDING OFFICIAL AND OWNER. THE STATEMENT SHALL BE SUBMITTED PRIOR TO THE CONSTRUCTION OF ANY SEISMIC/WIND-FORCE-RESISTING SYSTEM. DESIGNATED SEISMIC/WIND SYSTEM, OR COMPONENT IDENTIFIED IN THESE DOCUMENTS WITH A

C. BASIS OF DESIGN

- 1. GOVERNING BUILDING CODE: INTERNATIONAL BUILDING CODE (IBC) 2018
- RISK CATEGORY: II 2. SUSPENDED FLOOR LOADS
- a. LIVE LOAD = 40 PSF UNREDUCED b. DEAD LOAD = 25 PSF
- 3. ROOF LOADS
- a. FLAT-ROOF SNOW LOAD, Pf: 25 PSF
- GROUND SNOW LOAD, Pg: 15 PSF SNOW EXPOSURE FACTOR, Ce: 1.0
- 3. SNOW LOAD IMPORTANCE FACTOR, I_s: 1.0
- 4. THERMAL FACTOR, C_t: 1.0 5. SLOPE FACTOR, C_S: 1.0
- 6. SNOW DRIFT: SHOWN ON PLANS WHERE APPLICABLE. b. LIVE LOAD = 20 PSF
- c. DEAD LOAD = 15 PSF d. RAIN INTENSITY, i: 1.2 IN/HR
- WIND DESIGN a. BASIC WIND SPEED (3 SECOND GUST): 115 MPH
- b. ALLOWABLE STRESS DESIGN WIND SPEED, VASD: 89 MPH
- c. WIND EXPOSURE: C d. INTERNAL PRESSURE COEFFICIENT, G_{CPI}: ± 0.18
- e. COMPONENT AND CLADDING DESIGN WIND PRESSURE SHALL BE AS REQUIRED PER ASCE 7-16.
- SEISMIC DESIGN a. SEISMIC IMPORTANCE FACTOR, I_E: 1.0
- b. SITE CLASS: D c. MAPPED SPECTRAL RESPONSE ACCELERATIONS: $S_S = 0.184$, $S_1 = 0.081$
- d. SPECTRAL RESPONSE COEFFICIENTS: S_{DS} = 0.196, S_{D1} = 0.130 e. SEISMIC DESIGN CATEGORY: B
- BASIC SEISMIC-FORCE-RESISTING SYSTEM: ORDINARY STEEL CONCENTRIC BRACED FRAMES AND LIGHT FRAMED WOOD SHEAR WALLS
- g. DESIGN BASE SHEAR: $V_{N-S} = 0.060*W$, $V_{E-W} = 0.060*W$ h. SEISMIC RESPONSE COEFFICIENT, Cs: 0.060
- RESPONSE MODIFICATION FACTOR, R: 3.25
- ANALYSIS PROCEDURE : EQUIVALENT LATERAL FORCE PROCEDURE
- . ANTICIPATED SHRINKAGE AT EACH LEVEL IS LESS THAN 0.25". TOTAL CUMULATIVE SHRINKAGE AT TOP LEVEL IS ANTICIPATED TO BE LESS THAN 1.0".

D. FOUNDATION

- a. DESIGN SOIL PRESSURE: 2500 PSF
- b. SOILS REPORT BY: ATLAS TECHNICAL CONSULTANTS,LLC
- REPORT #: T220249q DATED: FEBRUARY 21, 2022
- c. SOIL PREPARATION UNDER FOUNDATIONS AND SLABS-ON-GRADE SHALL BE IN ACCORDANCE WITH
- d. TOP OF FOOTING ELEVATIONS SHOWN ON THE FOOTING AND FOUNDATION PLAN ARE BASED ON PRELIMINARY GRADING INFORMATION AND SHALL BE VERIFIED PRIOR TO CONSTRUCTION. STEPS WHERE SHOWN ARE AT APPROXIMATE LOCATIONS. ACTUAL STEP LOCATIONS SHALL BE AT THE CONTRACTOR'S DISCRETION BASED UPON FIELD CONDITIONS. ALL EXTERIOR FOUNDATIONS SHALL
- BEAR A MINIMUM OF 24 INCHES BELOW LOWEST ADJACENT FINAL GRADE. e. ALL WALLS (EXCEPT CANTILEVERED RETAINING WALLS) SHALL BE ADEQUATELY BRACED AGAINST LATERAL MOVEMENT PRIOR TO BACKFILLING. DESIGN AND ERECTION OF BRACING/SHORING SHALL BE THE RESPONSIBILITY OF THE GENERAL CONTRACTOR. BRACING SHALL REMAIN IN PLACE UNTIL SUPPORTING STRUCTURAL ELEMENTS ARE IN PLACE AND HAVE ATTAINED FULL STRENGTH.
- UNLESS NOTED OTHERWISE, ALL FOOTINGS AT COLUMNS SHALL BE CENTERED BELOW COLUMNS. g. UNLESS NOTED OTHERWISE, ALL FOOTINGS SHALL HAVE VERTICAL FACES FORMED WITH STANDARD FORMING MATERIALS (WOOD, METAL, ETC.). WITH PRIOR APPROVAL OF ARCHITECT AND ENGINEER, CONCRETE FOR FOOTINGS CAN BE PLACED IN EXCAVATED SOIL "FORMS" PROVIDED

E. CONCRETE

- 1. ALL CONCRETE MIX DESIGNS SHALL COMPLY WITH THE PROJECT SPECIFICATIONS AND THE
- REQUIREMENTS LISTED BELOW:
- a. FOOTINGS, GRADE BEAMS, FOUNDATION WALLS: WHERE THE TOP OF THE ELEMENT IS EXPOSED OR IS LOCATED WITHIN 24" OF THE LOWEST
- ADJACENT GRADE (EXPOSURE CATEGORY F2): a. 28 DAY COMPRESSIVE STRENGTH: 4500 PSI MAXIMUM W/C RATIO:

THAT THE DIMENSIONS ARE INCREASED 3" ON ALL SIDE.

- MAXIMUM AGGREGATE SIZE : d. AIR CONTENT:
- SEE SCHEDULE BELOW WHERE THE TOP OF THE ELEMENT IS NOT EXPOSED OR IS NOT LOCATED WITHIN 24" OF THE LOWEST ADJACENT GRADE (EXPOSURE CATEGORY F0)
- a. 28 DAY COMPRESSIVE STRENGTH: 3000 PSI RETAINING WALLS (EXPOSURE CATEGORY F2):
- 28 DAY COMPRESSIVE STRENGTH: 4500 PSI
- MAXIMUM W/C RATIO: MAXIMUM AGGREGATE SIZE : SET SCHEDULE BELOW
- AIR CONTENT:
- c. INTERIOR SLABS ON GRADE (EXPOSITE CATEGORY 70): 1. 28 DAY COMPRESSIVE STRENGT : 4000 PSI d. INTERIOR SUSPENDED SLABS (EXPOSURE CATEGORY F0)
- 28 DAY COMPRESSIVE STRENGTH 3500 PS e. EXTERIOR SLABS (DOCKS, ETC.) (EXPOSURE CATEGORY F2):
- 28 DAY COMPRESSIVE STRENGTH: 4500 PSI MAXIMUM W/C RATIO:
- MAXIMUM AGGREGATE SIZE 4. MINIMUM AIR CONTENT: SEE SCHEDULE BELOW TOTAL AIR CONTENT FOR CONCRETE EXPOSED TO CYCLES OF FREEZING AND THAWING SHALL BE DETERMINED IN ACCORDANCE WITH THIS SCHEDULE. TOLERANCE ON AIR CONTENT AS

DELIVERED SHALL BE +/- 1.9	5 PERCENT.	
NOMINAL MAXIMUM	TARGET AIR	CONTENT, PERCENT
AGGREGATE SIZE, IN.	F1	F2 AND F3
3/8	6	7.5
1/2	5.5	7
3/4	5	6
1	4.5	6
1-1/2	4.5	5.5
2	4	E

- WATER USED IN MIXING CONCRETE SHALL CONFORM TO ASTM C1602.
- NO PIPES, DUCTS, SLEEVES, ETC. SHALL BE PLACED IN STRUCTURAL CONCRETE UNLESS SPECIFICALLY DETAILED OR APPROVED BY THE STRUCTURAL ENGINEER. NO ALUMINUM PRODUCTS SHALL BE EMBEDDED IN CONCRETE. PENETRATIONS THRU STRUCTURAL CONCRETE ELEMENTS MUST BE APPROVED BY THE ENGINEER AND SHALL BE BUILT INTO THE ELEMENT PRIOR TO CONCRETE
- REFER TO ARCHITECTURAL DRAWINGS FOR MOLDS, GROOVES, ORNAMENTS, ETC. TO BE CAST IN TO CONCRETE, AND FOR EXTENT AND LOCATION OF DEPRESSIONS, CURBS, RAMPS, ETC.
- 5. UNLESS NOTED OTHERWISE, MINIMUM REINFORCING IN ALL CONCRETE FOUNDATION WALLS SHALL BE

	IUP &		
THICKNESS	BOTTOM BARS	VERTICAL	HORIZONTAL
6"	(1) #5	#4 AT 18"O.C.	#4 AT 16"O.C.
7 1/2"	(2) #5	#4 AT 18"O.C.	#4 AT 12"O.C.
8"	(2) #5	#4 AT 18"O.C.	#4 AT 12"O.C.
8 1/2"	(2) #5	#4 AT 18"O.C.	#4 AT 12"O.C.
10"	(2) #5	#4 AT 12"O.C.	#5 AT 12"O.C.
12"	(2) #5	#4 AT 18"O.C. EA FACE	#4 AT 16"O.C. EA FACE
UNLESS NOTED	OTHERWISE, CON	CRETE SLABS ON EARTH SHA	ALL BE REINFORCED AS FOLLOV
4" THICK - #	3 AT 18"O.C. EACH V	VAY	

- 6" THICK #4 AT 16"O.C. EACH WAY REINFORCING SHALL BE CONTINUOUSLY SUPPORTED AT 36"O.C. MAXIMUM SPACING. UNLESS NOTED OTHERWISE. FOR NON-DETAILED OPENINGS IN CONCRETE WALLS LARGER THAN 12" AND SMALLER THAN 24" IN ANY DIRECTION ADD (2) #5 BARS ON ALL SIDES IN ADDITION TO REGULAR WALL REINFORCING AND EXTEND 24" EACH WAY BEYOND OPENING. IF 24" IS NOT AVAILABLE ON EVERY SIDE, NOTIFY STRUCTURAL ENGINEER FOR FURTHER DIRECTION. OPENINGS SHALL HAVE A MINIMUM
- OF 12" OF CONCRETE ABOVE THE OPENING, TYP. CONSTRUCTION JOINTS NOT SHOWN ON THE PLANS SHALL BE MADE AND LOCATED SO AS TO NOT IMPAIR THE STRENGTH OF THE STRUCTURE AND AS APPROVED BY THE STRUCTURAL ENGINEER. PROVIDE 2 X 4 (SHAPED) KEYWAY IN ALL VERTICAL AND HORIZONTAL JOINTS UNLESS NOTED OR DETAILED OTHERWISE. ALL STEEL REINFORCING SHALL BE CONTINUOUS THROUGH COLD JOINTS UNLESS NOTED OTHERWISE. SEE TYPICAL DETAILS FOR COLD/CONSTRUCTION JOINTS FOR SLABS ON
- WHERE NEW CONCRETE IS PLACED AGAINST PREVIOUSLY HARDENED CONCRETE, THE JOINT SHALL BE CLEAN AND FREE OF LAITANCE. IMMEDIATELY BEFORE NEW CONCRETE IS PLACED, CONSTRUCTION JOINTS SHALL BE PREWETTED AND STANDING WATER REMOVED. WHERE NOTED IN SPECIFIC DETAILS. HARDENED CONCRETE SHALL BE ROUGHENED TO 1/4" AMPLITUDE AND A BONDING AGENT SHALL BE APPLIED TO THE JOINT PRIOR TO PLACING NEW CONCRETE.

F. ANCHOR BOLTS/EMBEDDED BOLTS

- 1. ALL ANCHOR BOLTS SHALL HAVE ASTM A-563 HEAVY HEX NUT AND ASTM F-436 WASHERS AT STANDARD OR OVERSIZED HOLES PER AISC SPECIFICATION TABLE J3.3. WHERE HOLE SIZES DO NOT COMPLY WITH THE LIMITATIONS FOR OVERSIZED HOLES THE STRUCTURAL ENGINEER SHALL BE NOTIFIED TO DETERMINE STEEL PLATE WASHER REQUIREMENTS. ANCHOR BOLTS SHALL COMPLY WITH THE FOLLOWING:
- a. AT BRACED FRAMES ASTM F1554 GRADE 105 HEADED BOLTS.(ASTM A449 THREADED ROD MAY BE USED WITH DOUBLE NUT AND WASHER.) b. AT WOOD STUD WALLS - ASTM A-307 GRADE HEADED BOLTS. ANCHOR BOLTS IN TREATED LUMBER
- SHALL BE GALVANIZED OR STAINLESS STEEL. SEE TIMBER NOTES FOR MORE INFORMATION. c. AT ALL OTHER ANCHOR BOLTS (UNLESS NOTED OTHERWISE) - ASTM F1554 GRADE 36 HEADED BOLTS. (ASTM A36 THREADED ROD MAY BE USED WITH DOUBLE NUT AND WASHER.)

4. FURNISH TEMPLATES AND OTHER DEVICES AS NECESSARY FOR PRESETTING ALL BOLTS PRIOR TO

- 2. EMBEDDED BOLTS IN MASONRY SHALL BE (UNLESS NOTED OTHERWISE) ASTM A-307 GRADE HEADED 3. SEE TYPICAL ANCHOR BOLT DETAIL FOR DEFINITIONS OF EMBEDMENT LENGTH, ETC.
- PLACING CONCRETE AND/OR GROUT. 5. IF THREADED RODS ARE USED AS PERMITTED ABOVE, THEY SHALL BE CLEAR OF SOIL AND DIRT. 6. WHERE REQUIRED FOR ERECTION, HOLES LARGER THAN OVERSIZED MAY BE PERMITTED WITH THE USE OF STEEL PLATE WASHERS AT THE DISCRETION OF THE STRUCTURAL ENGINEER.

G. ADHESIVE/MECHANICAL ANCHORS

- WITHOUT WRITTEN APPROVAL OF THE ENGINEER, CONTRACTOR SHALL NOT SUBSTITUTE POST-INSTALLED ANCHORS WHERE CAST-IN-PLACE ANCHORS ARE SPECIFIED IN THE DRAWINGS.
- 2. WHERE STRUCTURAL DETAILS SPECIFY SPECIFIC BRANDS AND/OR TYPES OF ADHESIVES OR ANCHORS, SUBSTITUTIONS OF OTHER BRANDS AND/OR TYPES IS NOT ALLOWED, WITHOUT WRITTEN
- APPROVAL OF THE ENGINEER. 3. SUBSTITUTION REQUESTS FOR ALTERNATE PRODUCTS SHALL BE APPROVED IN WRITING BY THE STRUCTURAL ENGINEER OF RECORD PRIOR TO USE. SUBSTITUTION REQUESTS SHALL INCLUDE AN ICC ESR OR IAPMO REPORT AND SUPPORTING CALCULATIONS INDICATING COMPLIANCE WITH DESIGN
- 4. ALL ADHESIVE/MECHANICAL ANCHORS SHALL BE INSTALLED, INCLUDING HOLE DRILLING AND
- PREPARATION, IN ACCORDANCE WITH AN APPROVED INDEPENDENT EVALUATION REPORT (ICC-ES, IAPMO, OR APPROVED EQUAL), AS INDICATED BELOW, AND IN ACCORDANCE WITH ALL
- MANUFACTURER'S PRINTED INSTALLATION INSTRUCTIONS (MPII). 5. INSTALLERS SHALL BE, AT A MINIMUM, TRAINED FOR THE SPECIFIC APPLICATION INSTALLATION TECHNIQUE FOR THE SPECIFIC PRODUCT BY THE PRODUCT MANUFACTURERS FIELD EMPLOYEE OR
- SHALL POSSESS A TRAINING CARD OBTAINED BY THE MANUFACTURERS ONLINE TRAINING PROGRAM. ADHESIVE ANCHORS SHALL BE INSTALLED IN CONCRETE HAVING A MINIMUM AGE OF 21 DAYS AT TIME OF ANCHOR INSTALLATION. ADHESIVE ANCHORS SHALL NOT BE FULLY LOADED UNTIL CONCRETE HAS REACHED DESIGN STRENGTH
- 7. ADHESIVE ANCHORS SHALL CONSIST OF REINFORCING BAR OR THREADED RODS AS INDICATED IN
- THESE DOCUMENTS 8. UNLESS APPROVED BY THE ENGINEER OF RECORD, CONCRETE AND DRILLED ANCHOR HOLES SHALL BE DRY AND FREE OF WATER FOR 14 DAYS PRIOR TO ADHESIVE INSTALLATION. CONTACT THE ENGINEER OF RECORD FOR GUIDANCE IF THE CONTRACTOR CHOOSES TO INSTALL IN DAMP, WATER-
- SATURATED, OR WATER-FILLED HOLES. 9. CONCRETE TEMPERATURE AT THE TIME OF INSTALLATION SHALL BE MONITORED BY THE CONTRACTOR. CONTRACTOR SHALL COMPLY WITH ALL MANUFACTURER'S PRINTED INSTALLATION INSTRUCTIONS (MPII) RELATIVE TO SUBSTRATE TEMPERATURE
- 10. INSTALLATION OF ADHESIVE ANCHORS HORIZONTALLY OR UPWARDLY INCLINED TO SUPPORT SUSTAINED TENSION LOADS SHALL BE PERFORMED BY PERSONNEL CERTIFIED BY AN APPLICABLE CERTIFICATION PROGRAM. CERTIFICATION SHALL INCLUDE WRITTEN AND PERFORMANCE TESTS IN ACCORDANCE WITH THE ACI/CRSI ADHESIVE ANCHOR INSTALLER CERTIFICATION PROGRAM, OR EQUIVALENT IN ACCORDANCE WITH ACI 318-11 D.9.2.2. PROOF OF CURRENT CERTIFICATION SHALL BE SUBMITTED TO THE ENGINEER FOR APPROVAL PRIOR TO INSTALLATION. CONTINUOUS SPECIAL
- INSPECTION SHALL BE PROVIDED FOR THESE ANCHORS. 11. UNLESS NOTED OTHERWISE, ALL ADHESIVE ANCHORS INTO CONCRETE SHALL BE: a. HILTI HIT-RE 500V3 (ESR-3814), OR HILTI HIT-HY 200-A (ESR-3187).
- b. SIMPSON SET-3G (ESR-4057), OR AT-XP (ER-0263).
- c. DEWALT PURE 110+ (ESR-3298), OR AC200+ GOLD (ESR-4027-COLD WEATHER). 12. UNLESS NOTED OTHERWISE, ALL ADHESIVE ANCHORS INTO GROUTED MASONRY (CMU) SHALL BE:
- a. HILTI HIT-HY 270 (ESR-4143). b. SIMPSON SET-XP (ER-0265), OR AT-XP (ER-0281).
- c. DEWALT AC100+ GOLD (ESR-3200) 13. UNLESS NOTED OTHER WISE, ALL MECHANICAL ANCHORS INTO CONCRETE SHALL BE:
- a. HILTI KWIK BOLT-TZ2 (ESR-4266). b. SIMPSON STRONG-BOLT 2 (ESR-3037).
- 14. UNLESS NOTED OTHERWISE, ALL MECHANICAL ANCHORS INTO GROUTED MASONRY (CMU) SHALL BE: a. HILTI KWIK BOLT-TZ2 (ESR-4561).
- b. SIMPSON STRONG BOLT 2 WEDGE ANCHOR (ER-0240).
- c. DEWALT SCREWBOLT+ (ESR-4042). 15. UNLESS NOTED OTHERWISE, ALL SCREW ANCHORS INTO CONCRETE SHALL BE:
- a. SIMPSON TITEN HD (ESR-2713). b. DEWALT SCREWBOLT+ (ESR-3889).
- HILTI KWIK HUS-EZ (ESR-3027).
- UNLESS NOTED OTHERWISE, ALL SCREW ANCHORS INTO GROUTED MASONRY (CMU) SHALL BE a. SIMPSON TITEN HD (ESR-1056).
- b. DEWALT SCREWBOLT+ (ESR-1678). c. HILTI KWIK HUS EZ (ESR-3056).
- 17. ALL MASONRY CELLS WITHIN 8" OF THE ANCHOR SHALL BE SOLID GROUTED 18. THE TESTING LABORATORY WILL PERFORM VISUAL INSPECTION OF ANCHORS AND DOWELS AS SPECIFIED IN THE SPECIAL INSPECTION SCHEDULE AND THE APPROVED INDEPENDENT EVALUATION REPORT. TENSION TESTING CAN BE REQUIRED AT THE DIRECTION OF THE STRUCTURAL ENGINEER OF
- RECORD OR THE SPECIAL INSPECTOR. 19. IF REINFORCEMENT IS ENCOUNTERED DURING DRILLING, ABANDON THAT HOLE AND SHIFT THE ANCHOR LOCATION TO AVOID THE REINFORCEMENT. PROVIDE A MINIMUM SPACE OF (2) ANCHOR HOLE DIAMETERS OR 2 INCHES, WHICH EVER IS LARGER, OF SOUND CONCRETE/MASONRY BETWEEN THE ANCHOR AND THE ABANDONED HOLE. FILL THE ABANDONED HOLE WITH NON-SHRINK GROUT OR AN APPROVED ANCHORING ADHESIVE. AT CONTRACTORS OPTION, LOCATE EXISTING REINFORCEMENT PRIOR TO DRILLING/CORING. IF THE ANCHOR OR DOWEL CANNOT BE SHIFTED AS NOTED ABOVE, THE
- ENGINEER WILL DETERMINE A NEW LOCATION. 20. LOCATE REINFORCEMENT AND CONFIRM FINAL ANCHOR LOCATIONS PRIOR TO FABRICATING PLATES, MEMBERS, OR OTHER STEEL ASSEMBLIES ATTACHED WITH MECHANICAL ANCHORS.

H. SUSPENDED CONCRETE SLABS / SLABS ON METAL DECK

- 1. UNLESS NOTED OTHERWISE, ALL CONCRETE SLABS ON METAL DECK SHALL BE 6 1/4" TOTAL THICKNESS LIGHT WEIGHT CONCRETE WITH A WEIGHT LESS THAN 110 POUNDS PER CUBIC FOOT REINFORCED WITH PER DETAIL 7/S202. REINFORCING STEEL SHALL BE CHAIRED TO 1" TOP COVER AT ALL BEAM LOCATIONS. EXCEPT WHERE SPECIFICALLY DETAILED, FIBER MESH MAY BE USED IN PLACE OF REINFORCEMENT IN SLABS ON DECK WHEN USED IN ACCORDANCE WITH AN APPROVED ICC RESEARCH REPORT AND WHERE APPROVED BY THE ENGINEER. WHERE THE SLAB CONSTRUCTION IS USED TO OBTAIN A UL FIRE RATING, THE PROPOSED FIBER MESH SHALL HAVE UL ACCEPTANCE AS AN APPROVED ALTERNATIVE TO WELDED WIRE FABRIC.
- 2. AROUND OPENINGS IN SUSPENDED CONCRETE SLABS, ADD REINFORCING BARS EQUIVALENT TO BARS CUT BY OPENING WITH HALF ON EACH SIDE OF OPENING. BARS PARALLEL TO PRINCIPAL REINFORCING SHALL RUN FULL LENGTH OF SPAN. BARS PARALLEL TO TEMPERATURE REINFORCING SHALL RUN 24" BEYOND OPENING.
- 3. SLAB PENETRATIONS LESS THAN 6" IN ALL DIRECTIONS WITH A CLEAR SPACING OF AT LEAST 3 TIMES THE LONGEST DIMENSION, DO NOT REQUIRE SUPPLEMENTAL REINFORCING. OTHERWISE, THE PENETRATIONS SHALL BE FRAMED ON 4 SIDES WITH STEEL ANGLES OR BENT PLATES (SEE TYPICAL DETAIL) UNLESS NOTED OTHERWISE.
- 4. EVERY EFFORT SHALL BE MADE TO PROVIDE A CONSISTENT FINISHED FLOOR THICKNESS.
- 5. CONTROL JOINTS IN SUSPENDED CONCRETE SLABS AND CONCRETE SLABS ON DECK SHALL NOT BE USED UNLESS SPECIFICALLY APPROVED AND DETAILED BY THE ENGINEER.
- 6. SEE TYPICAL DETAILS WHEN SLABS ARE MADE COMPOSITE WITH STEEL BEAMS 7. ANY CONDUIT PLACED IN SLABS ON DECK SHALL BE SPACED NOT CLOSER THAN 18"O.C. CONDUIT LARGER THAN 3/4" DIAMETER SHALL BE PLACED IN DECK FLUTES, BUT MAY NOT BE PLACED IN FLUTES WITH REINFORCING STEEL OR HSA'S. A 1" MINIMUM CLEARANCE SHALL BE MAINTAINED BETWEEN THE CONDUIT AND THE DECK. NO CONDUIT LARGER THAN 1" DIAMETER OR 1/3 THE THICKNESS OF THE CONCRETE OVER THE DECK FLUTE SHALL BE PLACED IN SLABS ON DECK. CONDUIT CROSSOVERS ARE NOT ALLOWED.

I. REINFORCING STEEL

- 1. REINFORCING BAR STRENGTH REQUIREMENTS: a. ALL REINFORCING BARS UNO, SHALL CONFORM TO ASTM STANDARD A-615 GRADE 60 AND ALL WELDED WIRE FABRIC SHALL CONFORM TO ASTM STANDARD A-1064 AND SHALL BE SUPPLIED IN
- FLAT SHEETS. ADEQUATELY TIE AND SUPPORT ALL REINFORCING STEEL AS SPECIFIED BY ACI 117,
- TO MAINTAIN EXACT REQUIRED POSITION.
- 2. HEADED SHEAR STUD ASSEMBLIES SHALL CONFORM TO ASTM A1044. 3. STEEL DISCONTINUOUS FIBER REINFORCEMENT SHALL BE DEFORMED AND CONFORM TO ASTM A820 AND SHALL HAVE A LENGTH TO DIAMETER RATIO NOT SMALLER THAN 50 AND NOT GREATER THAN 100.
- THE BAR DEFORMATIONS, IF ANY, SHALL NOT EXTEND MORE THAN 2 BAR DIAMETERS FROM THE BEARING FACE OF THE HEAD.

4. HEADED DEFORMED BARS SHALL CONFORM TO ASTM A970. OBSTRUCTIONS OR INTERRUPTIONS OF

- 5. ALL REINFORCING STEEL SHALL BE TIED IN PLACE AND ADEQUATELY SUPPORTED PRIOR TO PLACING CONCRETE. WET STABBING OF ANY REINFORCING STEEL IS NOT PERMITTED, UNLESS SPECIFICALLY
- DETAILED OTHERWISE OR APPROVED BY THE ENGINEER.
- 6. ALL FIELD BENT DOWELS SHALL BE GRADE 40 WITH SPACING INDICATED REDUCED BY 1/3. 7. UNLESS NOTED OTHERWISE, REINFORCEMENT SHALL HAVE THE FOLLOWING CONCRETE COVERAGE
- a. CAST AGAINST AND PERMANENTLY EXPOSED TO EARTH 3" b. EXPOSED TO EARTH OR WEATHER:
- #6 & LARGER 2" #5 & SMALLER1-1/2"
- c. NOT EXPOSED TO WEATHER OR EARTH
- SLABS, WALLS, JOISTS, #11 & SMALLER 3/4" BEAMS, COLUMNS: MAIN REINFORCING OR TIES 1-1/2"
- d. SLAB ON GRADE: 1. PLACE REINFORCING AT CENTER OF SLAB UNLESS INDICATED OTHERWISE.
- EXCEPT WHERE NOTED ON PLANS OR DETAILS CONTINUOUS REINFORCEMENT SHALL BE SPLICED AT POINTS OF MINIMUM STRESS BY LAPPING PER THE REBAR LAP SCHEDULE. 9. REINFORCING STEEL MAY BE SPLICED WITH MECHANICAL COUPLERS THAT HAVE A TENSION CAPACITY OF AT LEAST 125% OF THE STRENGTH OF THE BAR. MECHANICAL COUPLERS SHALL BE A POSITIVE
- RESEARCH REPORT. WHERE THESE ARE USED, SPLICES ON ADJACENT BARS SHALL BE STAGGERED AT LEAST 24 INCHES ALONG THE LENGTH OF THE BARS. 10. ALL VERTICAL REINFORCING IN STRUCTURAL ELEMENTS ABOVE SHALL BE SPLICED WITH MATCHING DOWELS EMBEDDED WITHIN THE FOOTINGS OR STRUCTURE BELOW. SPLICE LENGTHS SHALL COMPLY WITH REBAR LAP SCHEDULE. DOWELS INTO FOOTINGS SHALL TERMINATE WITH A STANDARD HOOK,

CONNECTING TYPE COUPLER, AND SHALL BE INSTALLED IN ACCORDANCE WITH AN APPROVED ICC

- AND SHALL EXTEND TO WITHIN 4" OF THE BOTTOM OF THE FOOTING, BUT NEED NOT EXTEND MORE THAN 20" INTO FOOTING. FOR MASONRY CONSTRUCTION SEE STRUCTURAL NOTE N.6.A.
- 11. DO NOT WELD REINFORCING EXCEPT AS NOTED ON PLANS, WHERE REINFORCING IS WELDED, USE ASTM A-706 REINFORCING. 12. REINFORCING BARS, TIES, AND TENDONS SHALL BE SUPPORTED BY NYLON CONES, PLASTIC-COATED
- TIE-WIRES, OR PLASTIC-COATED CHAIRS. REINFORCING IN FOOTINGS IS PERMITTED TO BE SUPPORTED 13. UNLESS NOTED OTHERWISE, HOOKS, STIRRUPS, TIES, AND OTHER BENDS IN REINFORCING STEEL SHALL MEET THE STANDARDS SET FORTH IN ACI 318/318R-14. UNLESS OTHERWISE PERMITTED BY THE ENGINEER, ALL REINFORCEMENT SHALL BE BENT COLD. REINFORCEMENT PARTIALLY EMBEDDED IN CONCRETE SHALL NOT BE FIELD BENT, EXCEPT AS SHOWN ON THESE DRAWINGS OR OTHERWISE
- PERMITTED BY THE ENGINEER. 14. UNLESS SPECIFICALLY NOTED AND/OR DETAILED IN THE STRUCTURAL DRAWINGS CONDUIT SHALL NOT BE IN CONTACT WITH REINFORCING STEEL.

Structural Sheet Index

SHEET NAME

STRUCTURAL NOTES CONTINUED ON S002

SHEET

NUMBER

S002

S003

S004

S005

S006

S007

S101A

S101B

S102

S103

S104

S105

S202

S203

S204

S221 S230

S302

STRUCTURAL NOTES

STRUCTURAL NOTES

SCHEDULES

SCHEDULES

STRUCTURAL NOTES & SCHEDULES

FOOTING AND FOUNDATION PLAN

SECOND LEVEL FRAMING PLAN

FOURTH FLOOR FRAMING PLAN

TYPICAL FOUNDATION DETAILS

TYPICAL FRAMING DETAILS FOUNDATION DETAILS FOUNDATION DETAILS

FLOOR FRAMING DETAILS FLOOR FRAMING DETAILS ROOF FRAMING DETAILS BRACED FRAME ELEVATIONS

CANOPY DETAILS

SCHEMATIC REFERENCE

ELEVATIONS

ANCHOR TIEDOWN SYSTEM DETAILS

CONCRETE/STEEL FRAMING DETAILS CONCRETE/STEEL FRAMING DETAILS

THIRD FLOOR FRAMING PLAN

ROOF FRAMING PLAN

TYPICAL DETAILS

SHEAR WALL AND TIE-DOWN PLAN







ctur rchite lannin

5 K $\overline{}$ au